

SUBLOT NO. _____
PERMANENT PARCEL NO. _____
STREET ADDRESS _____10360

00 PROPOSED ELEV.

T.B.M. TOP HYD ELV.	979.09
FIRST FLOOR	982.34
GARAGE FLOOR	979.67
BASEMENT FLOOR	972.67
TOP FOOTING	972.34

MUSIY FLOWN PHASE II
CITY OF KIRTLAND COUNTY DEL
PREPARED FOR MR & MRS
DATE APRIL 27, 2004 SCALE

~~ROOF DRAINS
SHALL DISCHARGE
TO SPLASH BEDS~~

Stormwater Management Plan


Approved as shown and/or not

JAMES R. GILLS, P.E.


County Drainage Engineer

By A.S. Date 5/27/04.

Date 5/27/04.

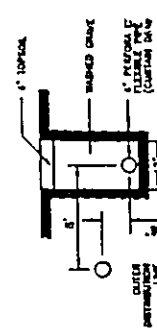

CURTAIN DRAIN CROSS SECTION

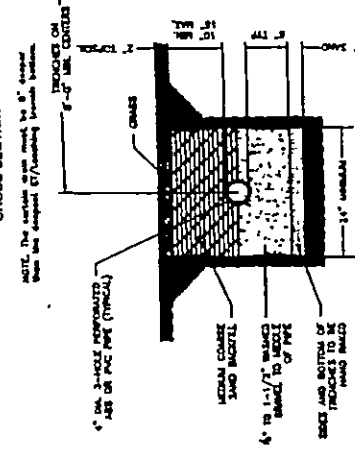EVAPORATION-TRANSPIRATION
* TECHNICAL DETAIL
$$\frac{5}{L^2}$$

RESIDENCE
1ST FLOOR
ELEV. 989.60

REVIEWED AND ACCEPTED
LAKE COUNTY GENERAL
HEALTH DISTRICT

Date 5-17-4 BY 1212

Fulton bed to bed

measured in

SEWAGE DISPOSAL PERMIT MUST BE
OBTAINED BY A LAKE COUNTY LICENSED
INSTALLER BEFORE INSTALLATION. WATER
STARTED

CERTIFICATION.

DISTANCES SHOWN ARE GIVEN IN FEET AND DECIMAL PARTS THEREOF

Pat Salango

PAT SALANGO
6051 CATALANO DRIVE
MAYFIELD HTS, OHIO 4412
440-461-3298

1, THE UNDERSIGNED, DO HEREBY STATE THAT THIS TOPOGRAPHY, INDICATED BY 1 FOOT CONTOURS AND ELEVATIONS SHOWN HEREON REPRESENT AN ACTUAL FIELD SURVEY MADE BY PAT SALANGO ON THE 4-2 DAY OF APRIL 2004 AND THAT THE ELEVATIONS WERE RECHECKED ON 4-14-04 AND THE ELEVATIONS WERE TAKEN AT THE APPROPRIATE INTERVALS AND AS OF THE DATE OF THE SURVEY THEY EXISTED AS INDICATED HEREON.