



SITE PLAN

PAINESVILLE TWP., LAKE COUNTY, OHIO

for: **MAKAMART BUILDERS INC**
CLIENT


ADJACENT STREET CITY ZIP

HEATHERSTONE SUBDIVISION	LOT	TRACT
SUBLOT NO. 10	VOLUME	PAGE
PREPARED BY: HARRY S. JONES, JR.	PERMIT PANEL NO.	STREET

LEGEND	
○	WATER VALVE (GAS)
○	WATER METER (GAS)
○	AS BUILT ELEVATION
○	INDICATES DIRECTION OF SURFACE DRAINAGE
○	100.0

REMARKS
ALL BOUNDARY DATA SHOWN WAS OBTAINED FROM IDEEDS, RECORDED SUBDIVISION PLAT OR OTHER PUBLIC RECORDS.
LOCATIONS AS SHOWN OF ADJACENT WELLS AND SEPTIC TANKS OBTAINED FROM LAKE COUNTY HEALTH DEPARTMENT

DESIGN CERTIFICATION
THIS PLAN WAS PREPARED BY ME, AND IS CORRECT TO THE BEST OF MY KNOWLEDGE AND BELIEF

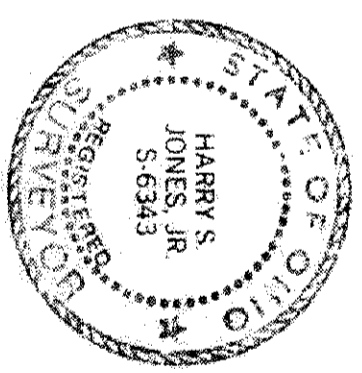

CHECK LIST	
NO. OF BEDROOMS	WATER MAIN SIZE, LOCATION
DIMENSIONS	SEWER SIZE & GR. LOC.
BEARINGS	SAW. MH. CAST ELEV. INV. ELEV.
THE TO NEAREST STREET	SAW. CONN. SIZE LOC. DEPTH
SUBLOT NO. PARCEL NO.	STORM MH. CAST ELEV. INV. ELEV.
SURROUNDING OWNERS	PAV'T TYPE GRADE CURBS
BLDG. DIMENSIONS FIN. GR.	GAS LINE LOC. SIZE PRESSURE
BLDG. THICKNESS FIN. GR.	SEPTIC TANK LOCATION & DUPLICATION AREA
APPROX. TYPE WIDTH THICKNESS	WELL LOCATION
SIPOWALK TYPE WIDTH THICKNESS	ISOLATION RADIIUS FROM WELL
ROCK OUTCROPPINGS	

NO. 1	DATE	BY	REVISIONS
2			
3			
4			
5			

"AS BUILT" CERTIFICATION
I, HEREBY CERTIFY THAT THE CIRCLED GRADES ARE EXISTING FINISH GRADES CHECKED IN THE FIELD ON 19____ AND ARE CORRECT TO THE BEST OF MY KNOWLEDGE AND BELIEF.

REGISTERED SURVEYOR REG. NO. _____

B.M.: E.M. SAN MH S/L 129 & S/L 124, ELEV. = 709.70

Grading Plan Approved
as shown and/or noted
THOMAS P. GILLES, P.E.
Lake County Engineer
Date 7/21/91
PAINESVILLE TOWNSHIP
ZONING APPROVED
188
By: [Signature]
Discharge Sump Pump and
to Storm Sewer and
Swale as shown.
[Signature]
Asst. Zoning Inspector

