

PLAT OF SURVEY

CONCORD TOWNSHIP, LAKE COUNTY, OHIO
 for: JEANNIE RICE
 CLIENT OWNER
 ADDRESS STREET CITY ZIP

SUBDIVISION	NAME	LOT	TRACT
VOL.-PG.		VOLUME -10	PAGE RAVENNA
SUBLOT NO	STREET	PERM PARCEL NO.	STREET

LEGEND

SANITARY MANHOLE --- ○
 STORM MANHOLE --- ●
 INLET OR CATCH BASIN --- □
 HYDRANT --- ⊕
 EXISTING CONTOURS --- - - -
 PROPOSED CONTOURS --- ———

EXIST ELEV 100.0
 100.0 PROP. ELEV
 AS BUILT ELEVATION
 INDICATES DIRECTION OF SURFACE DRAINAGE

REMARKS

ALL BOUNDARY DATA SHOWN WAS OBTAINED FROM (DEEDS, RECORDED SUBDIVISION PLAT OR OTHER PUBLIC RECORDS)
 LOCATIONS AS SHOWN OF ADJACENT WELLS AND SEPTIC TANKS OBTAINED FROM LAKE COUNTY HEALTH DEPARTMENT

DESIGN CERTIFICATION

THIS PLAT WAS PREPARED BY ME, AND IS CORRECT TO THE BEST OF MY KNOWLEDGE AND BELIEF.

Harry S Jones #6343
 NAME SURVEYOR REGISTRATION NO.

CHECK LIST

NO OF BEDROOMS	WATER MAIN SIZE, LOCATION
DIMENSIONS	SAN SEWER SIZE % GR LOC.
BEARINGS	SAN MH CAST, ELEV INV ELEV.
TIE TO NEAREST STREET	SAN CONN SIZE, LOC DEPTH
SUBLOT NO PARCEL NO	STORM SEWER SIZE % GR LOC
SURROUNDING OWNERS	STORM MH, CAST ELEV, INV ELEV
BLDG. DIMENSIONS FIN GR.	PAV'T TYPE GRADE CURVES
BLDG. TILES FL'H. GRADES	GAS LINE LOC. SIZE PRESSURE
APRON TYPE WIDTH THICKNESS	SEPTIC TANK LOCATION & DUPLICATION AREA
SIDEWALK TYPE WIDTH THICKNESS	WELL LOCATION
CULVERT TYPE DIA., LENGTH	ISOLATION RADIUS FROM WELL
ROCK OUTCROPPINGS	



REVISIONS

NO.	DATE	BY	DESCRIPTION
1	12/8/98	TR	
2	1/7/99	HJ	
3	9/22/99	HJ	DRAWN BY TR SCALE 1"=100'
4	9/29/99	HJ	CHK'D. HJ DATE 6/15/98 DRAWING NO. 98-180
5	10/12/99	HJ	CREW CHIEF WB APP'D HJ

PLAN PREPARED BY:
bj BABCOCK JONES & ASSOCIATES, INC.
 PAINESVILLE, OHIO

"AS BUILT" CERTIFICATION
 I, HEREBY CERTIFY THAT THE CIRCLED GRADES ARE EXISTING FINISH GRADES CHECKED IN THE FIELD ON 19, AND ARE CORRECT TO THE BEST OF MY KNOWLEDGE AND BELIEF.

REGISTERED SURVEYOR REG. NO.

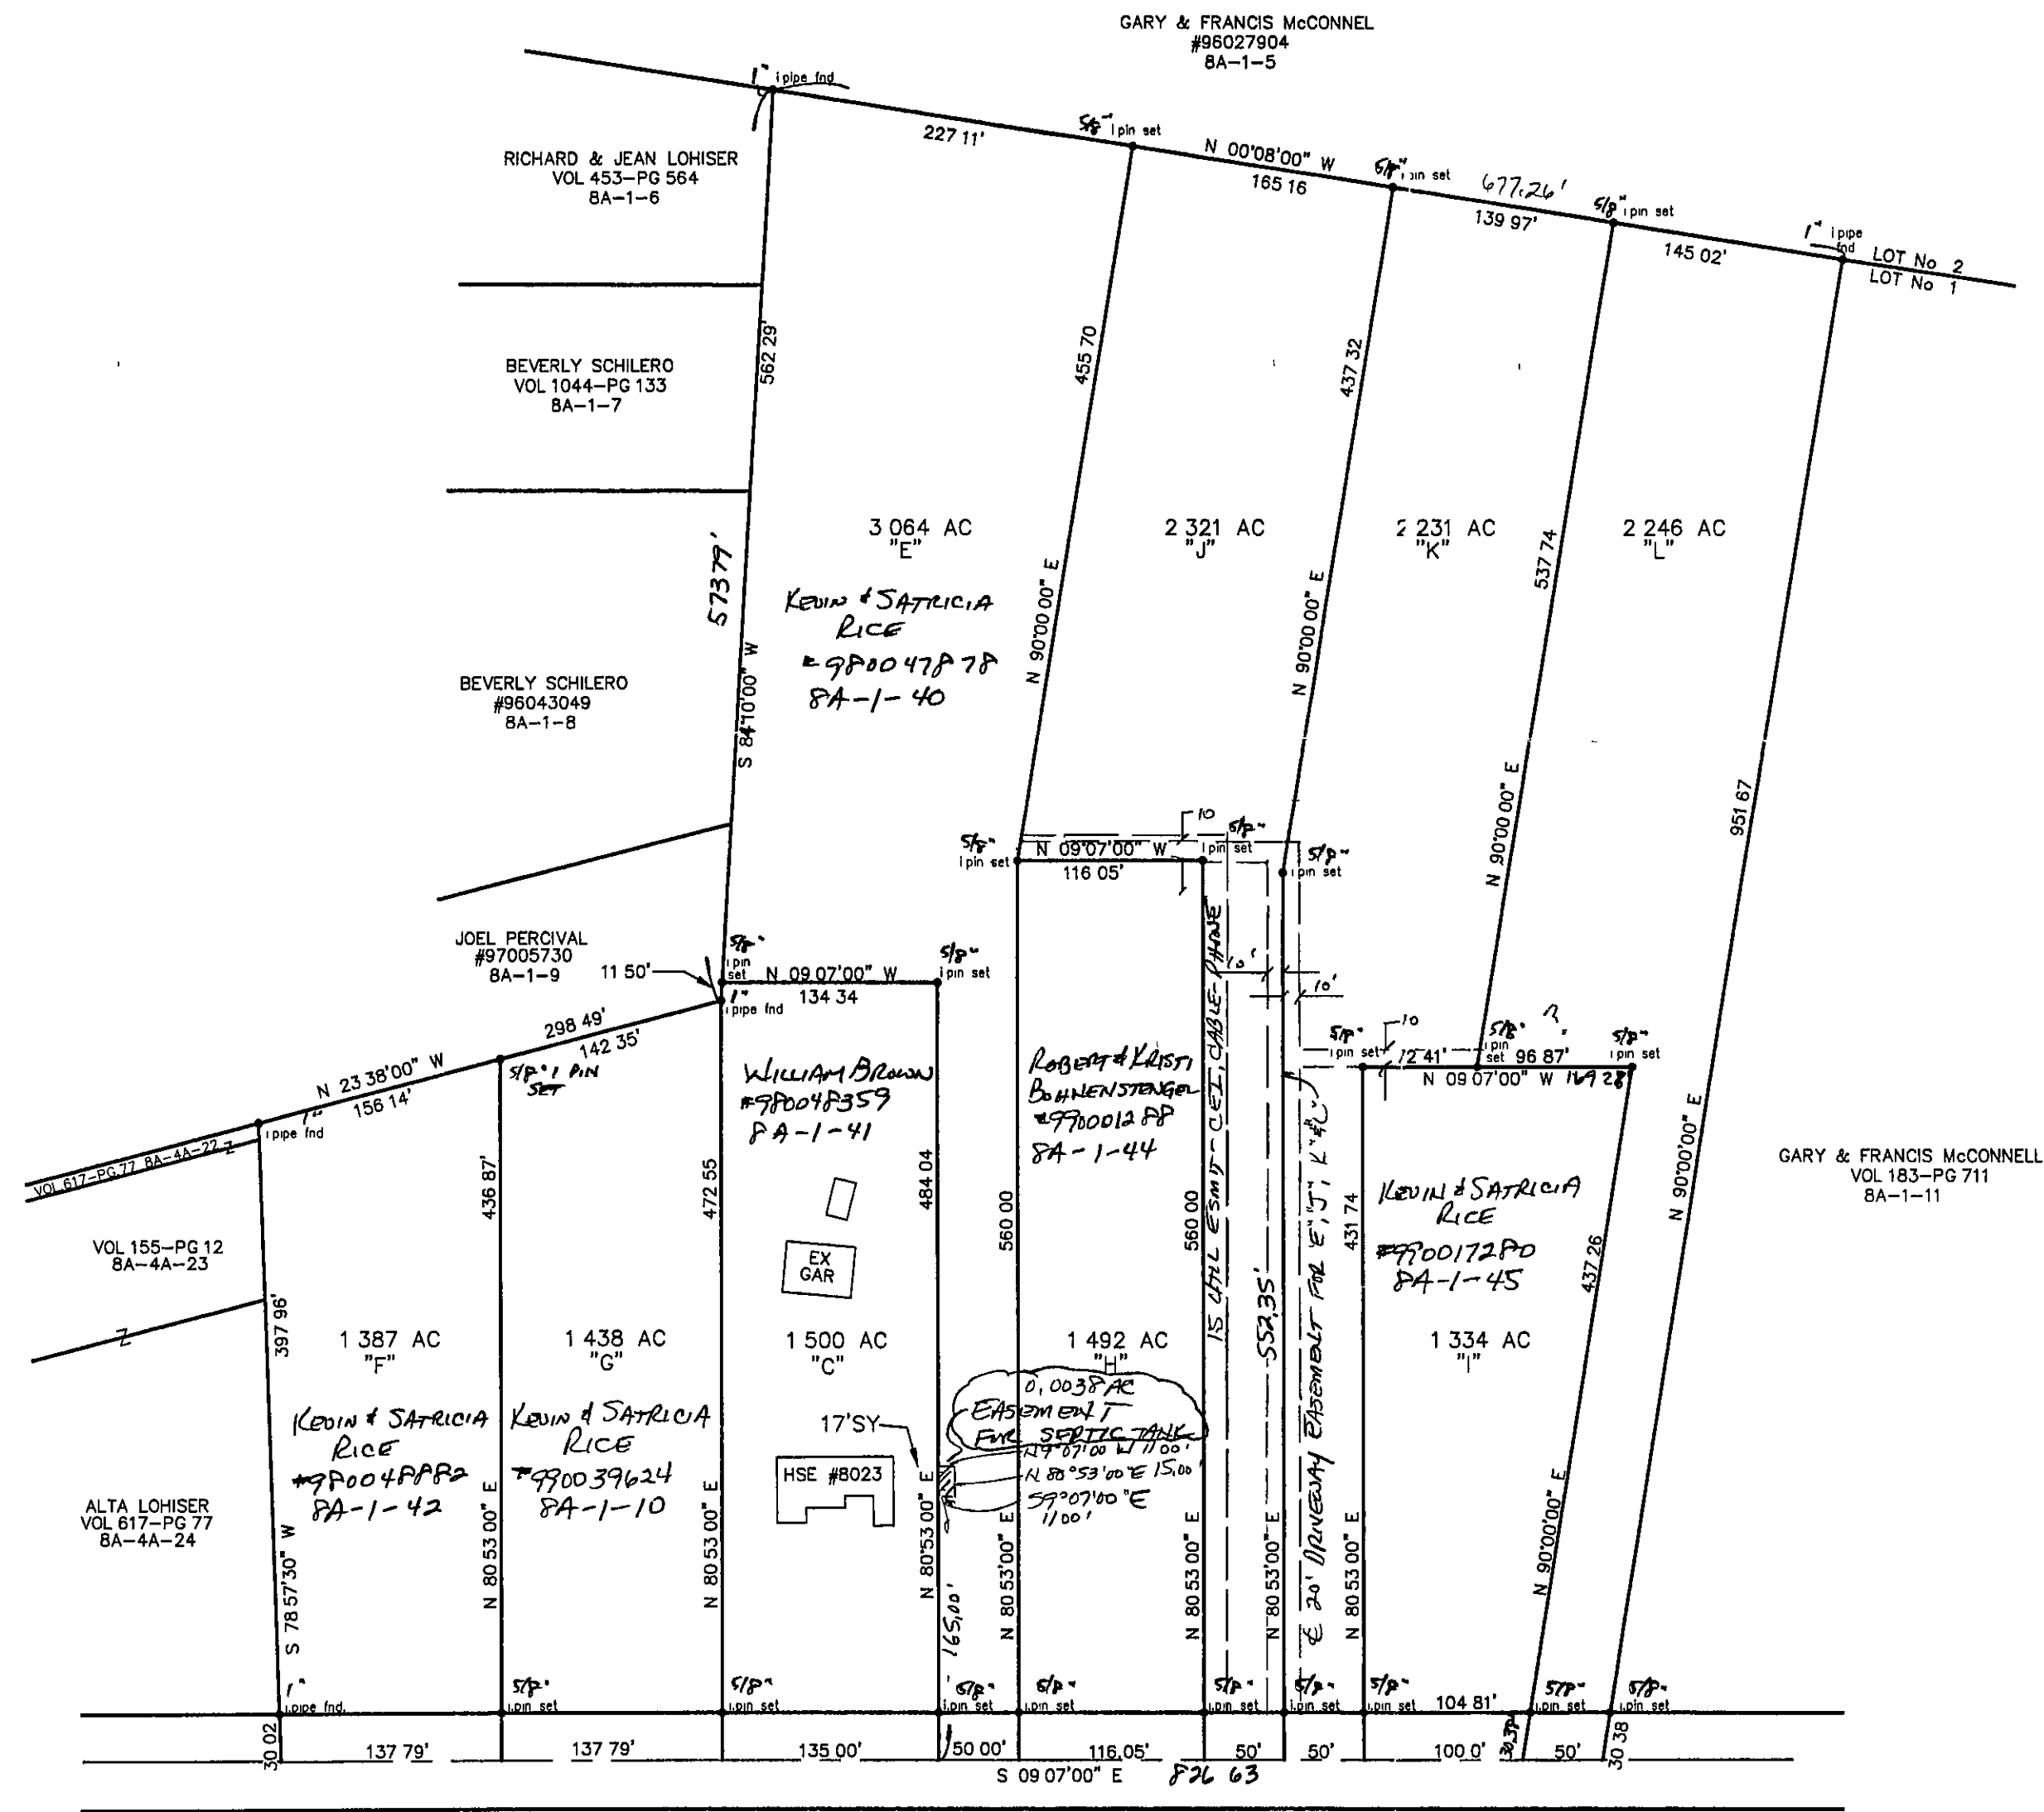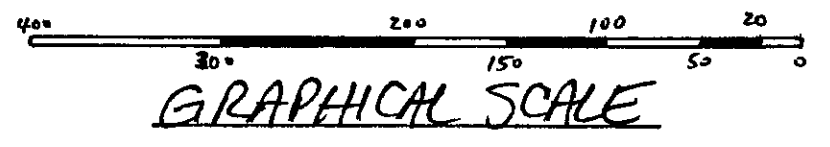

RAVENNA ROAD - 60'

8A-1-40 LOT 1, TR 1 OLD 10/11/01