

PLAT OF SURVEY

CONCORD TOWNSHIP, LAKE COUNTY, OHIO

for: JEANNIE RICE

CLIENT	OWNER
ADDRESS	STREET CITY ZIP
SUBDIVISION	NAME LOT TRACT
VOL-PG	VOLUME PAGE RAVENNA
SUBLOT NO	STREET PERM. PARCEL NO STREET

LEGEND

SANITARY MANHOLE	EXIST. ELEV. \rightarrow 100.0
STORM MANHOLE	100.0 \rightarrow 2 PROP ELEV
INLET OR CATCH BASIN	AS BUILT ELEVATION
HYDRANT	INDICATES DIRECTION OF SURFACE DRAINAGE
EXISTING CONTOURS	
PROPOSED CONTOURS	

REMARKS

ALL BOUNDARY DATA SHOWN WAS OBTAINED FROM (DEEDS, RECORDED SUBDIVISION PLAT OR OTHER PUBLIC RECORDS)
 LOCATIONS AS SHOWN OF ADJACENT WELLS AND SEPTIC TANKS OBTAINED FROM LAKE COUNTY HEALTH DEPARTMENT

DESIGN CERTIFICATION

THIS PLAT WAS PREPARED BY ME, AND IS CORRECT TO THE BEST OF MY KNOWLEDGE AND BELIEF.

NAME Harry S. Jones, Jr. SURVEYOR REGISTRATION NO. 6343



CHECK/LIST

NO OF BEDROOMS	WATER MAIN SIZE, LOCATION
DIMENSIONS	SAN. SEWER SIZE % OR LOC.
BEARINGS	SAN MH CAST ELEV INV. ELEV.
TIE TO NEAREST STREET	SAN CONN SIZE, LOC. DEPTH
SUBLOT NO	STORM SEWER SIZE % OR LOC.
SURROUNDING OWNERS	STORM MH CAST ELEV INV. ELEV.
BLDG. DIMENSIONS FIN GR	PAV'T TYPE GRADE CURBS
BLDG. TIES FL'R GRADES	GAS LINE LOC SIZE PRESSURE
APRON TYPE WIDTH THICKNESS	SEPTIC TANK LOCATION & DUPLICATION AREA
SIDEWALK TYPE WIDTH THICKNESS	WELL LOCATION
CULVERT TYPE DIA., LENGTH	ISOLATION RADIUS FROM WELL
ROCK OUTCROPPINGS	

REVISIONS			PLAN PREPARED BY:	
NO	DATE	BY	Bj BABCOCK · JONES & ASSOCIATES, INC.	
1	12/8/98	TR	PAINESVILLE, OHIO	
2	1/7/99	TR	DRAWN BY	TR
3	9/22/99	TR	SCALE	1"=100'
4	9/29/99	TR	PHONE NO	440-357-1811
5	10/12/99	TR	CHK'D.	HJ
	9/16/01	TR	DATE	6/15/98
	9/26/01	TR	DRAWING NO.	
	10/11/01	TR	CREW	WB
			APP'D	HJ
				98-180

"AS BUILT" CERTIFICATION
 I, HEREBY CERTIFY THAT THE CIRCLED GRADES ARE EXISTING FINISH GRADES CHECKED IN THE FIELD ON _____, 19____ AND ARE CORRECT TO THE BEST OF MY KNOWLEDGE AND BELIEF.

REGISTERED SURVEYOR REG. NO.

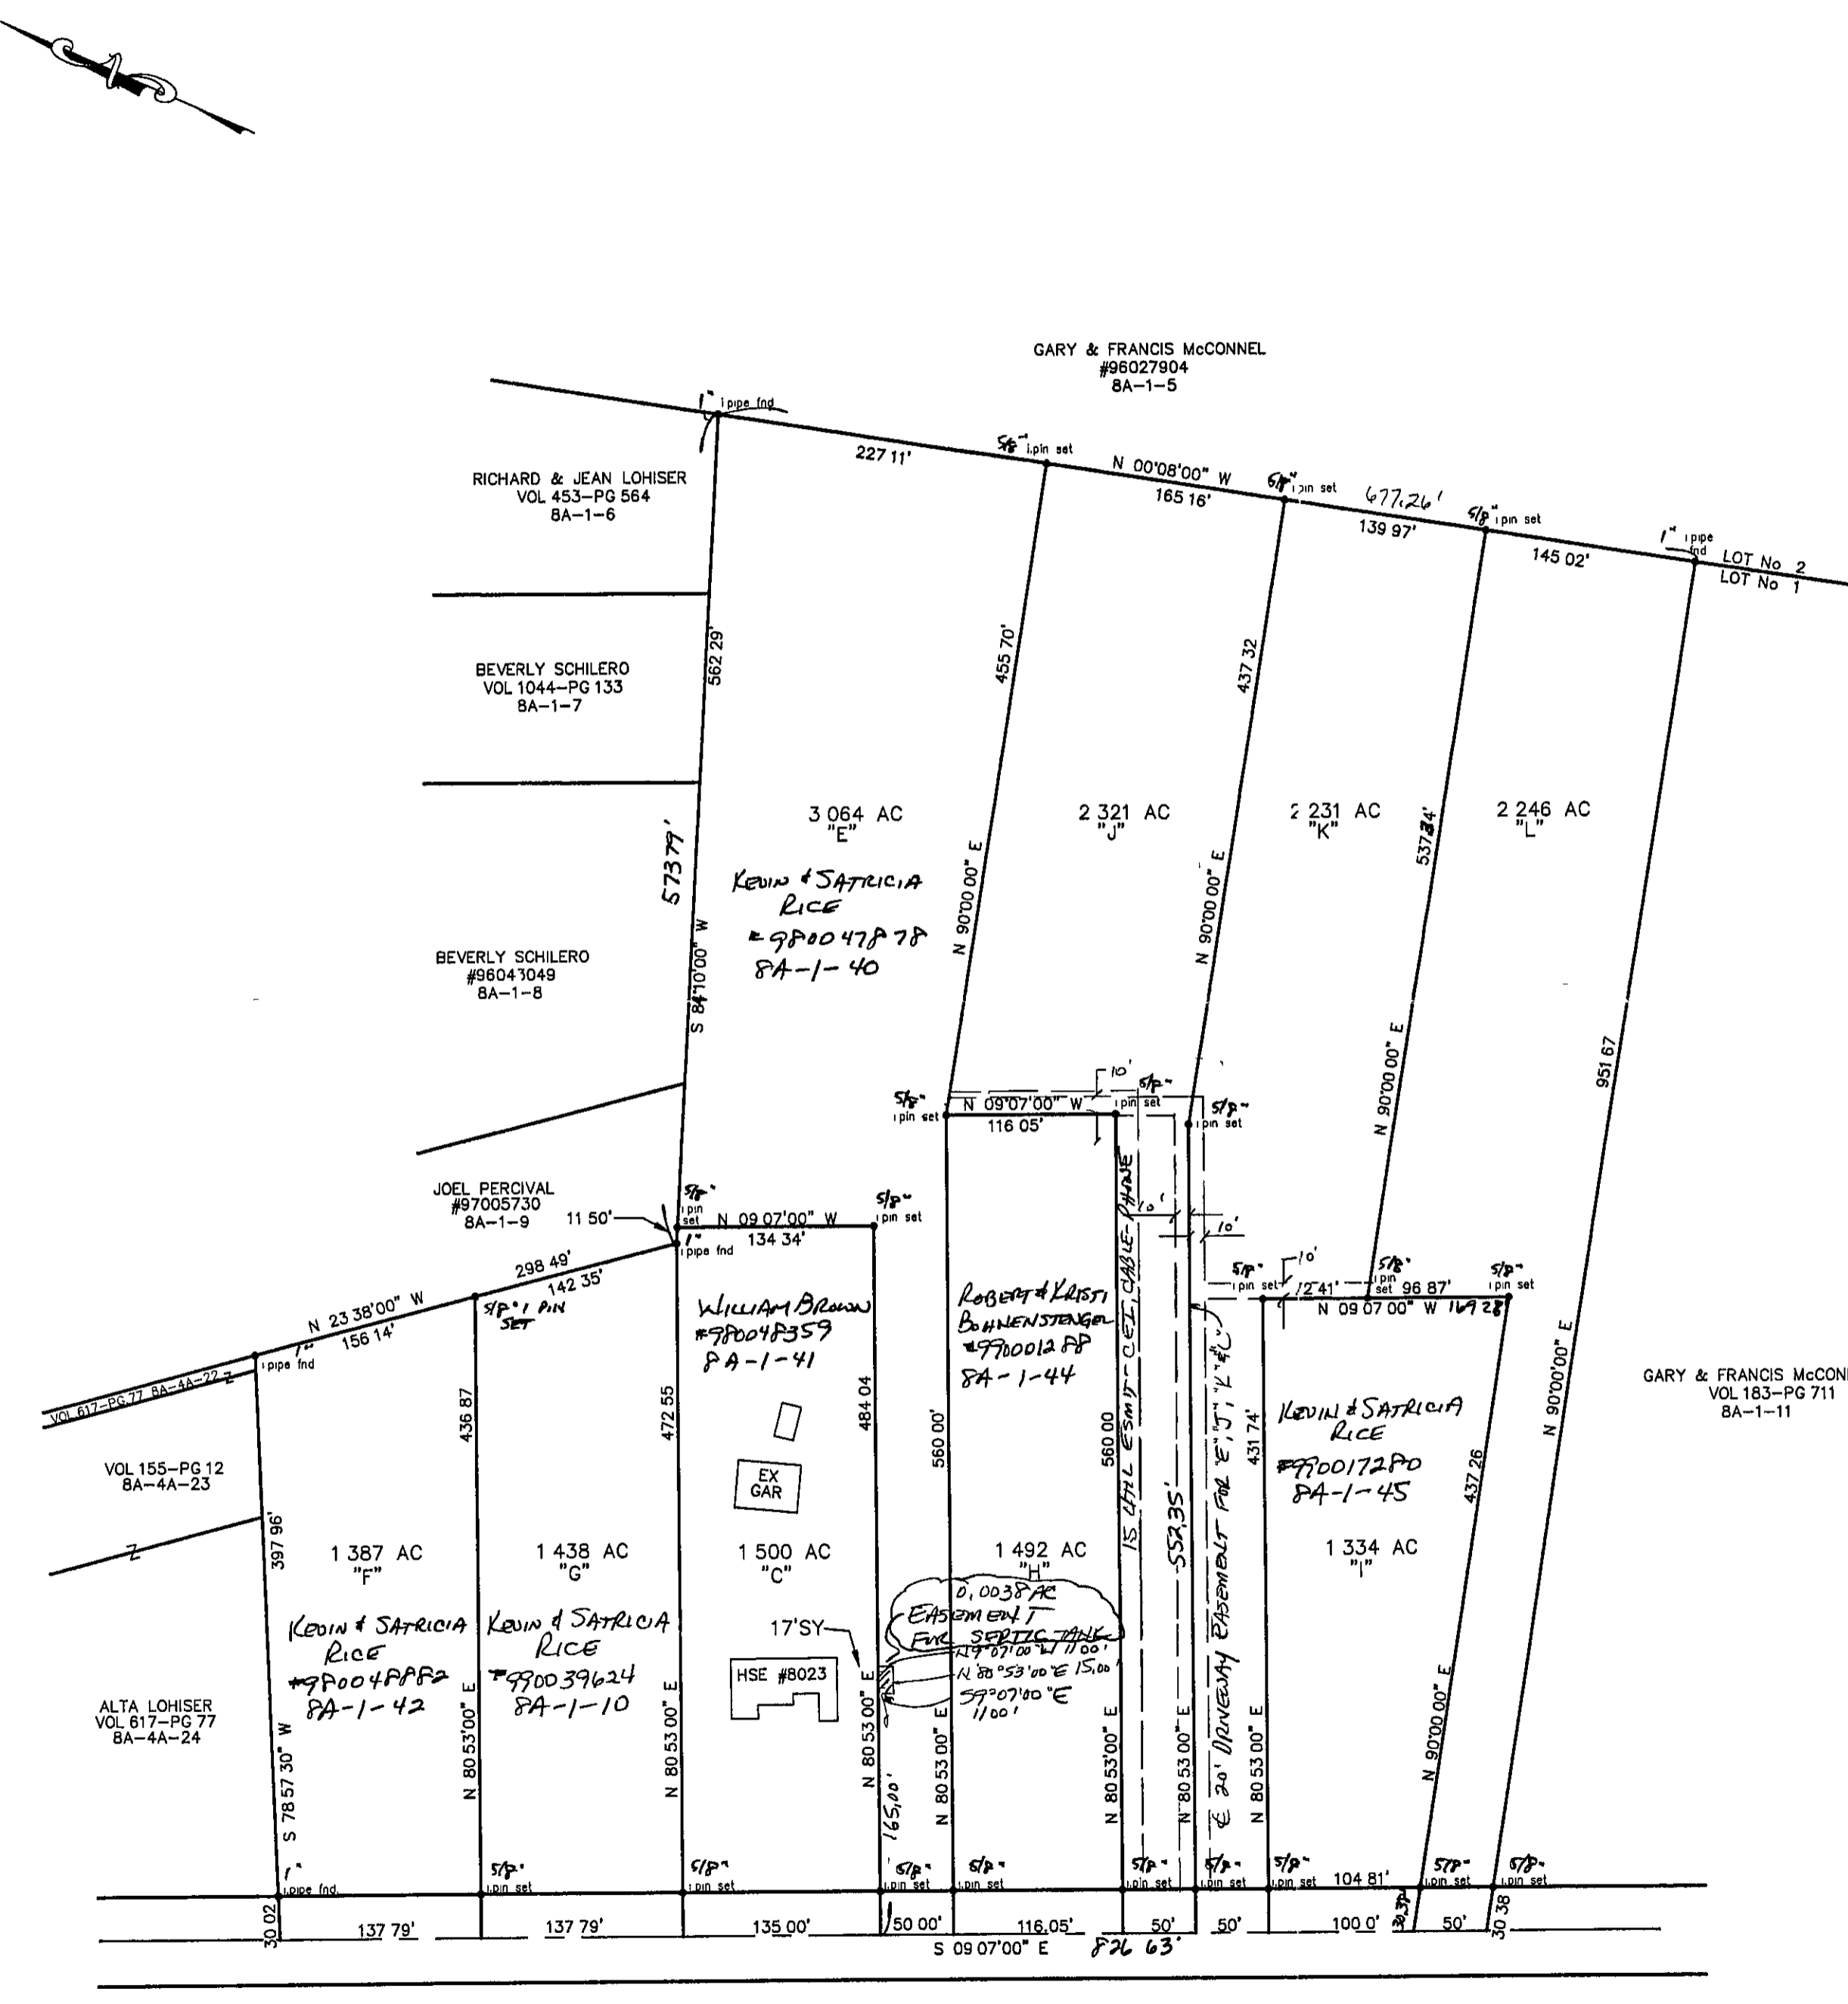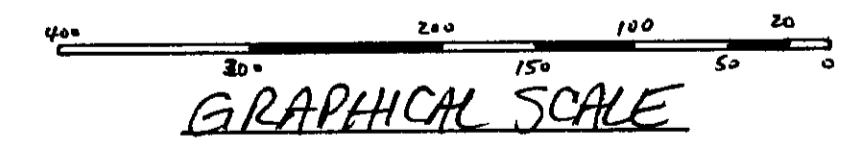

RAVENNA ROAD - 60'