


NOTE: ALL IRON PINS SET ARE 5/8" X 30" AND ARE CAPPED BABCOCK, JONES & ASSOC.

1 inch = 40 ft. ( IN FEET )

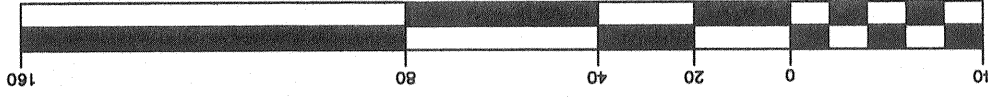

GRAPHIC SCALE

REG. NO. REGISTERED SURVEYOR AND ARE CORRECT TO THE BEST OF MY KNOWLEDGE AND BELIEF. FINISH GRADES CHECKED IN THE FIELD ON 20 AS BUILT CERTIFICATION THAT THE CIRCLED GRADES ARE EXISTING I, HEREBY CERTIFY

NO.	DATE	BY
1	1/11/05	B.P.
2	1/27/05	HJ
3	2/3/05	HJ
4	11/3/04	H.J.
5		E.H.


PLAN PREPARED BY: BABCOCK · JONES & ASSOCIATES, INC. PAINESVILLE, OHIO

PHONE NO. 440-357-1811  
DRAWING NO. 04-264

CHECK LIST	
NO. OF BEDROOMS	
DIMENSIONS	
WATER MAIN SIZE, LOCATION	
SAN. SEWER SIZE % GR. LOC.	
SAN. MH. CAST, ELEV. INV. ELEV.	
SAN. CONN. SIZE, LOC. DEPTH	
STORM SEWER SIZE % GR. LOC.	
STORM MH. CAST ELEV. INV. ELEV.	
PAV'T TYPE GRADE CURVES	
GAS LINE LOC. SIZE PRESSURE	
APRON TYPE WIDTH THICKNESS	
SIDEWALK TYPE DIA. LENGTH	
CULVERT TYPE DIA. LENGTH	
ROCK OUTCROPPINGS	

DESIGN CERTIFICATION THIS PLAN WAS PREPARED BY ME, AND IS CORRECT TO THE BEST OF MY KNOWLEDGE AND BELIEF.

REMARKS ALL BOUNDARY DATA SHOWN WAS OBTAINED FROM (DEEDS, RECORDED SUBDIVISION PLAT OR OTHER PUBLIC RECORDS), RECORDED LOCATIONS AS SHOWN OF ADJACENT WELLS AND SEPTIC TANKS OBTAINED FROM LAKE COUNTY HEALTH DEPARTMENT

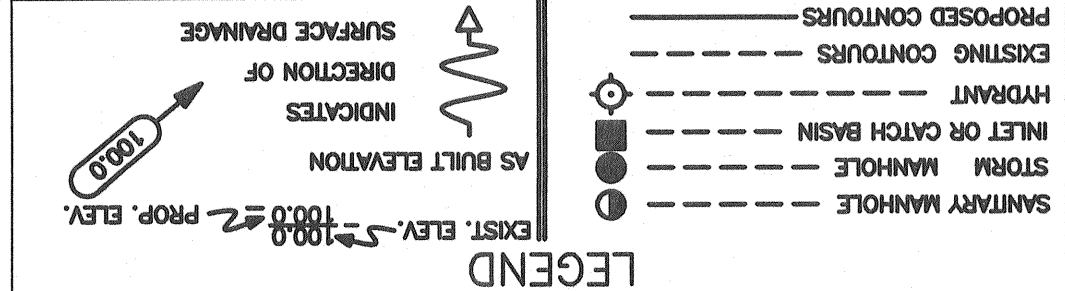

PLAT OF SURVEY

CITY OF KIRTLAND, LAKE COUNTY, OHIO

for: ANDY LONGAR

CLIENT

OWNER

ADDRESS

STREET CITY ZIP


SUBDIVISION NAME TRACT

VOL-PG. HOBART ROAD

LOT

PERM. PARCEL NO. 20A-22B-4

SUBLOT NO.

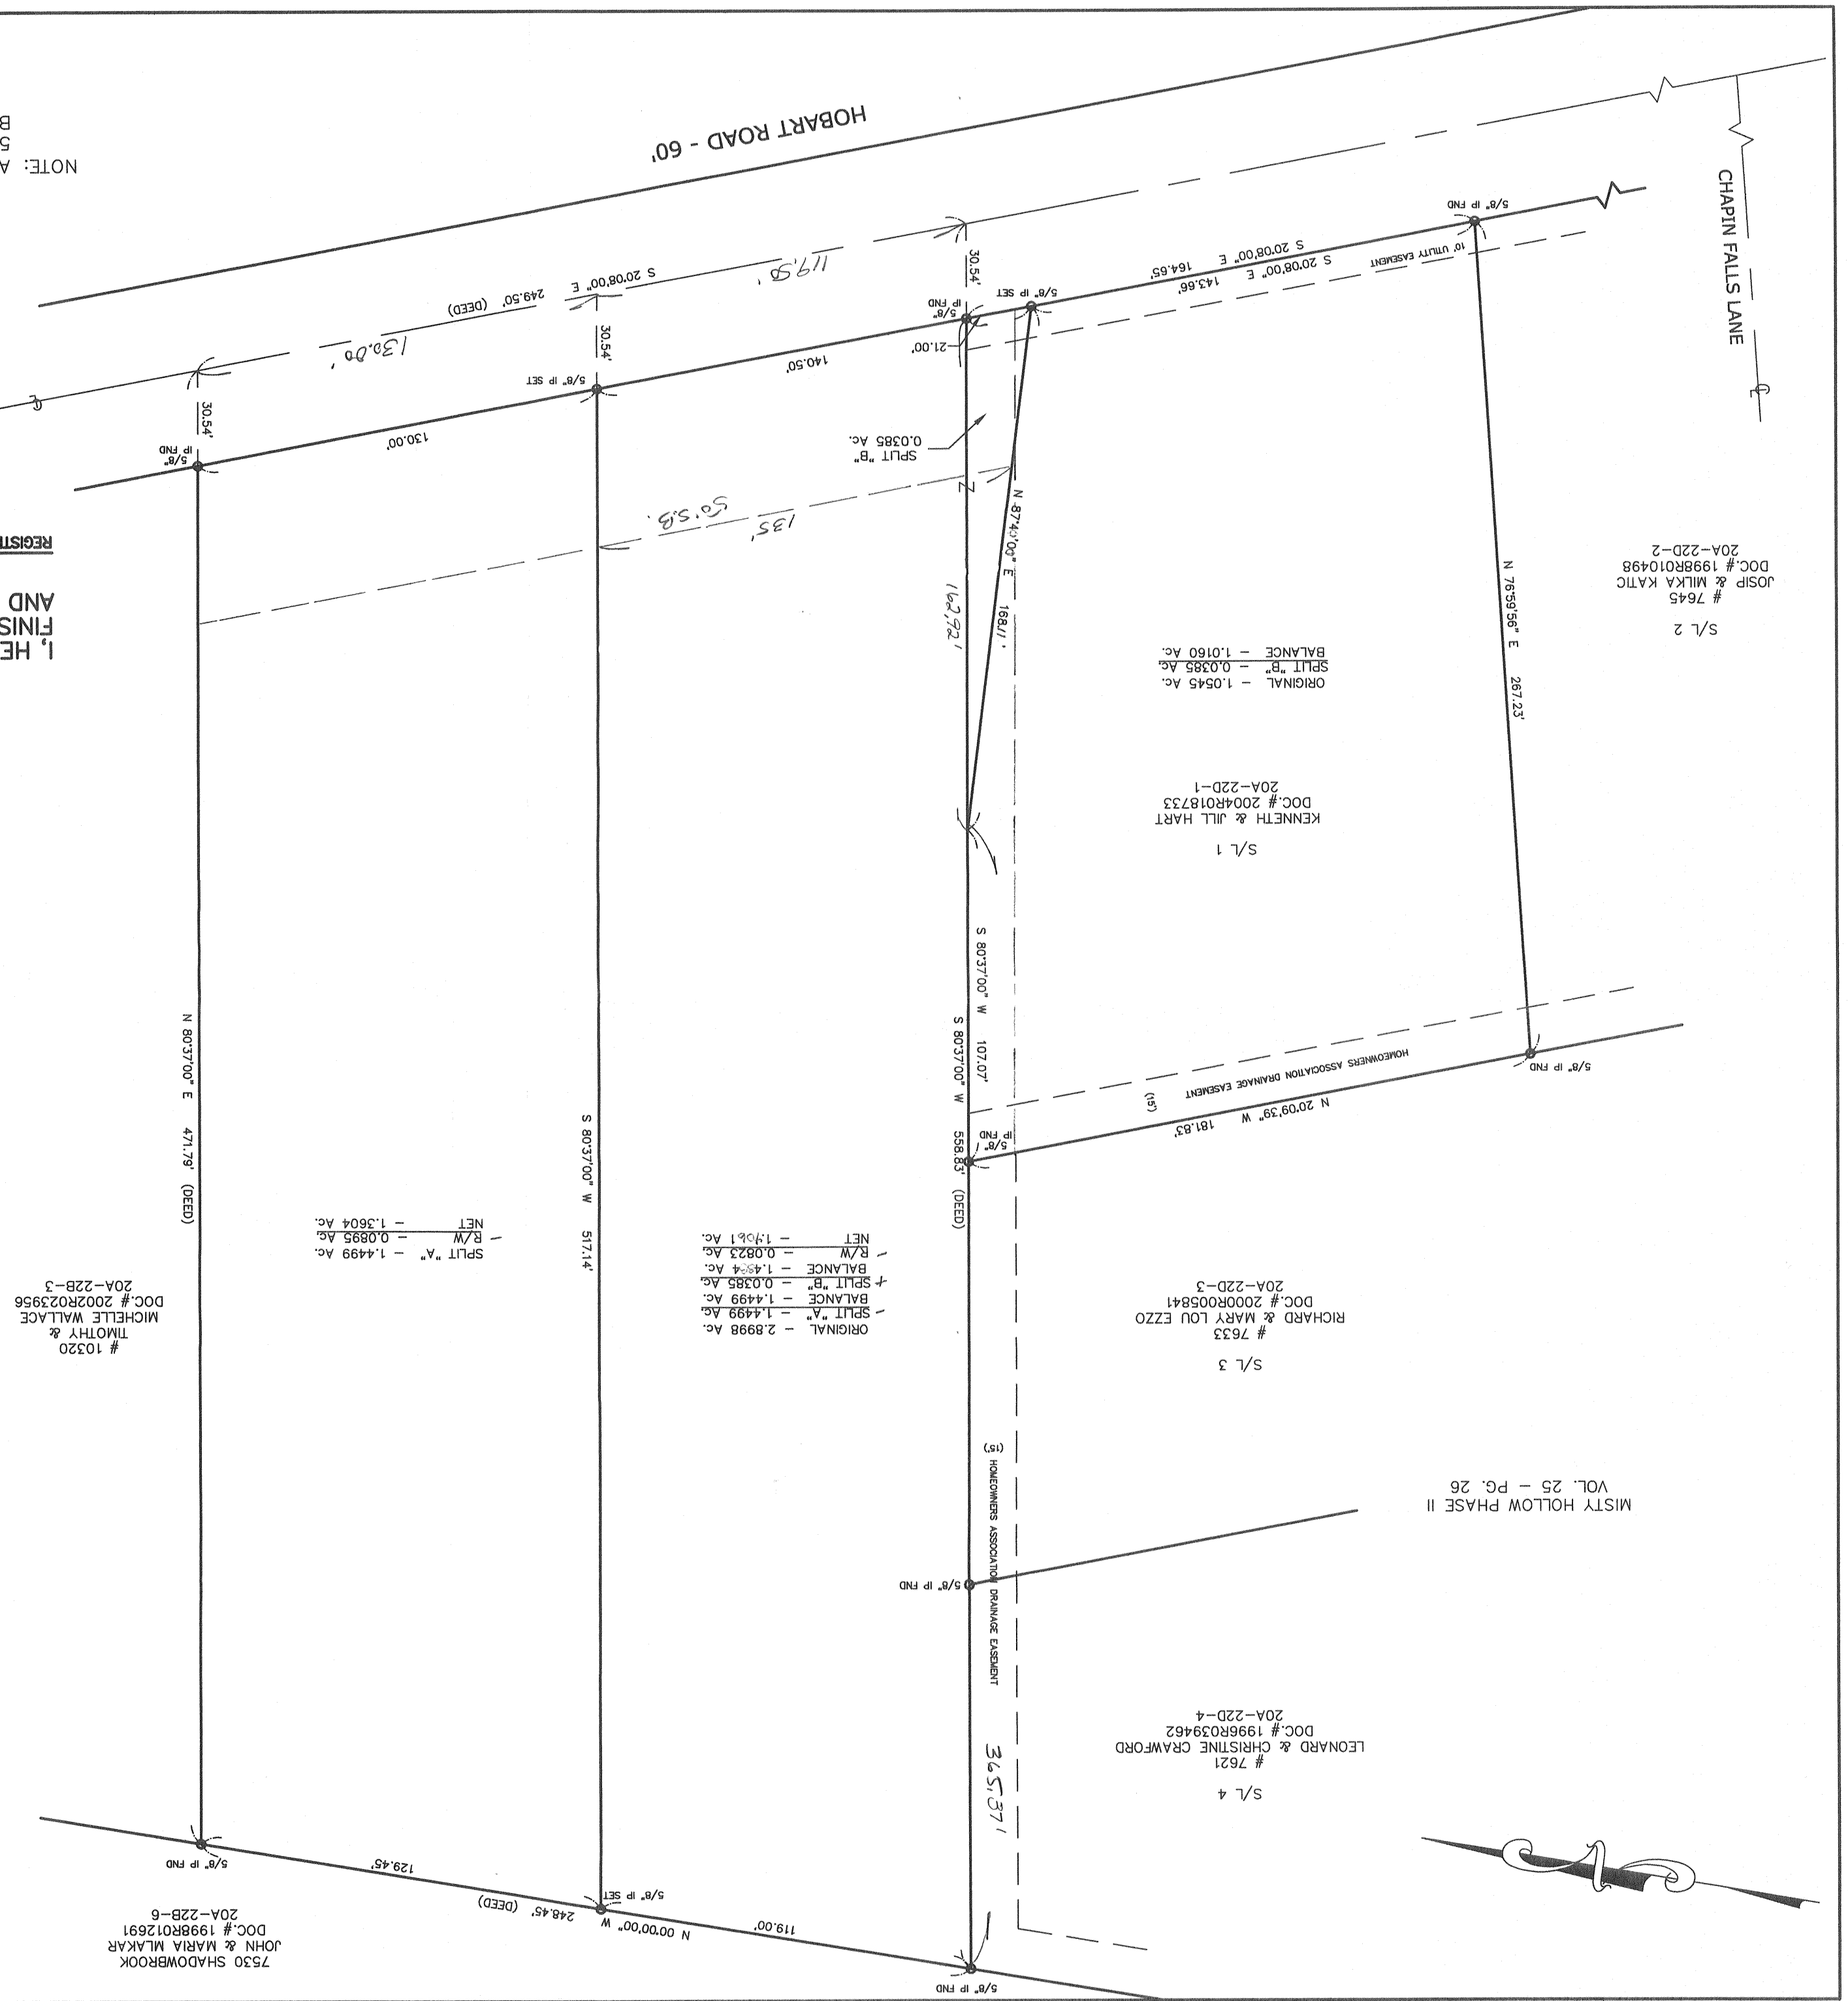

# 10320 TIMOTHY & MICHELLE WALLACE DOC # 2002R023956 20A-22B-3

7530 SHADOWBROOK JOHN & MARIA MLAKAR DOC # 1998R012691 20A-22B-6

S/L 4 # 7621 LEONARD & CHRISTINE CRAWFORD DOC # 1996R039462 20A-22D-4

S/L 3 # 7633 RICHARD & MARY LOU EZZO DOC # 2000R005841 20A-22D-3

S/L 1 KENNETH & JILL HART DOC # 2004R018733 20A-22D-1

S/L 2 # 7645 JOSIP & MILKA KATIC DOC # 1998R010498 20A-22D-2

MISTY HOLLOW PHASE II VOL. 25 - PG. 26

