
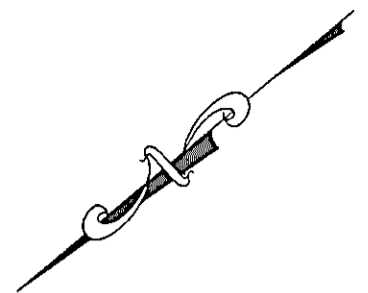


GRAPHIC SCALE

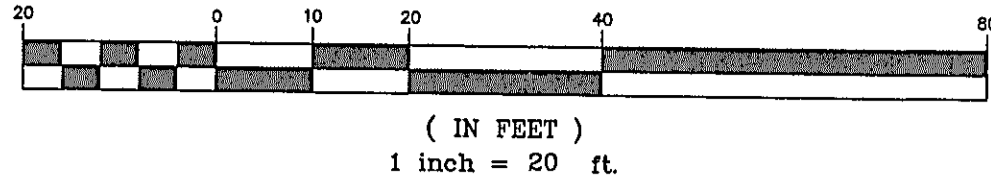

SITE PLAN

LAKELINE VILLAGE, LAKE COUNTY, OHIO
 for: DENNIS SIMMONS
 CLIENT OWNER
 ADDRESS STREET CITY ZIP
LAWTON BEACH ALLOTMENT 16 TRACT
 SUBDIVISION B-28 NAME 7 STREET
 6.7 VOL-PG. LAKE SHORE BLVD. LOT 30A-7-4
 SUBLOT NO. STREET VOL-PG. PERM. PARCEL NO.

LEGEND

- SANITARY MANHOLE --- (1)
- STORM MANHOLE --- (2)
- INLET OR CATCH BASIN --- (3)
- HYDRANT --- (4)
- EXISTING CONTOURS --- (5)
- PROPOSED CONTOURS --- (6)
- EXIST. ELEV. --- 100.0
- PROP. ELEV. --- 100.0
- AS BUILT ELEVATION --- (7)
- INDICATES DIRECTION OF SURFACE DRAINAGE --- (8)

REMARKS

ALL BOUNDARY DATA SHOWN WAS OBTAINED FROM (DEEDS, RECORDED SUBDIVISION PLAT OR OTHER PUBLIC RECORDS)
 LOCATIONS AS SHOWN OF ADJACENT WELLS AND SEPTIC TANKS OBTAINED FROM LAKE COUNTY HEALTH DEPARTMENT

DESIGN CERTIFICATION

THIS PLAT WAS PREPARED BY ME, AND IS CORRECT TO THE BEST OF MY KNOWLEDGE AND BELIEF.
 NAME: Harry Jones SURVEYOR REGISTRATION NO. 62343

CHECK LIST


- | | |
|-------------------------------|---|
| NO. OF BEDROOMS | WATER MAIN SIZE, LOCATION |
| DIMENSIONS | SAN. SEWER SIZE & GR. LOC. |
| BEARINGS | SAN. MH. CAST. ELEV. INV. ELEV. |
| TIE TO NEAREST STREET | SAN. CONN. SIZE, LOC. DEPTH |
| SUBLOT NO., PARCEL NO. | STORM SEWER SIZE & GR. LOC. |
| SURROUNDING OWNERS | STORM MH. CAST ELEV. INV. ELEV. |
| BLDG. DIMENSIONS FIN GR. | PAVT TYPE GRADE CURBS |
| BLDG. TIES FL'R. GRADES | GAS LINE LOC. SIZE PRESSURE |
| APRON TYPE WIDTH THICKNESS | SEPTIC TANK LOCATION & DUPLICATION AREA |
| SIDEWALK TYPE WIDTH THICKNESS | WELL LOCATION |
| CULVERT TYPE DIA., LENGTH | ISOLATION RADIUS FROM WELL |
| ROCK OUTCROPPINGS | |

REVISIONS		
NO.	DATE	BY
1	1/23/02	HJ
2		
3		
4		
5		

PLAN PREPARED BY:
BABCOCK JONES & ASSOCIATES, INC.
 PAINESVILLE, OHIO
 DRAWN BY T.R. SCALE 1"=20' PHONE NO. 440-357-1811
 CHK'D. H.J. DATE 9/11/01 DRAWING NO. 01-029
 CREW CHIEF W.B. APP'D H.J.

"AS BUILT" CERTIFICATION
 I, HEREBY CERTIFY THAT THE CIRCLED GRADES ARE EXISTING FINISH GRADES CHECKED IN THE FIELD ON 20 AND ARE CORRECT TO THE BEST OF MY KNOWLEDGE AND BELIEF.

REGISTERED SURVEYOR REG. NO.

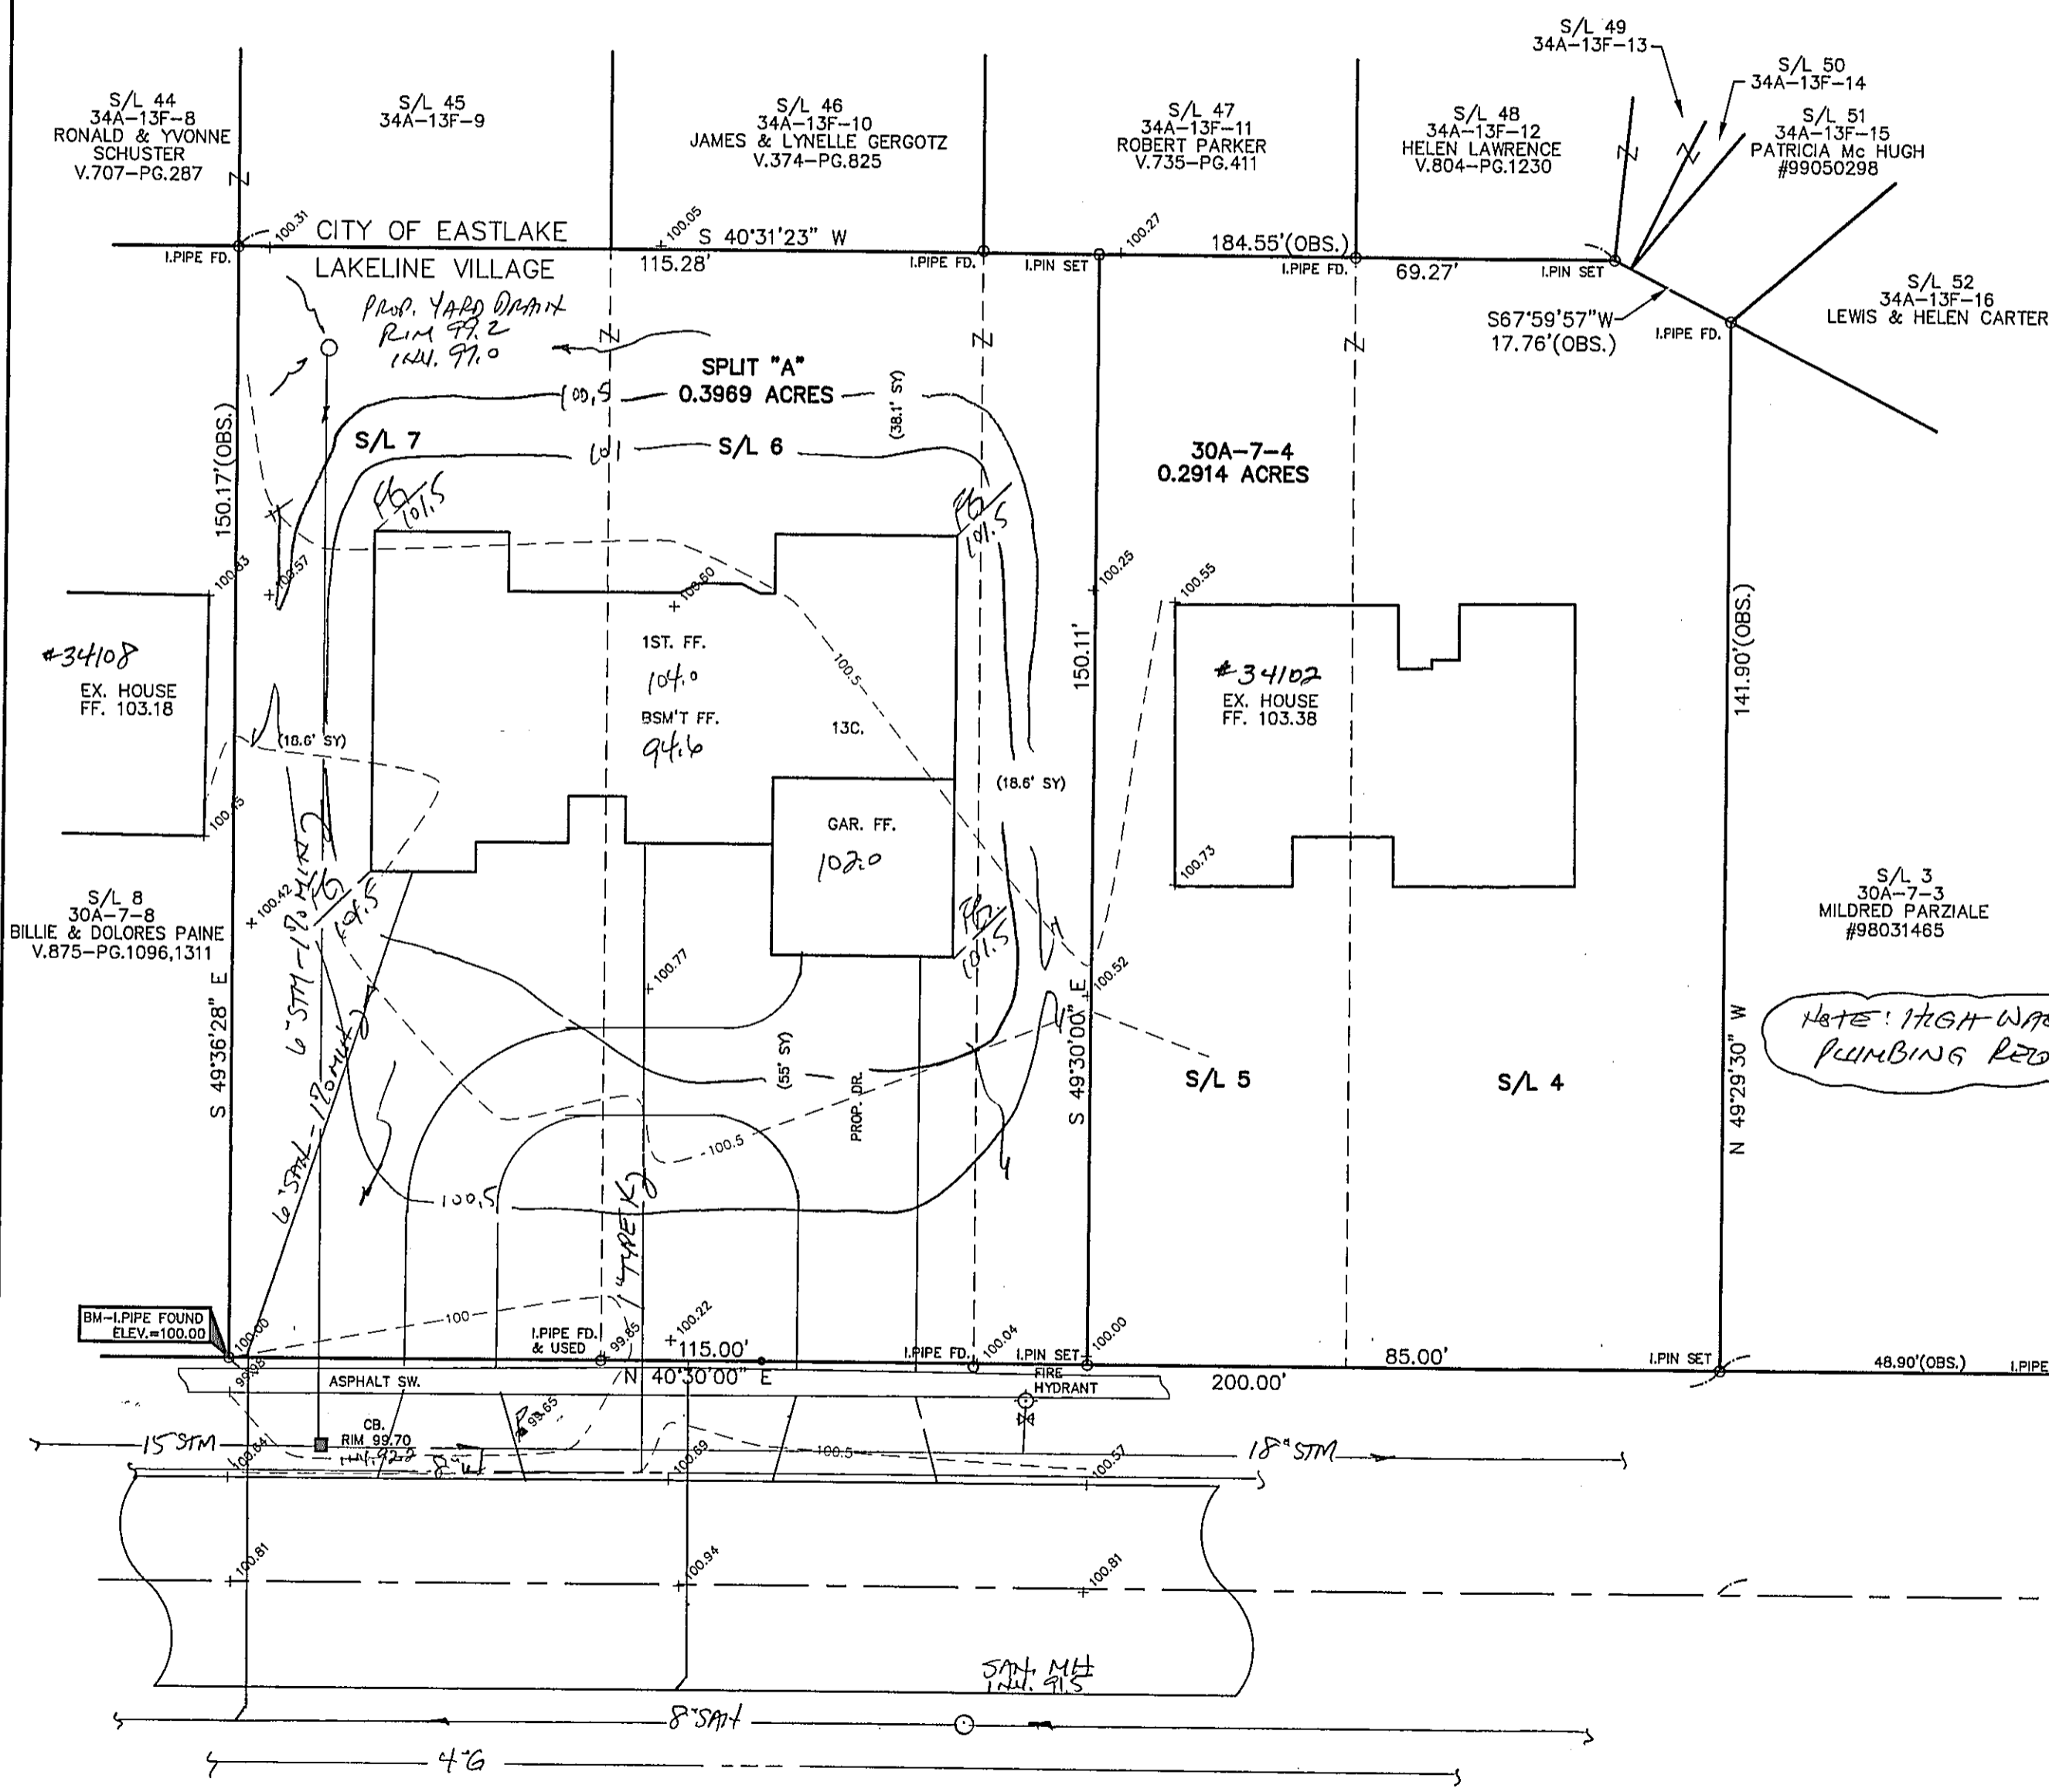

LAKE SHORE BOULEVARD - 60'

