SITE PLAN FOR:

SHANDLE CONSTRUCTION
8925 MENTOR AVE
MENTOR, OHIO

BEING SUBLOT NO. 29 IN THE MORLEY HILLS ESTATES SUBDIVISION NO. 1 IN CONCORD TWP., OHIO.

~~7644 Oakridge Dr~~

9953 Aspen

PREPARED BY:

WM. R. GRAY ASSOC. INC.
7547 MENTOR AVE.
MENTOR, OHIO

DATE: MARCH 22, 1975 SCALE: 1" = 20'

CERTIFICATION:

I HEREBY CERTIFY THAT THIS PLAT IS CORRECT TO THE BEST OF MY KNOWLEDGE.

By: Wm R Gray
WM. R. GRAY REG. SURV. # 275

STATE OF OHIO
WM. R. GRAY
2752
REGISTERED
PROFESSIONAL SURVEYOR

Zoning Permit # 2780
issued 4-1-75
H E van Driest

CURVE DATA 1

RAD. = 30.00' ARC. = 47.12'
CH. = 42.43' S. 39° 09' 00" W.

CURVE DATA 2

RAD. = 655.60' ARC. = 37.31'
CH. = 37.28' N. 84° 45' 16" E.

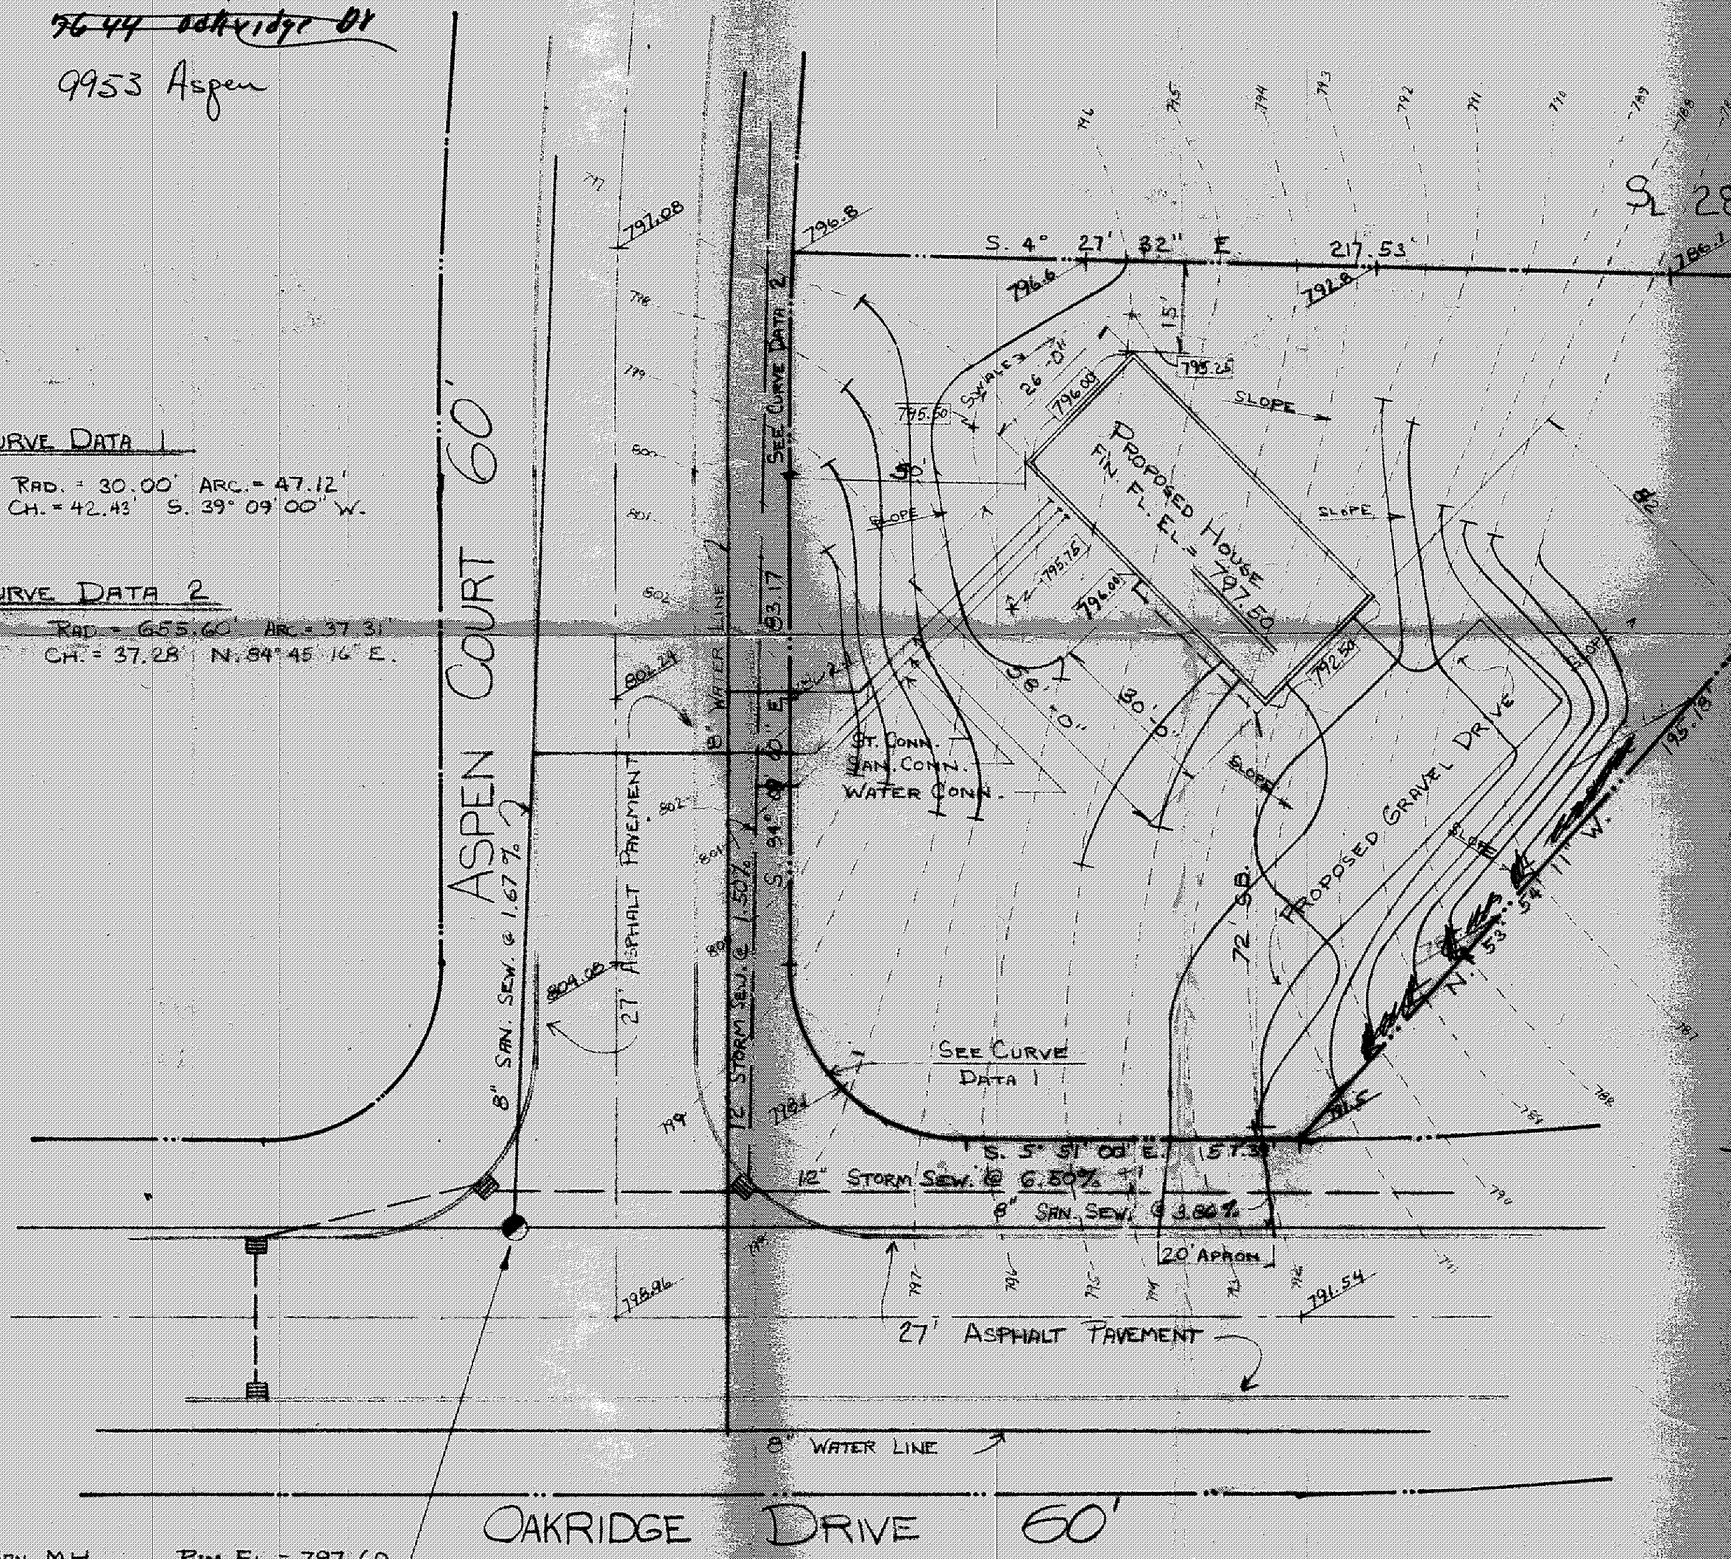

Grading Plan Approved as shown and/or noted
THOMAS P. GILLES, P.E.
Lake County Engineer
By JWK Date 4-1-75

SAN. MH. RIM EL. = 797.60
INV. EL. = 781.36 & 789.50