


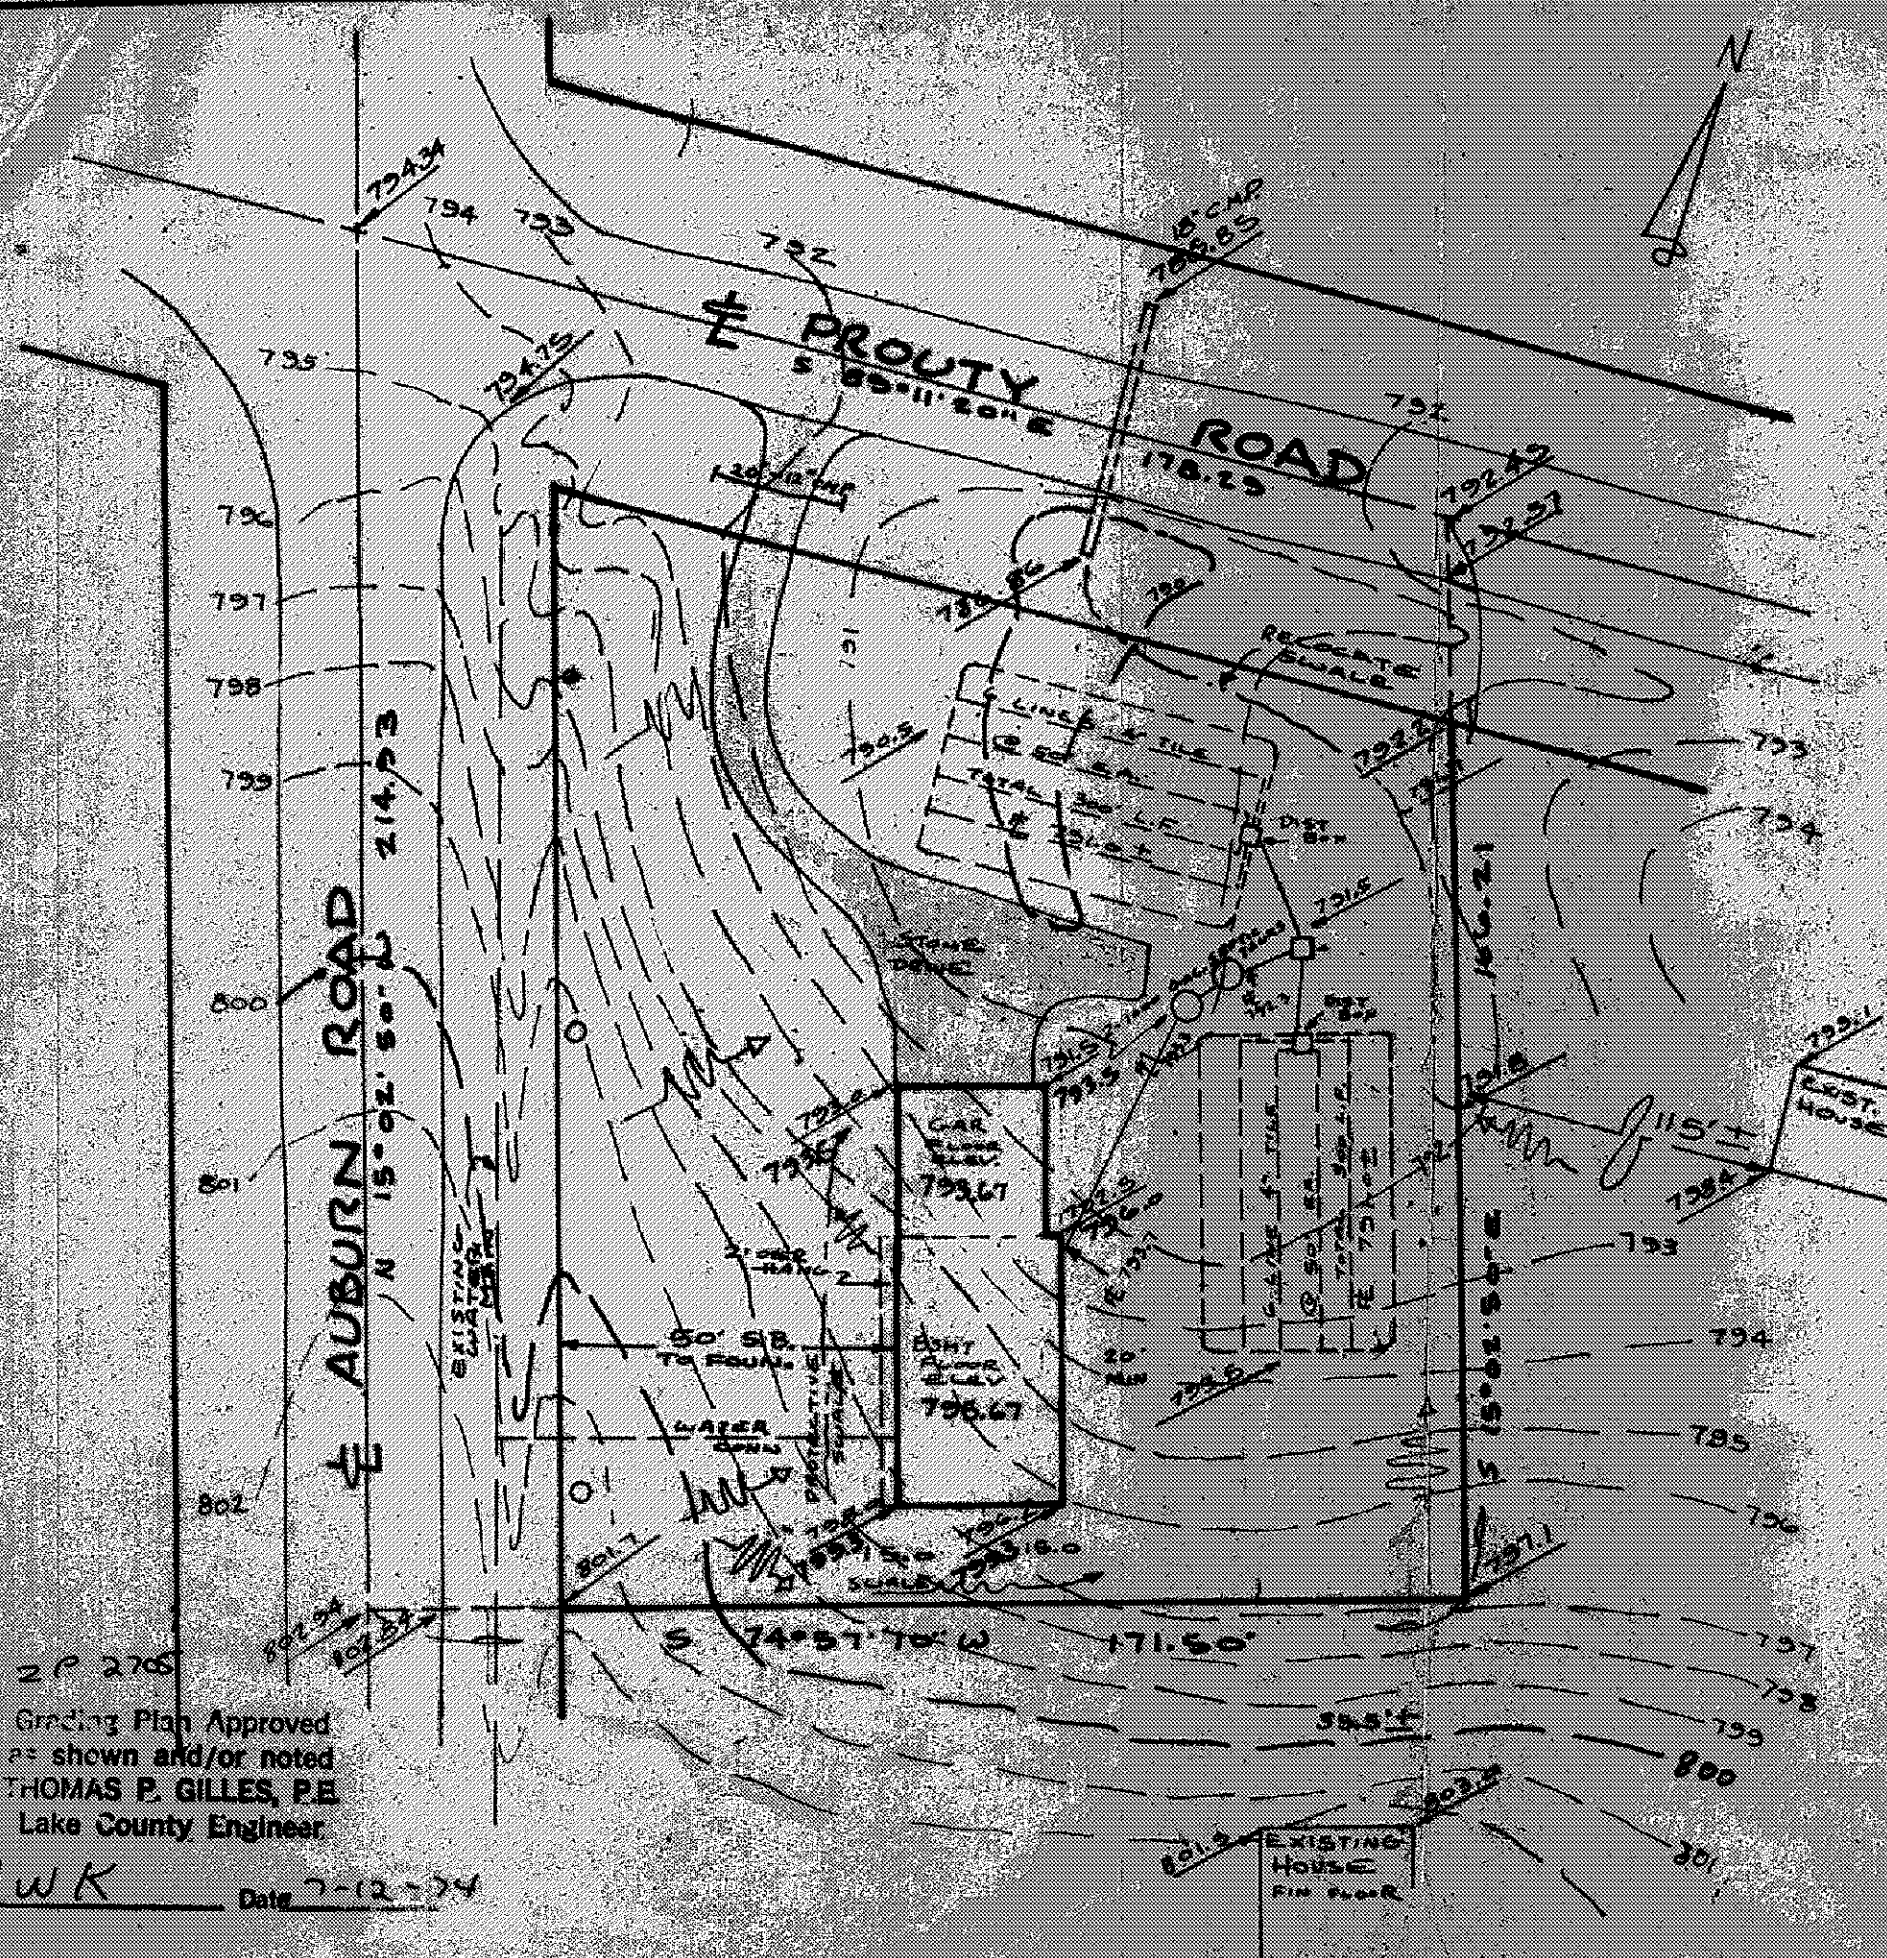

SITE PLAN

CONCORD LAKE COUNTY, OHIO
TOWNSHIP

for TERRY & RHONDA JESCHENIG
CLIENT OWNER

ADDRESS	STREET	CITY	ZIP
(PROPOSED) SUBSISTENCE HOMES	NE 7	NE 3	
SUBDIVISION NAME	LOT	TRACT	
21-A VOL - PS	VOLUME 22	PAGE	PROUTY & AUBURN
SUBLOT NO.	STREET	PERM PARCEL #	STREET

LEGEND

SANITARY MANHOLE	WATER VALVE (GAS)
STORM MANHOLE	WATER METER (GAS)
INLET OR CATCH BASIN	AS BUILT ELEVATION
HYDRANT	INDICATES DIRECTION OF SURFACE DRAINAGE
EXISTING CONTOURS	
PROPOSED CONTOURS	
EXIST ELEV 100.0	
100.0 2-PROP ELEV	

REMARKS

ALL BOUNDARY DATA SHOWN WAS OBTAINED FROM (DEEDS, RECORDED SUBDIVISION PLAT OR OTHER PUBLIC RECORDS)

LOCATIONS AS SHOWN OF ADJACENT WELLS AND SEPTIC TANKS OBTAINED FROM LAKE COUNTY HEALTH DEPARTMENT

DESIGN CERTIFICATION

THIS PLAT WAS PREPARED BY ME, AND IS CORRECT TO THE BEST OF MY KNOWLEDGE AND BELIEF
NAME SURVEYOR REGISTRATION NO. PS 5244

CHECK LIST

NO. OF BEDROOMS	WATER MAIN SIZE	LOCATION
DIMENSIONS	SAN SEWER SIZE	% GR LOC
BEARINGS	SAN MH CAST ELEV	INV ELEV
TIE TO NEAREST STREET	SAN CONN SIZE	LOC DEPTH
SUBLOT NO. PARCEL NO.	STORM SEWER SIZE	% GR LOC
SURROUNDING OWNERS	STORM MH CAST ELEV	INV ELEV
BLOG DIMENSIONS FIN. GR.	PAVT TYPE GRADE	CURBS
BLOG TIES FLR GRADES	GASLINE LOC SIZE	PRESSURE
APRON TYPE WIDTH THICKNESS	SEPTIC TANK LOCATION & DUPLICATION AREA	
SEWALK TYPE WIDTH THICKNESS	WELL LOCATION	
CULVERT TYPE DIA. LENGTH	ISOLATION RADIUS FROM WELL	
ROCK OUTCROPPINGS		

REVISIONS

NO	DATE	BY
1	7/11/74	PJB
2		
3		
4		
5		

PLAN PREPARED BY

DEBEVEC SALO & ASSOC, INC.

130 EAST JACKSON ST. PAINESVILLE

DRAWN BY PJB	SCALE 1"=30'	PHONE NO.
CHKD	DATE July 8, 74	DRAWING NO.
CREW CHIEF	APPD	4156