

LITTLE MOUNTAIN PARK ESTATES No. 4
VOL. 2 PG. 83

ZONING PERMIT #4755

ISSUED 11-14-83


SUBJECT TO APPROVAL BY:

☐ Lake County Sanitary Eng.
☒ Lake County Eng. Dept.
☐ Lake County Planning Comm.
☒ Lake County Bldg. Dept.

Tom J. Marano

CURVE DATA
R = 390.00'
A = 100.00'
Δ = 14° 42' 00"
T = 50.31'
C = 99.79'
S. 07° 04' 10" W.

①

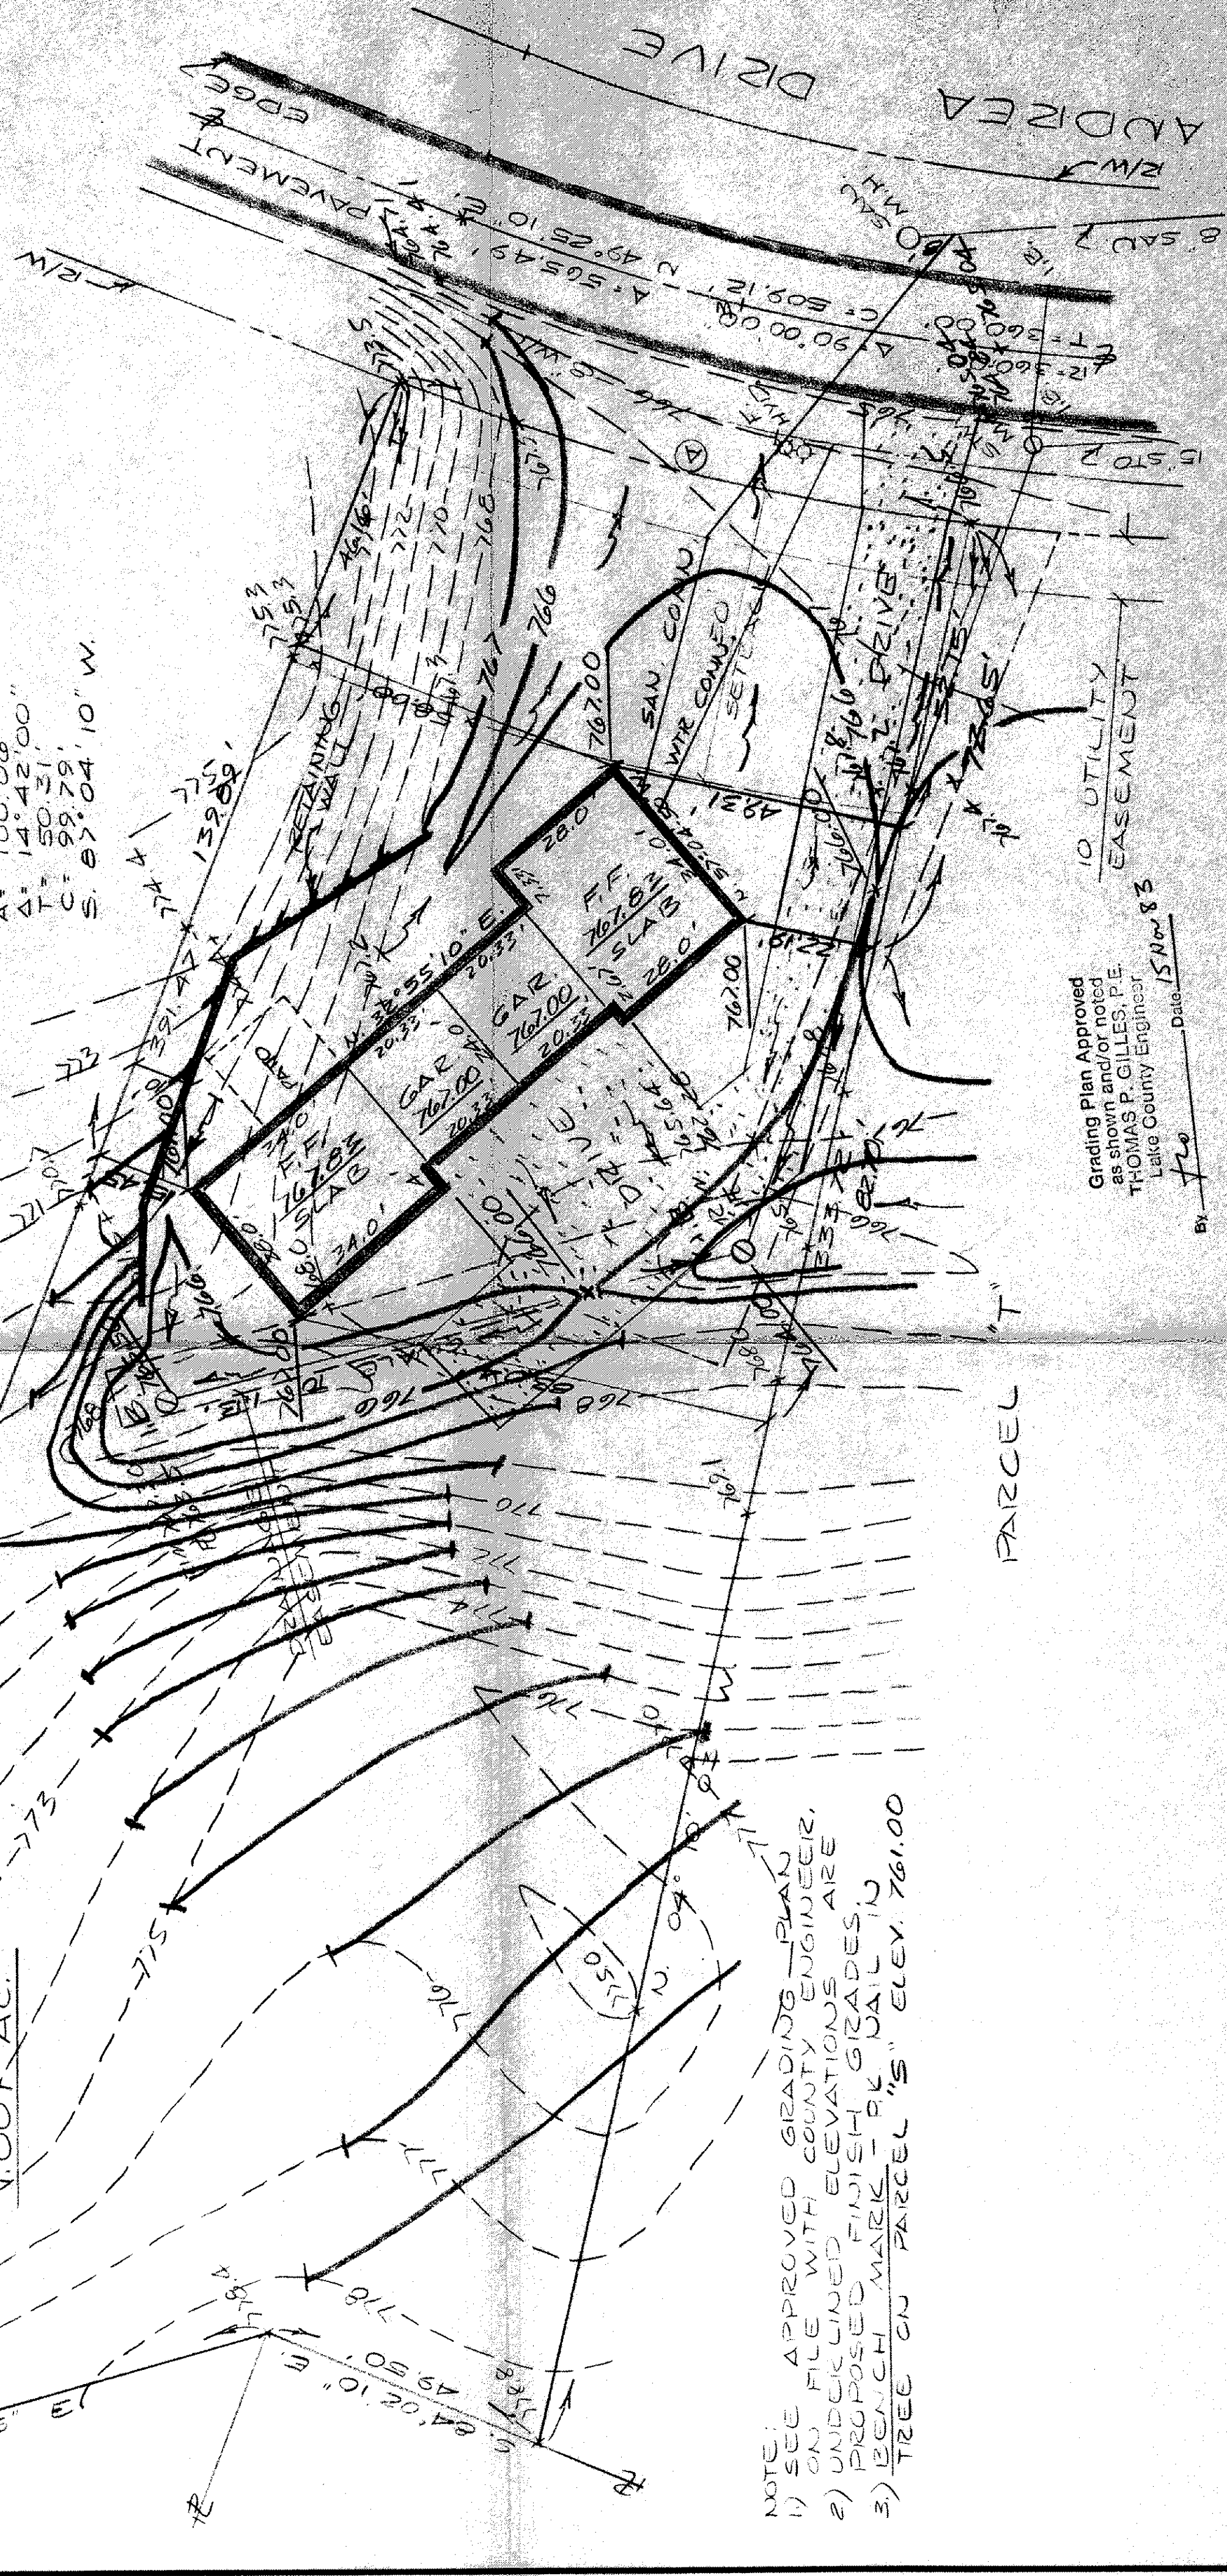

Grading Plan Approved
as shown and/or noted
THOMAS P. GILLES, P.E.
Lake County Engineer

By Tom Date 15 Nov 83

NOTE:
1) SEE APPROVED GRADING PLAN
ON FILE WITH COUNTY ENGINEER.
2) UNDERLINED ELEVATIONS ARE
PROPOSED FINISH GRADES.
3) BENCH MARK - PL NAIL IN
TREE ON PARCEL "S" ELEV. 761.00

SITE PLAN FOR:
SWAVELEY COMPANY
PARCEL "U" SHADY KNOLL SUBDIVISION No. 2
CONCORD TOWNSHIP, LAKE COUNTY, OHIO

COLPETZER WOODS
CONSULTANTS, INC.
MENTOR, OHIO 44060

DATE 10/10/83
SCALE 1" = 20'
DRAWN BY THP
CHECKED BY THP
SHEET 1 OF 1
CONTRACT 83-520

DESIGN CERTIFICATION
THIS PLAN WAS PREPARED BY ME
AND IS CORRECT TO THE BEST OF
MY KNOWLEDGE AND BELIEF

AS BUILT CERTIFICATION
I HEREBY CERTIFY THAT THE ENCLOSED
PLAN IS A TRUE AND CORRECT
REPRESENTATION OF THE AS BUILT
SITUATION AND THAT THE
SURVEY IS CORRECT TO THE BEST OF MY
KNOWLEDGE AND BELIEF

THOMAS P. GILLES
LAKE COUNTY ENGINEER