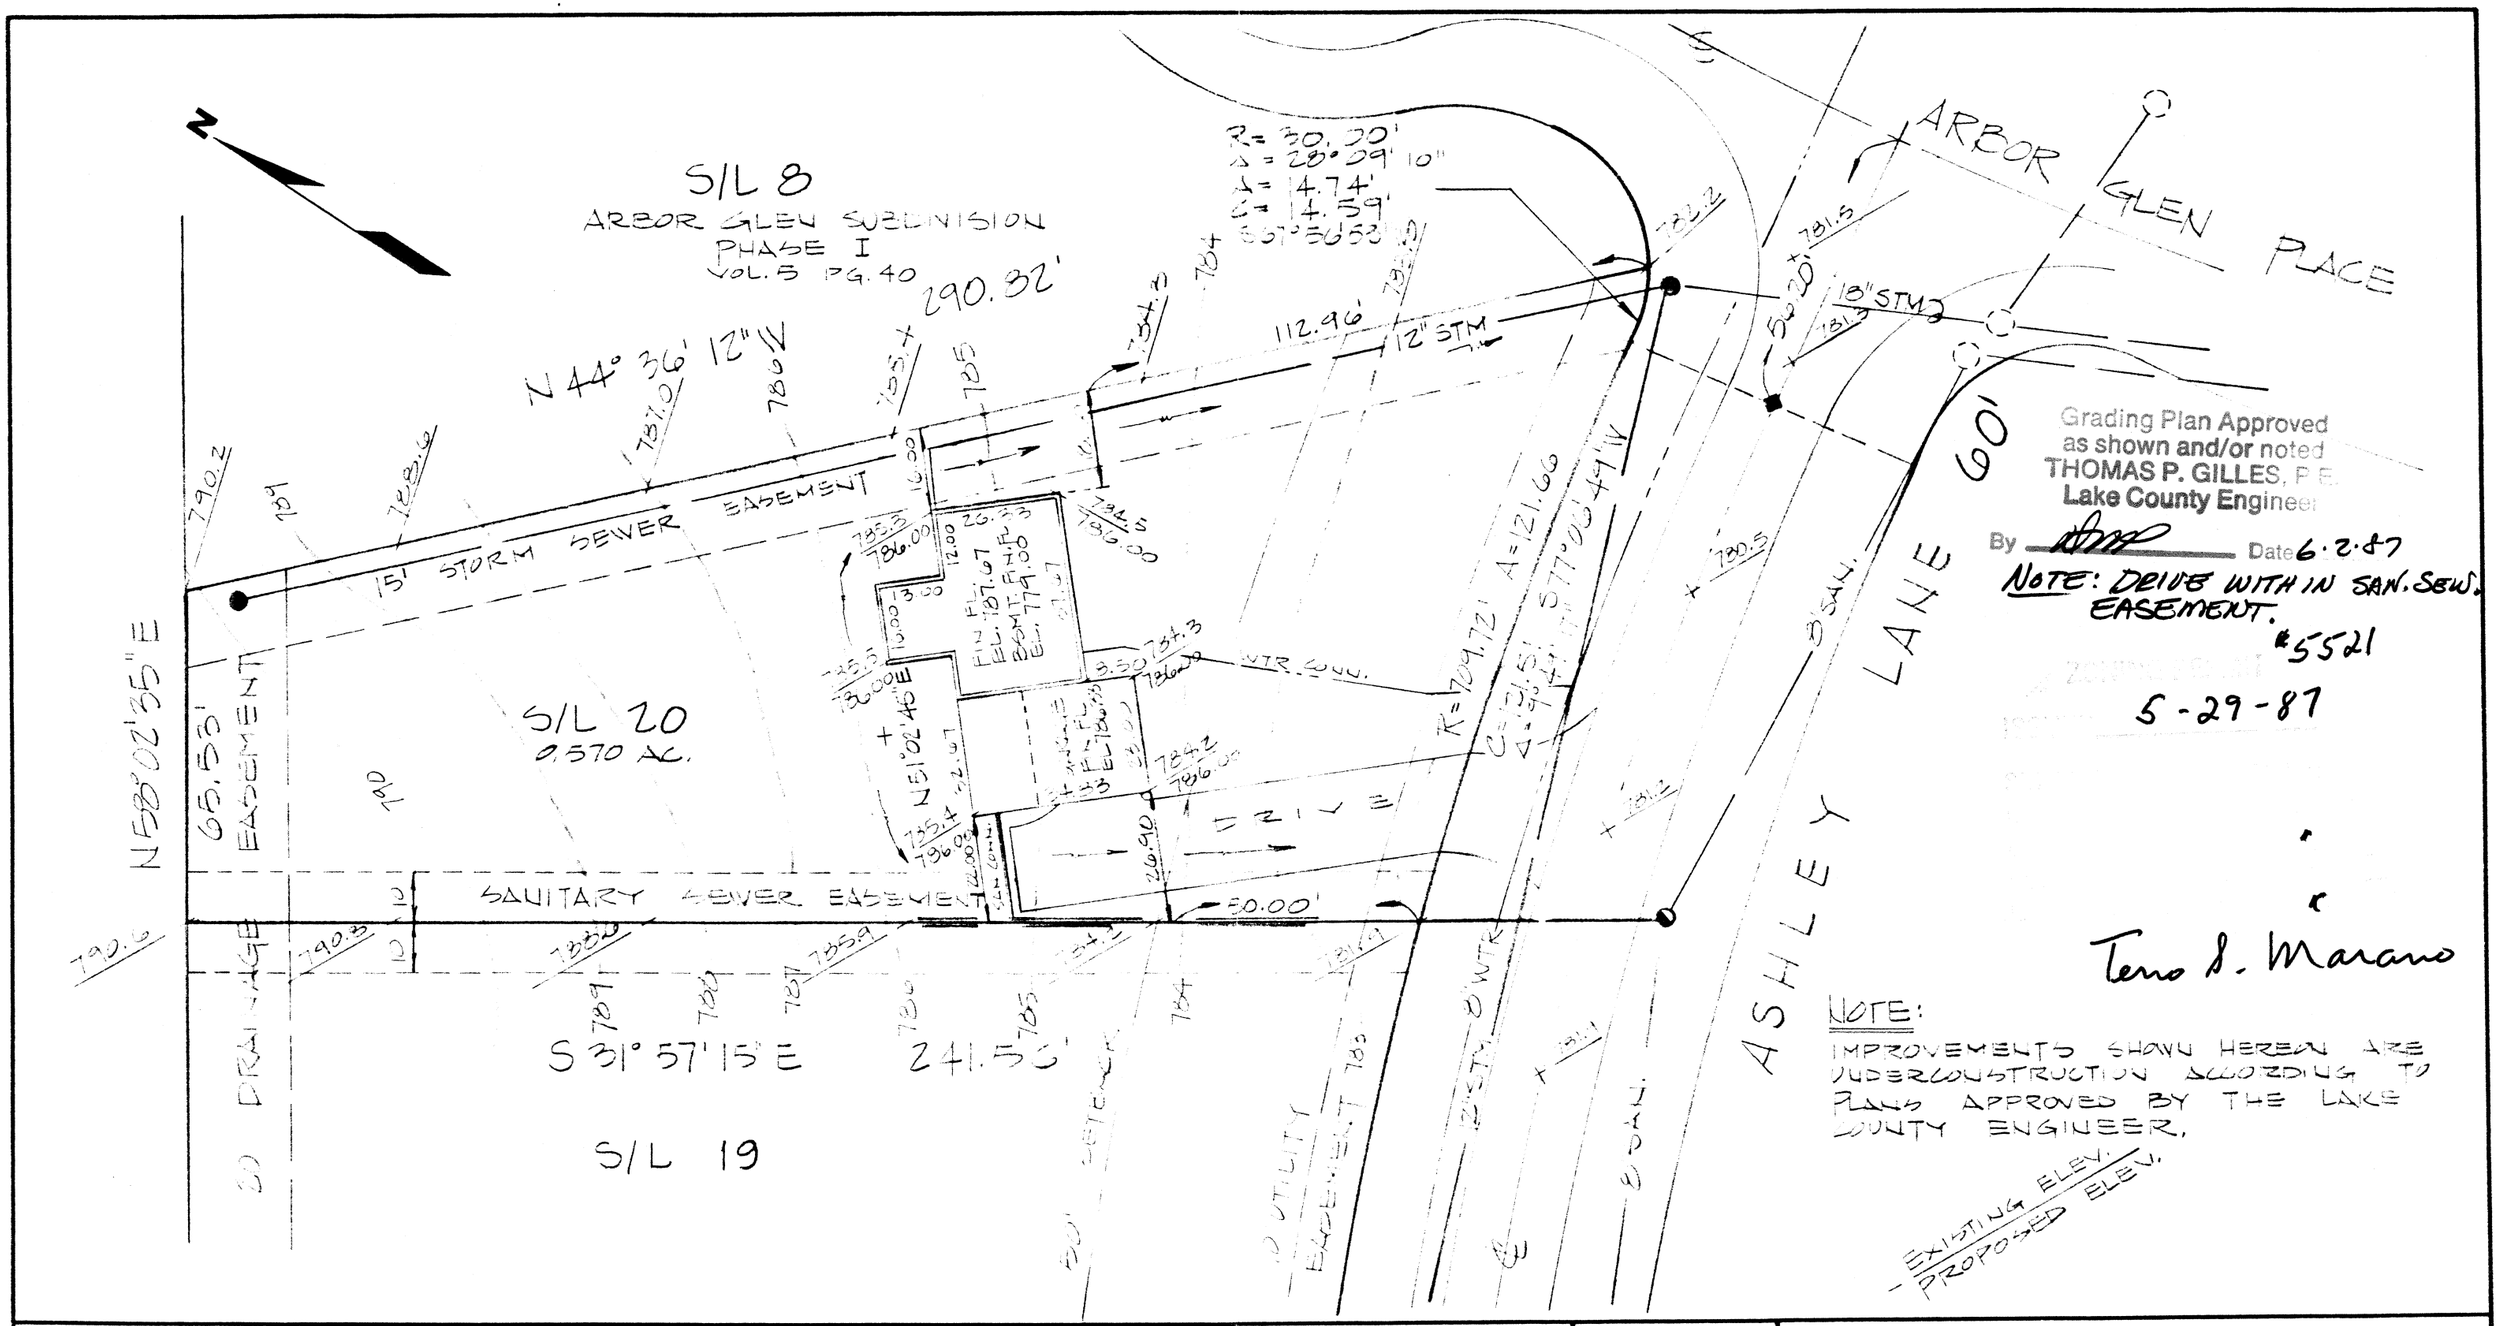

DESIGN CERTIFICATION

THIS PLAT WAS PREPARED BY ME, AND IS CORRECT TO THE BEST OF MY KNOWLEDGE AND BELIEF.

REG. SURVEYOR NO 5244

AS BUILT CERTIFICATION

I HEREBY CERTIFY THAT THE CIRCLED GRADES ARE EXISTING FINISH GRADES CHECKED IN THE FIELD ON _____ AND THAT SURVEY IS CORRECT TO THE BEST OF MY KNOWLEDGE AND BELIEF.

REG. SURVEYOR NO _____

COLPETZER · WOODS
CONSULTANTS, INC.
9470 MENTOR AVENUE • MENTOR, OHIO 44060 • (216) 357-7569

DATE 5-28-87
SCALE 1" = 30
DRWN BY L.H.
CHKD BY
JOB NO 87-
FB 514 PG 45

SITE PLAN FOR SCOTT ANDREWS

BEING SUBLOT NO. 20 OF THE ARBOR GLEN SUBDIVISION PHASE II (LOT 26, TR. 4)
LONGORD TOWNSHIP - LAKE COUNTY - OHIO