PLAT OF SURVEY AND PROPOSED SITE PLAN FOR
A THREE BEDROOM DWELLING. FRANK PAPP OWNER

SITUATED IN THE TOWNSHIP OF
CONCORD. COUNTY OF LAKE.
STATE OF OHIO.
LOT 6. TRACT 3
5.387 ACRES TO CENTERLINE
5.216 ACRES TO RIGHT-OF-WAY

LAND TAKEN FROM CLARA PAPP ET. AL.
DEED VOL. 725 PG. 936
PP# 08A-17-9

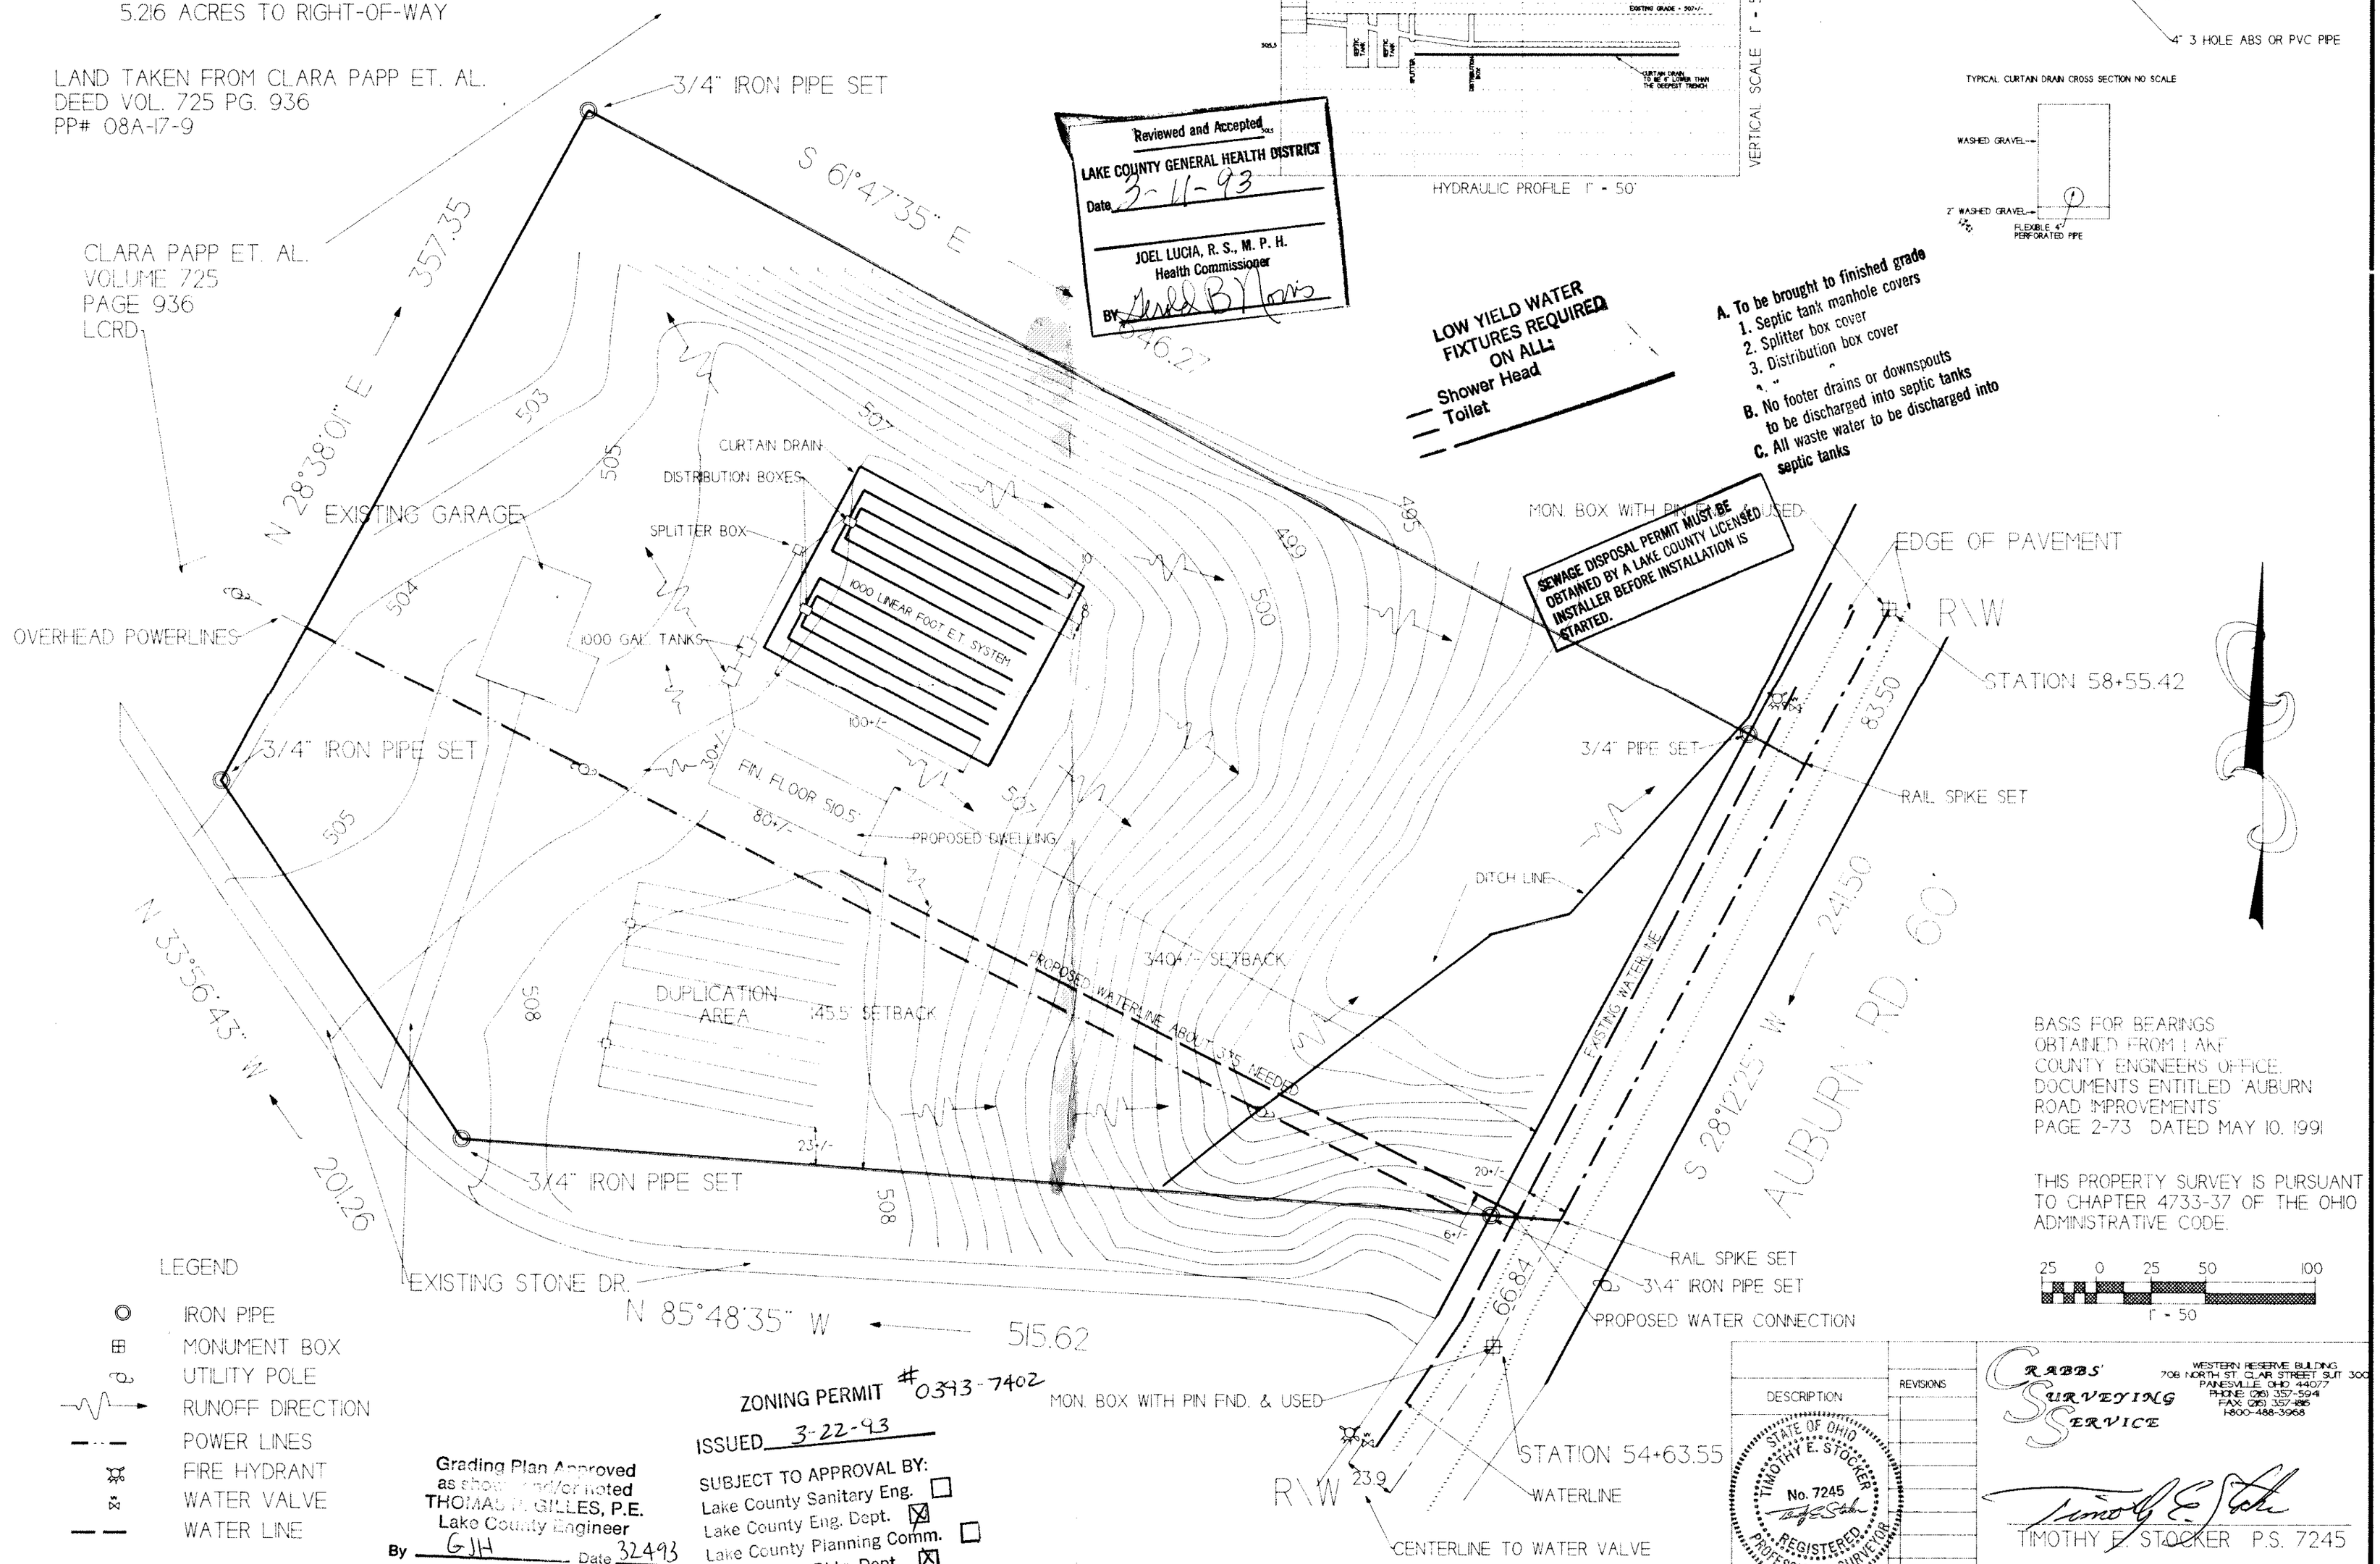

Reviewed and Accepted
LAKE COUNTY GENERAL HEALTH DISTRICT
Date 3-11-93
JOEL LUCIA, R. S., M. P. H.
Health Commissioner
BY

LOW YIELD WATER FIXTURES REQUIRED ON ALL:
Shower Head
Toilet

A. To be brought to finished grade
1. Septic tank manhole covers
2. Splitter box cover
3. Distribution box cover
4. " "
B. No footer drains or downspouts to be discharged into septic tanks
C. All waste water to be discharged into septic tanks

SEWAGE DISPOSAL PERMIT MUST BE OBTAINED BY A LAKE COUNTY LICENSED INSTALLER BEFORE INSTALLATION IS STARTED.

BASIS FOR BEARINGS
OBTAINED FROM LAKE
COUNTY ENGINEERS OFFICE.
DOCUMENTS ENTITLED "AUBURN
ROAD IMPROVEMENTS"
PAGE 2-73 DATED MAY 10, 1991

THIS PROPERTY SURVEY IS PURSUANT
TO CHAPTER 4733-37 OF THE OHIO
ADMINISTRATIVE CODE.

ZONING PERMIT #0393-7402
ISSUED 3-22-93

Grading Plan Approved
as shown and/or noted
THOMAS R. GILLES, P.E.
Lake County Engineer
By GJH Date 32493

SUBJECT TO APPROVAL BY:
Lake County Sanitary Eng. ☐
Lake County Eng. Dept. ☒
Lake County Planning Comm. ☐
Lake County Bldg. Dept. ☒

DESCRIPTION	REVISIONS

STATE OF OHIO
TIMOTHY E. STOCKER
No. 7245
REGISTERED PROFESSIONAL SURVEYOR

CRABBS' SURVEYING SERVICE
WESTERN RESERVE BUILDING
708 NORTH ST. CLAIR STREET SUIT 300
PAINESVILLE, OHIO 44077
PHONE (216) 357-5914
FAX (216) 357-1816
1-800-488-3968
TIMOTHY E. STOCKER P.S. 7245

COPYRIGHT 1993 CRABBS SURVEYING SERVICE

DRAWN BY	SCALE	DATE	PRINTED	DRAWING NO.	SHEET NO.