



STATE ROUTE 44


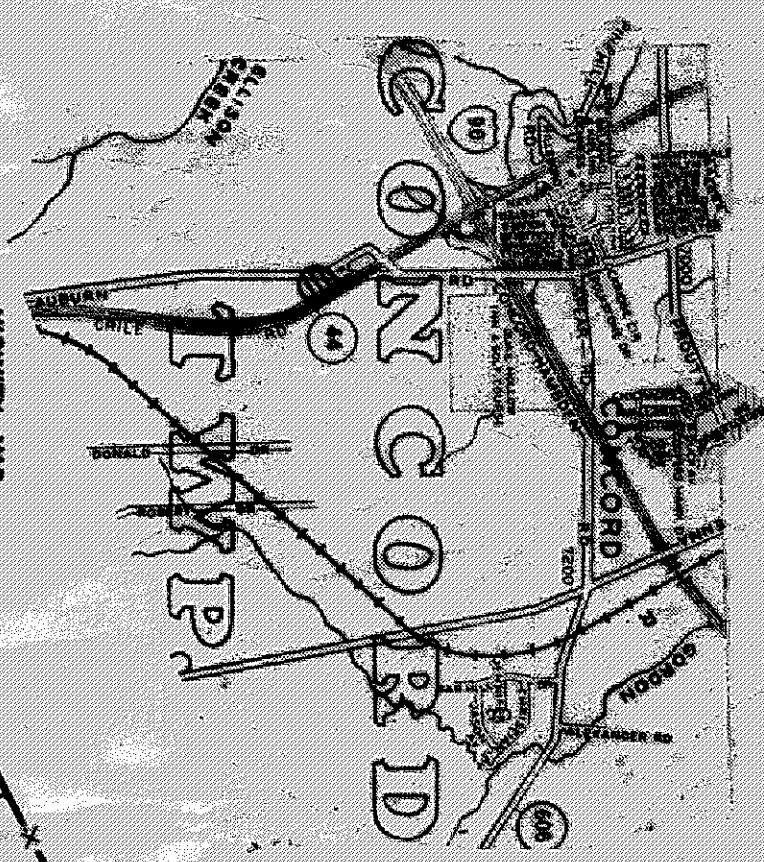


ROBERT KAMONICH
VOL. 623 PAGE 649

ALLEN L. & SIZEMAN LAWYERS
VOL. 41 PAGE 38

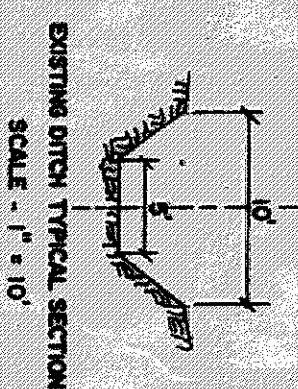

NOTE: DO NOT REMOVE
SWALE OR DITCH
UNTIL 4/10

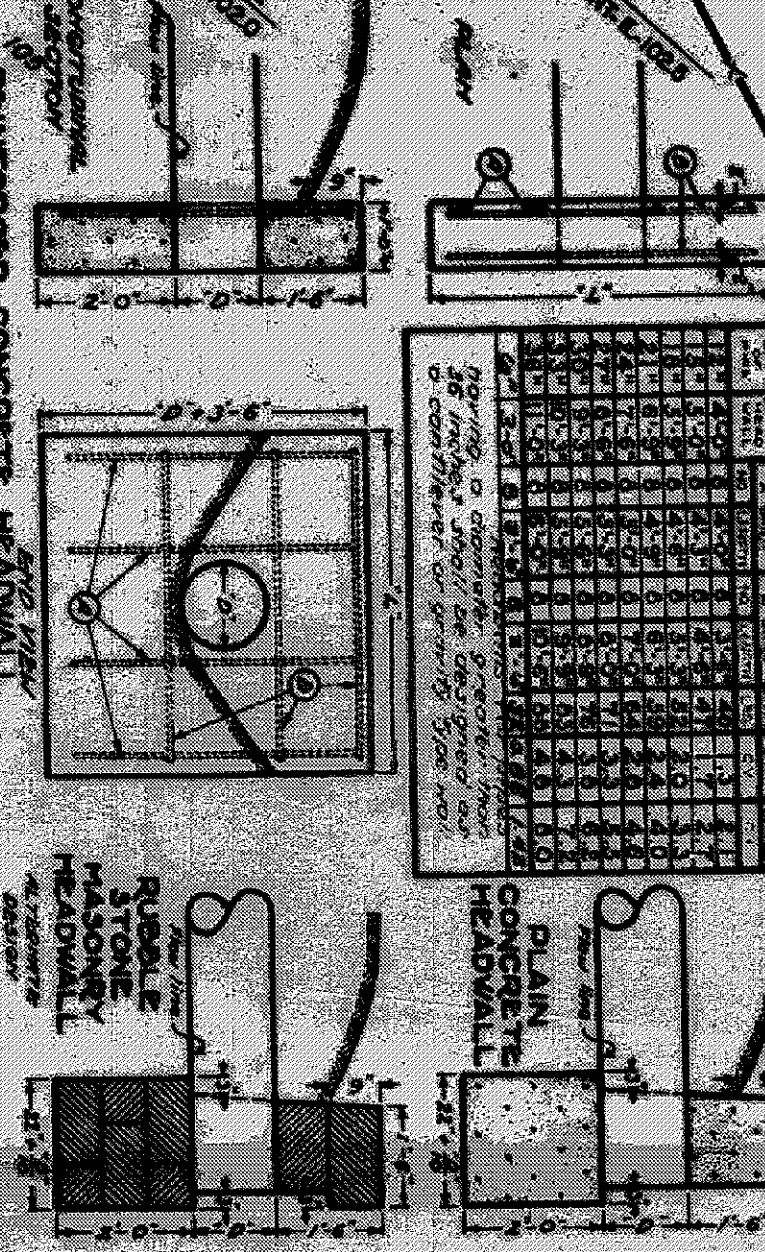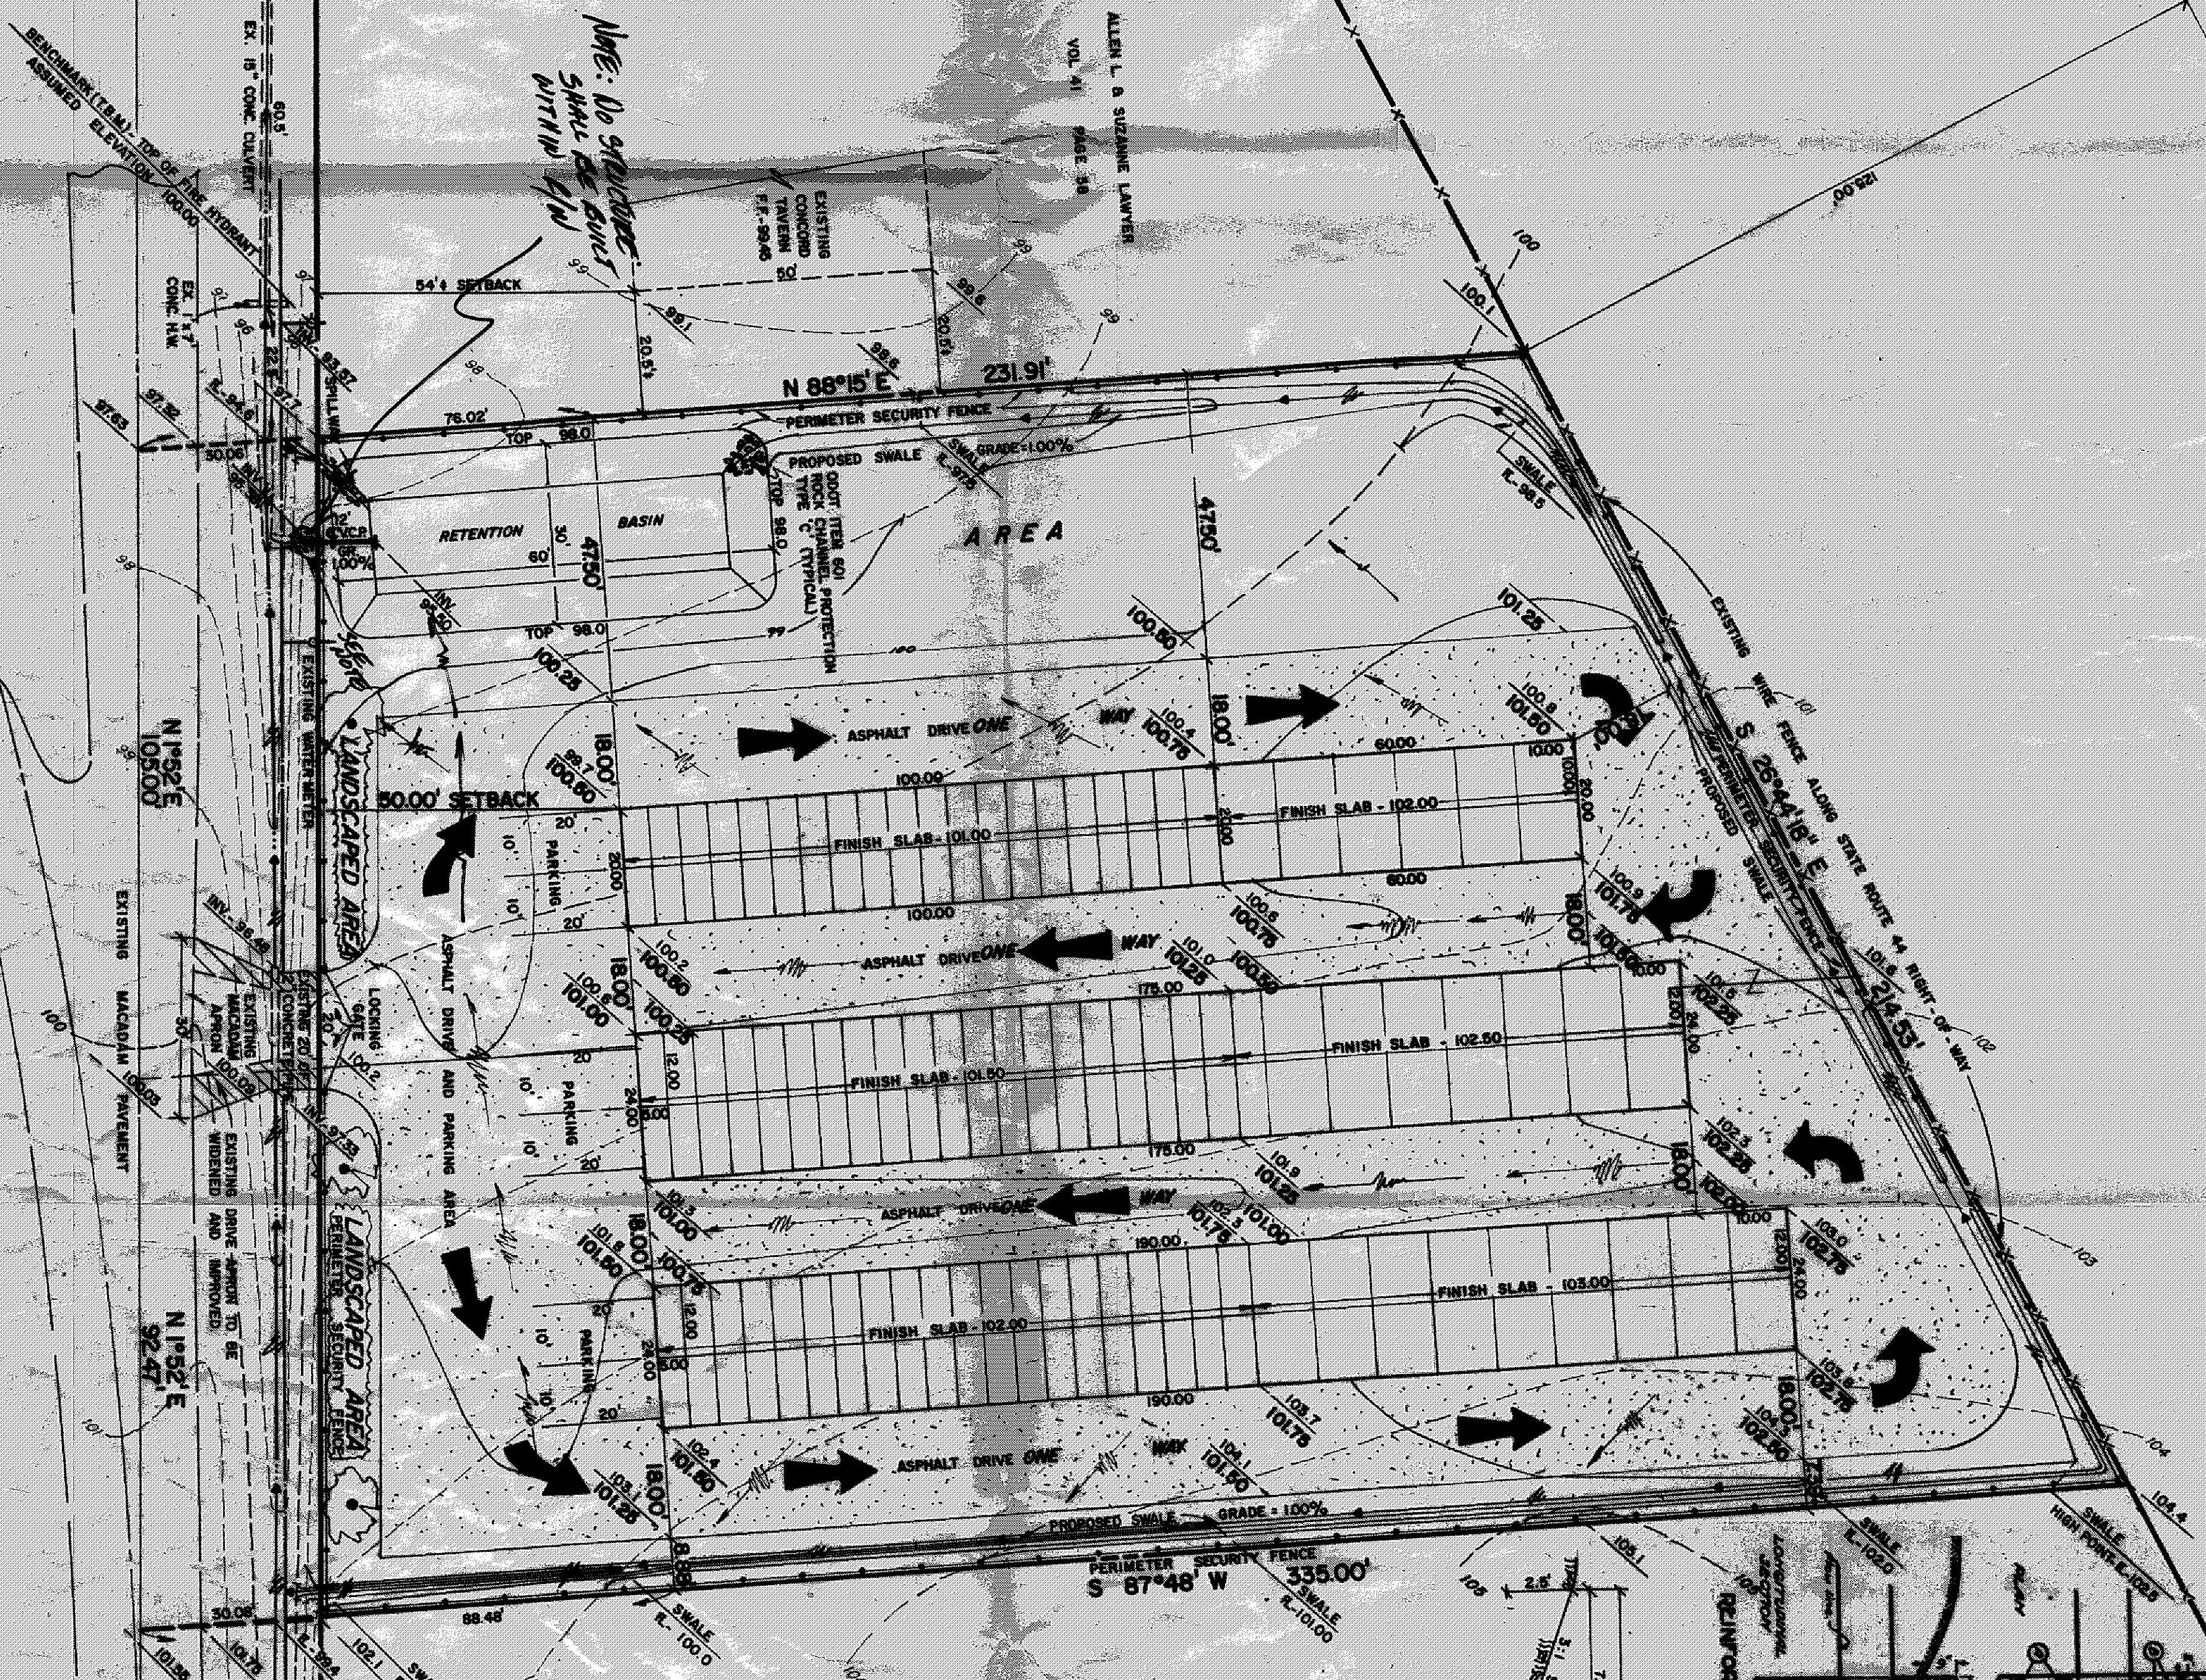

- GENERAL NOTES
- 1.1) NO RESTROOM FACILITIES WILL BE LOCATED ON-SITE.
 - 2.1) PROPOSED PERIMETER SECURITY FENCE TO BE INSTALLED 0.5 FEET INSIDE ALL PROPERTY LINES.
 - 3.1) PROPOSED SWALES TO BE CUT 5.0' INSIDE NORTH AND SOUTH PROPERTY LINES PER PLAN.




RETENTION BASIN X-SECTION
SCALE 1" = 5' VERTICAL & HORIZONTAL.

NOTE

EXISTING ELEVATION
PROPOSED ELEVATION

DIAMOND SHAMROCK CORPORATION
VOL. 632 PAGE 1352


DRIVE SECTION
NOT TO SCALE

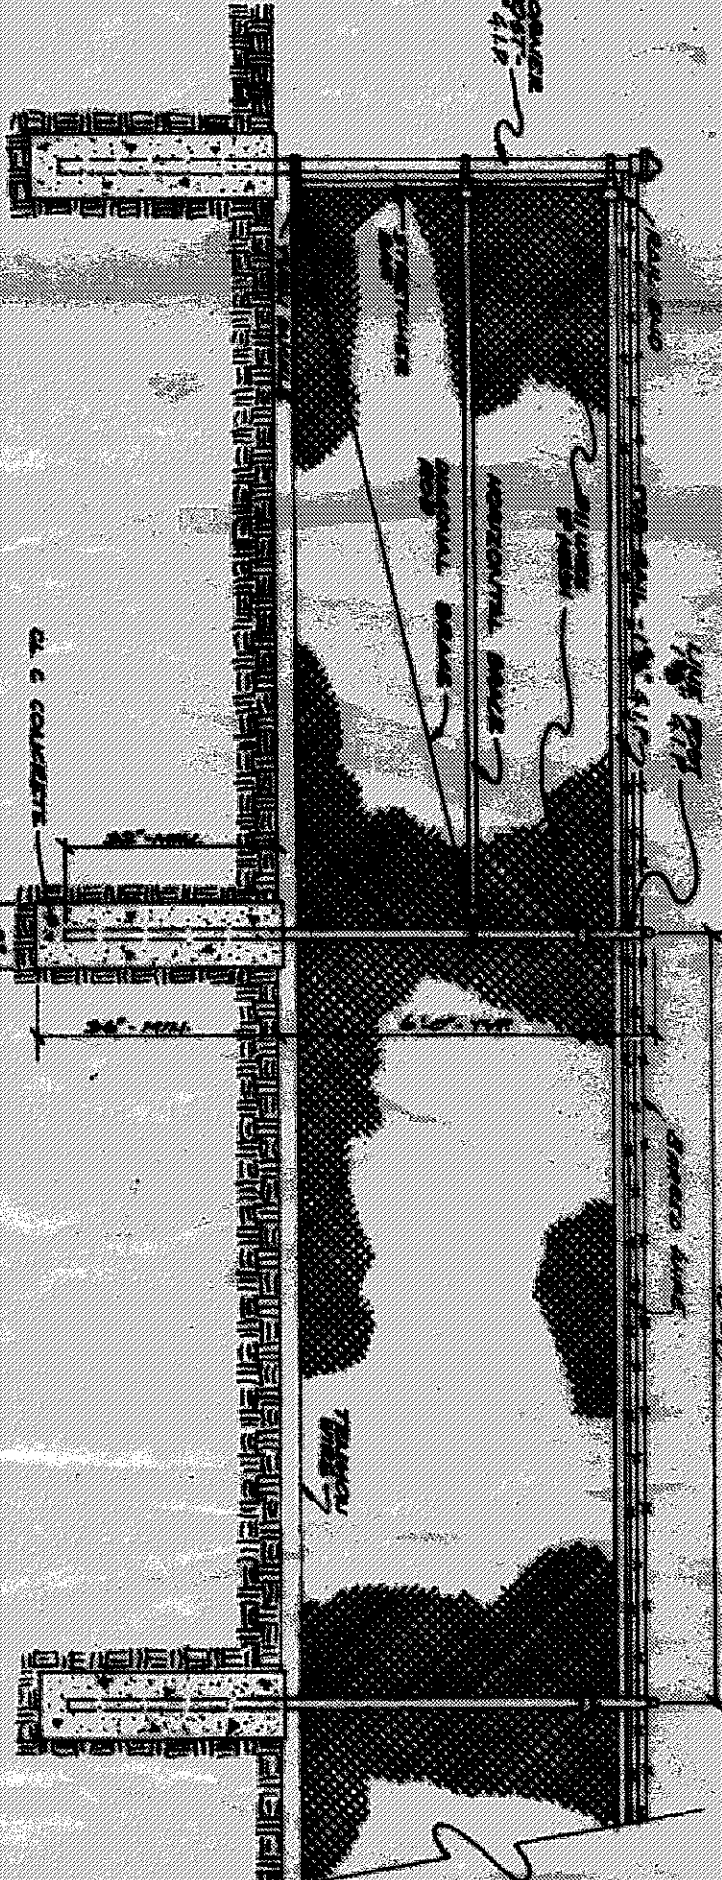

AUBURN ROAD 60'

NOTE: HORIZONTAL DISTANCES TO
BE WITHIN 1/8" TOLERANCE

Grading Plan Approved
as shown and/or noted
THOMAS P. GILLES, P.E.
Lake County Engineer
Date: 8-27-14

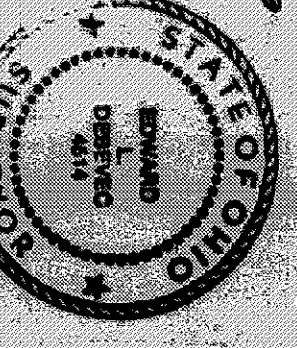

DEBEVEC, SAJO & ASSOCIATES, INC.
CIVIL ENGINEERS - SURVEYORS
PAINESVILLE, OHIO

CONCORD MINI-STORAGE - 7611 AUBURN ROAD
OWNER: DEMARI CORP

7959 RTE. 46 SOUTH, EAST ORWELL, O. 44024


REVISIONS	DATE	BY	CHKD BY	DATE
1.				
2.				
3.				

SCALE: 1" = 20'


FILE # 6290

W.O. # 6290

STATE ROUTE 44

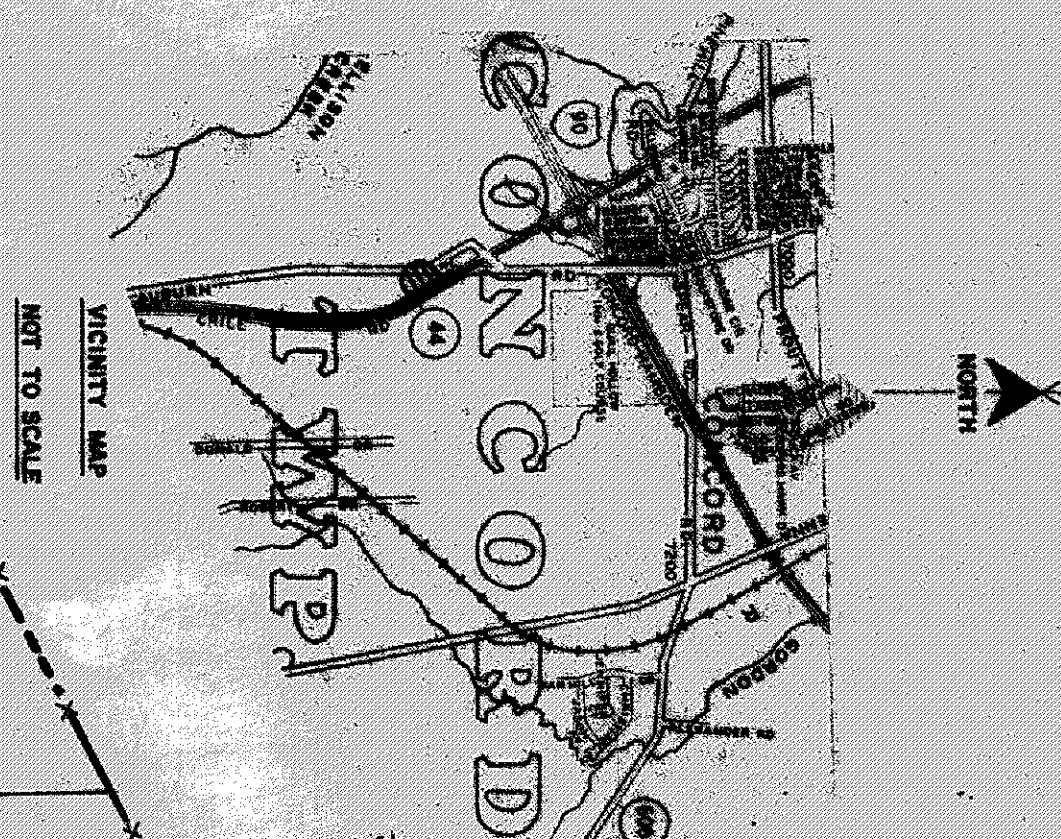

ROBERT RABOWICH
VOL. 828 PAGE 449

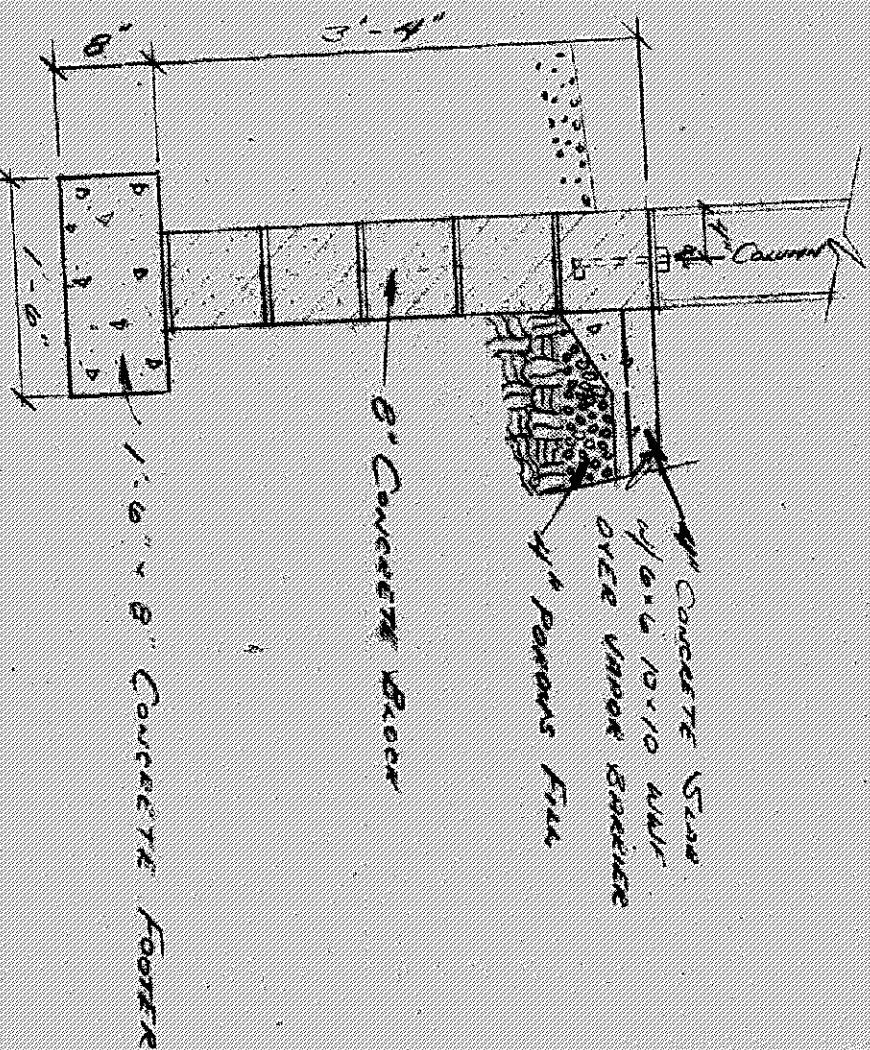


FOUNDATION DETAIL
SCALE 1/4" = 1'-0"
VOL. 822 PAGE 1352




- GENERAL NOTES
- 1.) NO RESTROOM FACILITIES WILL BE LOCATED ON-SITE.
 - 2.) PROPOSED PERIMETER SECURITY FENCE TO BE INSTALLED 0.5 FEET INSIDE ALL PROPERTY LINES.
 - 3.) PROPOSED SWALES TO BE CUT 5.0' INSIDE NORTH AND SOUTH PROPERTY LINES PER PLAN.

DRIVE SECTION
NOT TO SCALE

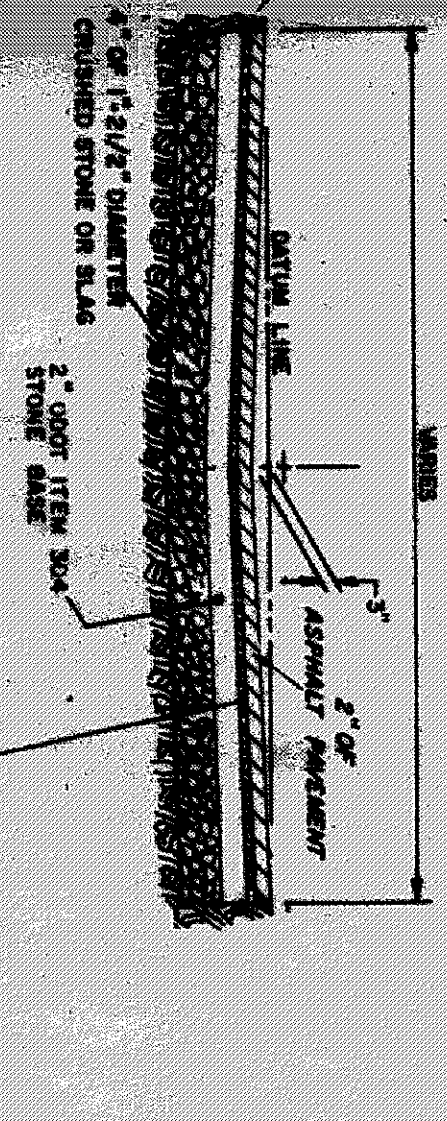


FENCE DETAIL
SCALE 1/2" = 1'-0"

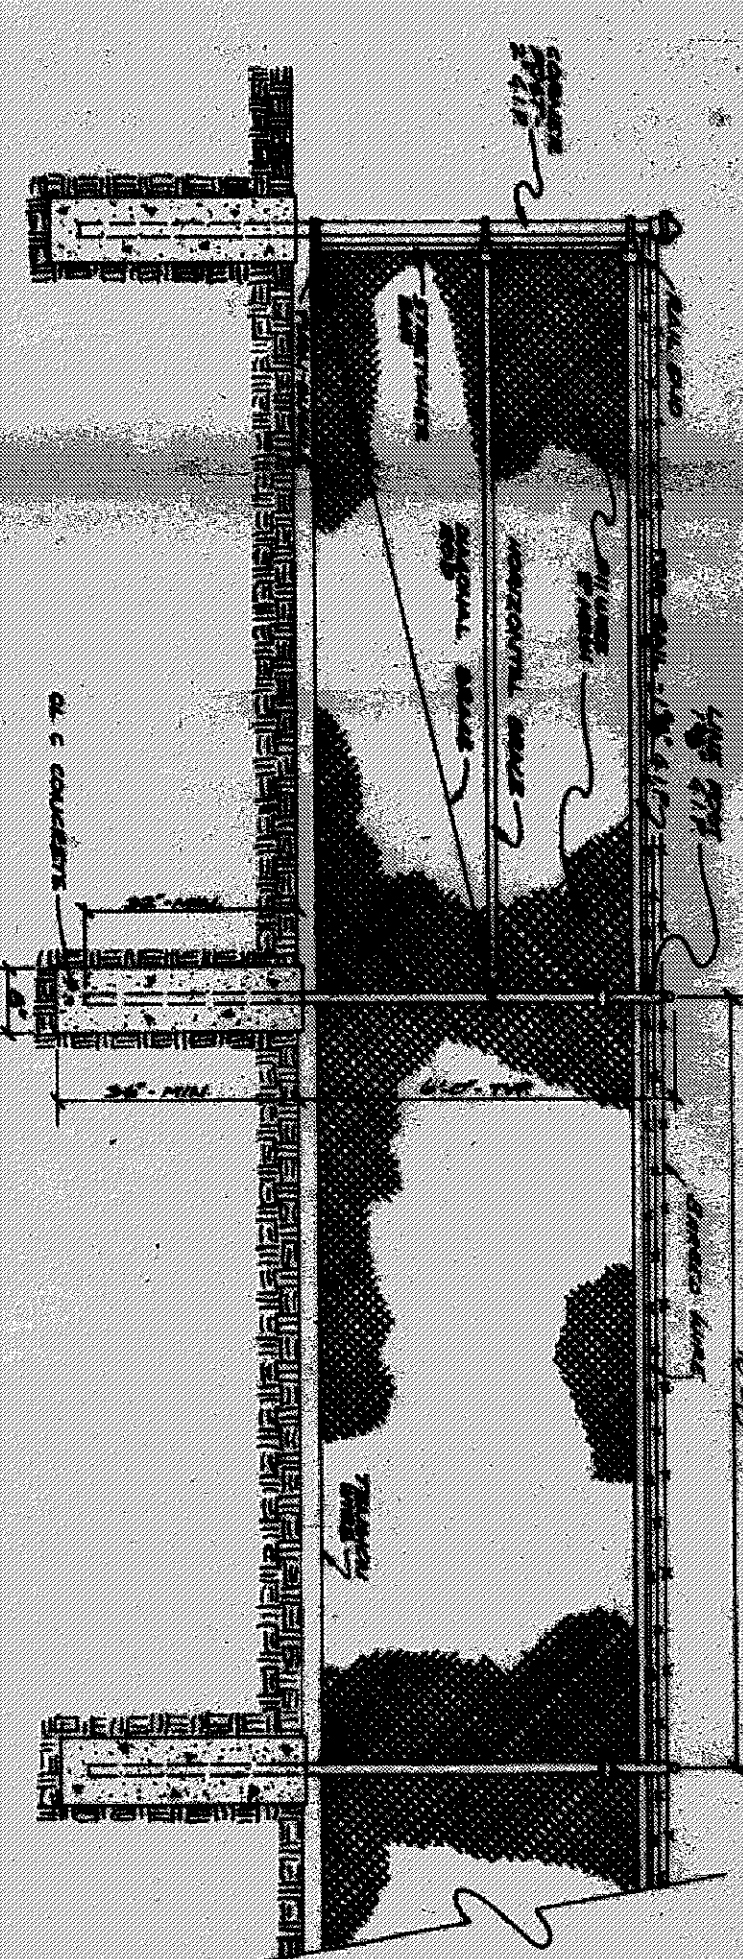

ZONING PERMIT #5084
ISSUED 8-16-95
SUBJECT TO APPROVAL BY:
Lake County Sanitary Eng. ☐
Lake County Eng. Dept. ☒
Lake County Planning Comm. ☐
Lake County Bldg. Dept. ☒
Tom A. Morano

AUBURN ROAD 60'

PRINTED
AUG 7 1995
DEBEVEC-SALO & ASSOCIATES, INC.

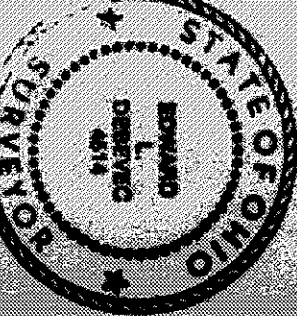

DEBEVEC-SALO & ASSOCIATES, INC.
CIVIL ENGINEERS & SURVEYORS
PAINESVILLE, OHIO
OWNER: BEHARI CORP.
7939 RTE. 46 SOUTH, EAST ORWELL, O. 44034

REVISIONS			
1	DATE	CHK'D BY	DATE
2	DATE	CHK'D BY	DATE
3	DATE	CHK'D BY	DATE
4	DATE	CHK'D BY	DATE

FILE # W.O. # 6290