GRAPHIC SCALE

0 10 20 40 80

(IN FEET)
1 inch = 20 ft.

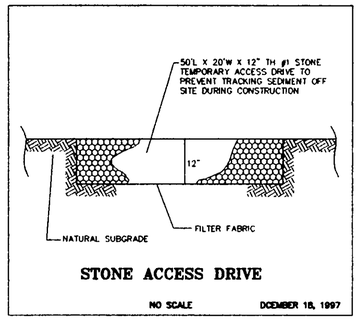

STONE ACCESS DRIVE

NO SCALE DCEMBER 18, 1997

NOTE: THE CONTRACTOR/BUILDER SHALL NOTIFY THE APPROVING ENGINEER IF GROUNDWATER IS OBSERVED DURING THE EXCAVATION OF THE BASEMENT.
- Contractor To Verify Depth And Location Of Utility Connections;
- See Architect Plans For Complete House Dimensions.

I, THE UNDERSIGNED, HEREBY CERTIFY THAT THIS TOPOGRAPHY, INDICATED BY 6", 1', OR 2' CONTOURS, AND ELEVATIONS SHOWN HEREON, REPRESENT AN ACTUAL FIELD SURVEY MADE BY ME ON THE 16th DAY OF NOVEMBER 2000 AND THAT THE ELEVATIONS WERE TAKEN AT APPROPRIATE INTERVALS AND THAT AS OF THAT DATE THEY EXISTED AS INDICATED HEREON.

Richard A. Thompson, Jr. P.S.7388

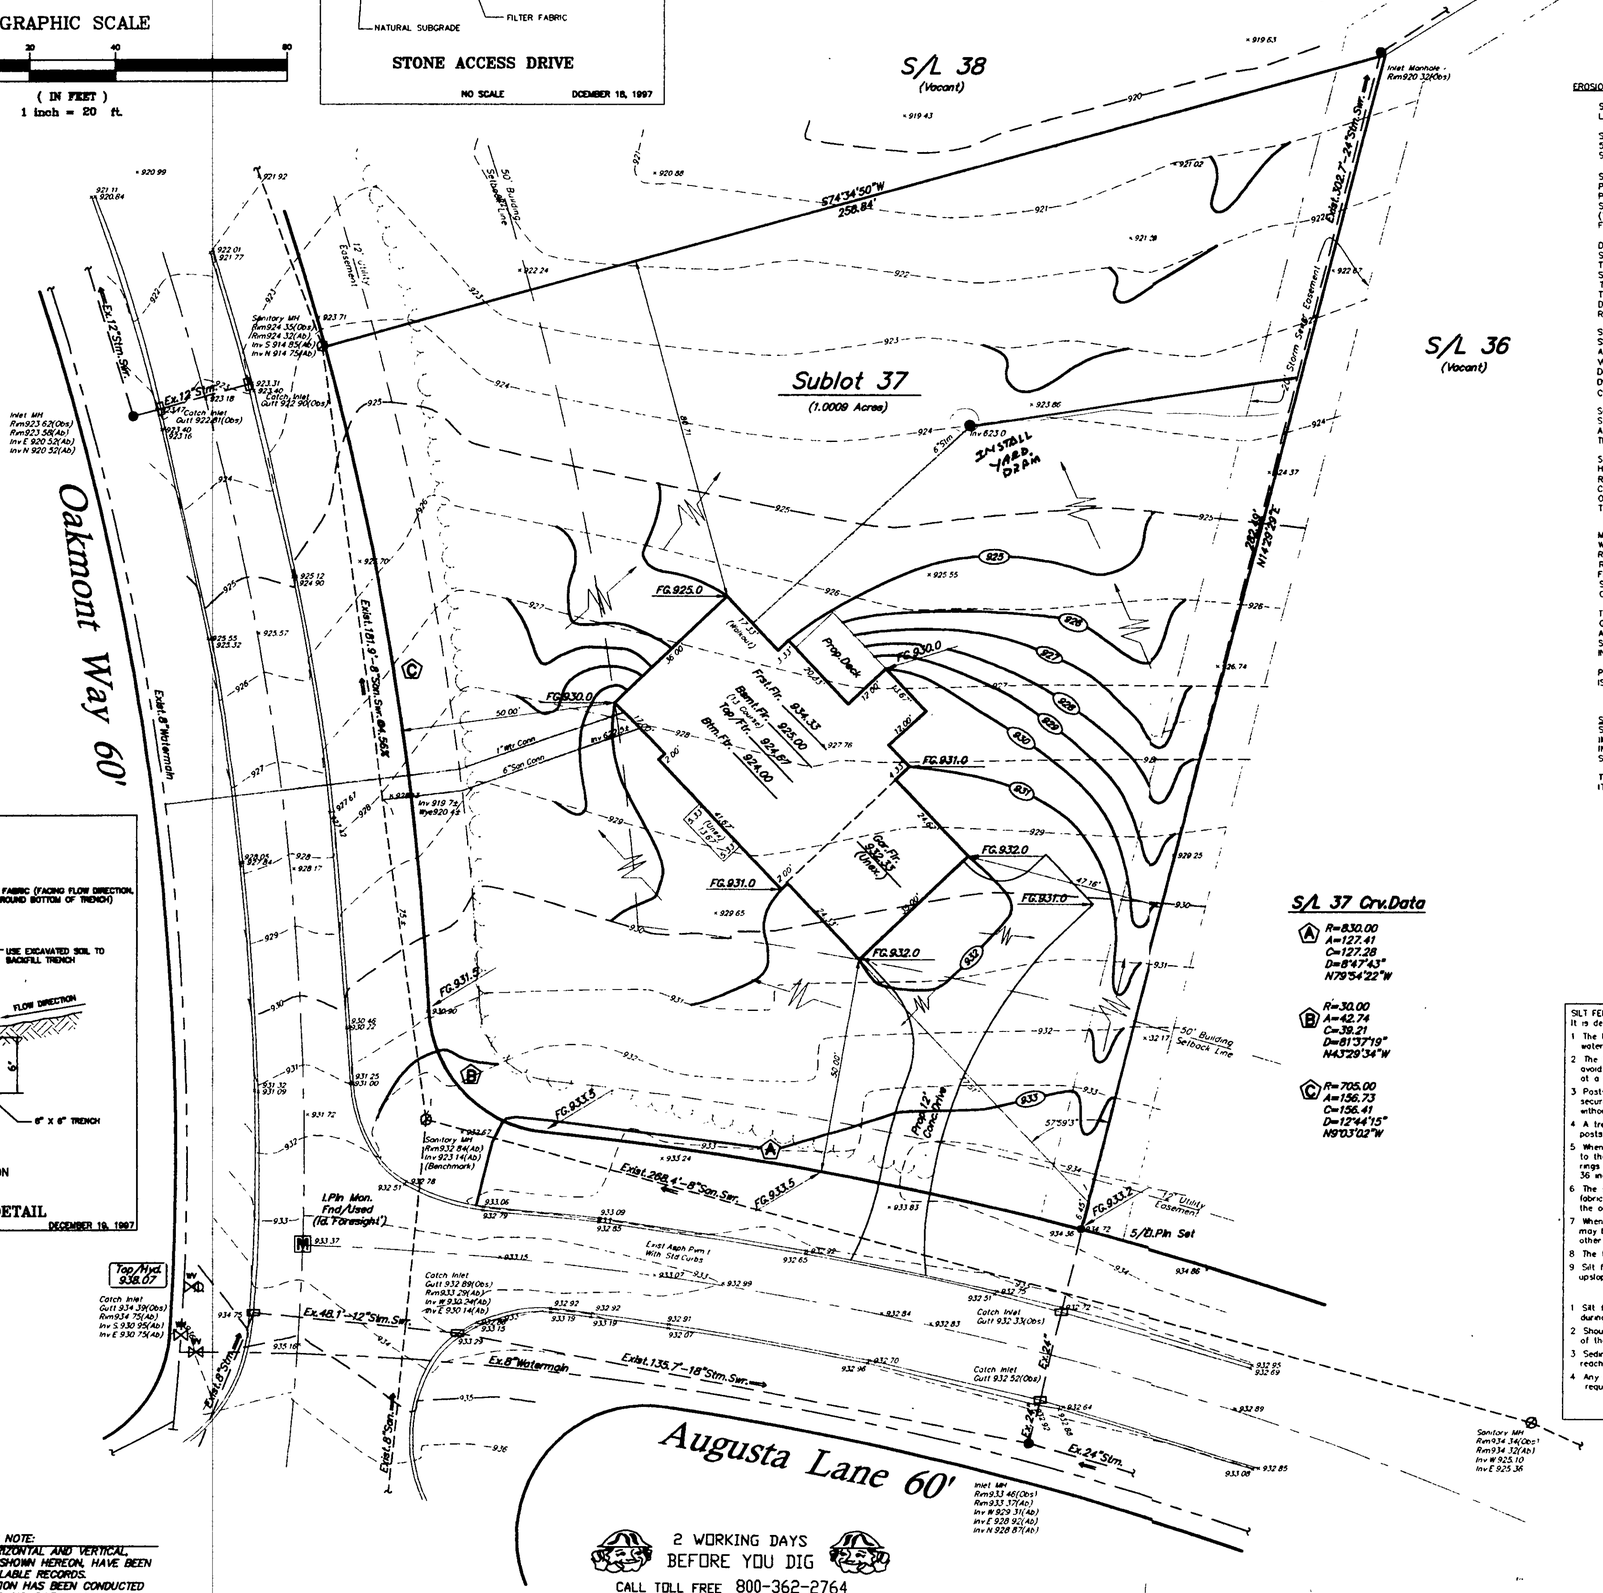

S/L 37 Crv.Data

(A) R=830.00
A=127.41
C=127.28
D=8°47'43"
N79°54'22"W

(B) R=30.00
A=42.74
C=39.21
D=81°37'19"
N43°29'34"W

(C) R=705.00
A=156.73
C=156.41
D=12°44'15"
N9°03'02"W

EROSION CONTROL PLAN & SCHEDULE

SILT FENCE TO BE INSTALLED PRIOR TO ANY EARTHWORK ACTIVITY, IN LOCATION SHOWN ON PLANS, PER DETAIL

STONE SHALL BE INSTALLED IN FUTURE DRIVEWAY AREA 20 FEET WIDE AND 50 FEET LONG TO PREVENT VEHICLES FROM TRACKING SEDIMENT OFF THIS SITE INGRESS AND EGRESS TO BE LIMITED TO THIS AREA ONLY

SEDIMENT CONTROL PRACTICES SHALL BE FUNCTIONAL THROUGHOUT ALL PHASES OF EARTH DISTURBING ACTIVITY SETTLING FACILITIES, PERIMETER CONTROLS, AND OTHER PRACTICES INTENDED TO TRAP SEDIMENT SHALL BE IMPLEMENTED AS THE FIRST STEP OF GRADING AND WITHIN SEVEN (7) DAYS FROM THE START OF GRUBBING. THEY SHALL CONTINUE TO FUNCTION UNTIL THE DISTURBED AREA IS PERMANENTLY RESTABILIZED

DISTURBED AREAS SHALL HAVE SOIL STABILIZATION WITHIN NO MORE THAN SEVEN (7) DAYS IF THEY ARE TO REMAIN DORMANT UNDISTURBED FOR MORE THAN THIRTY-FIVE (35) DAYS PERMANENT OR TEMPORARY SOIL STABILIZATION SHALL BE APPLIED TO DISTURBED AREAS WITHIN NO MORE THAN SEVEN (7) DAYS AFTER FINAL GRADE IS REACHED ON ANY PORTION OF THE SITE, AND SHALL ALSO BE APPLIED WITHIN NO MORE THAN SEVEN (7) DAYS TO DISTURBED AREAS WHICH MAY NOT BE AT FINAL GRADE, BUT WILL REMAIN DORMANT FOR LONGER THAN THIRTY-FIVE (35) DAYS

STABILIZATION OF CRITCAL AREAS WITHIN 50 FEET OF ANY STREAM OR WETLAND SHALL BE TEMPORARILY STABILIZED WITHIN TWO (2) DAYS OF DISTURBANCE IF AREA WILL REMAIN INACTIVE FOR FOURTEEN (14) DAYS OR LONGER CONSTRUCTION VEHICLES SHALL AVOID STREAMS AND THEIR BUFFER AREAS IF ANY ACTIVE DRAINAGE WAY MUST BE CROSSED BY CONSTRUCTION VEHICLES REPEATEDLY DURING CONSTRUCTION, AN APPROVED TEMPORARY STREAM CROSSING SHALL BE CONSTRUCTED

SOIL STOCKPILES SHALL BE STABILIZED OR PROTECTED TO PREVENT SOIL LOSS STABILIZATION SHALL BE REQUIRED IF STOCKPILES ARE LOCATED WITHIN CRITICAL AREAS NEAR STREAM OR WETLANDS, OR IF DETERMINED BY THE ADMINISTRATOR THAT SEDIMENT FROM STOCKPILES WILL LEAVE THE SITE

SEDIMENT AND EROSION CONTROLS SHALL BE INSPECTED BY THE OWNER OR HIS/HER AGENT EVERY SEVEN (7) DAYS AND WITHIN 24 HOURS OF A 0.5" OR GREATER RAINFALL EVENT A WRITTEN LOG OF THESE INSPECTIONS AND IMPROVEMENTS TO CONTROLS SHALL BE KEPT ON SITE THESE INSPECTIONS SHALL INCLUDE THE DATE OF INSPECTION, NAME OF INSPECTOR, WEATHER CONDITIONS, THE ACTIONS TAKEN TO CORRECT ANY PROBLEMS AND THE DATE ACTIONS WERE TAKEN

MEASURES SHALL BE TAKEN TO PREVENT SOIL TRANSPORT ONTO SURFACES WHERE RUNOFF IS NOT CHECKED BY SEDIMENT CONTROLS, OR ONTO PUBLIC ROADS WHERE SOIL IS TRANSPORTED ONTO A PUBLIC ROAD SURFACE, THE ROADS SHALL BE CLEANED THOROUGHLY AT THE END OF EACH DAY, OR MORE FREQUENTLY AS NECESSARY SOIL SHALL BE REMOVED FROM PAVED SURFACES BY SHOVELING OR SWEEPING STREET WASHING SHALL BE ALLOWED ONLY AFTER MOST SEDIMENT HAS BEEN REMOVED BY SHOVELING OR SWEEPING

THE ABOVE SPECIFIED EROSION CONTROL STANDARDS ARE GENERAL GUIDELINES AND SHALL NOT LIMIT THE RIGHT OF THE COUNTY TO IMPOSE, AT ANY TIME, ADDITIONAL MORE STRINGENT REQUIREMENTS, NOR SHALL THE STANDARDS LIMIT THE RIGHT OF THE COUNTY TO WAIVE, IN WRITING, INDIVIDUAL REQUIREMENTS

PERMANENT SEEDING TO BE INSTALLED AFTER ALL CONSTRUCTION ACTIVITY IS COMPLETE

SEEDING AND MULCHING NOTES
SEDIMENT CONTROL SHALL BE ACCOMPLISHED BY SEEDING AND MULCHING IMMEDIATELY UPON COMPLETION OF EXCAVATION OF FILL AND FINISHED GRADING IN ACCORDANCE WITH ITEM NO 659 ODOT CONSTRUCTION AND MATERIAL SPECIFICATIONS OR AS DIRECTED BY THE ENGINEER

THE FOLLOWING MIXTURE SHALL BE USED FOR SEEDING IN ACCORDANCE WITH ODOT ITEM 659

KENTUCKY BLUE GRASS- 40%
CREEPING RED FESCUE- 40% 3#/ 1000 S F
PERENNIAL RYEGRASS- 20%
FERTILIZER- 20#/ 1000 S F (12-12-12)
MULCH-STRAW/ 3 TONS/ ACRE

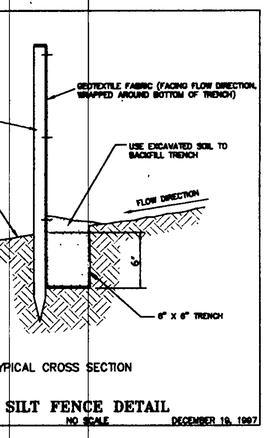

YPICAL CROSS SECTION

SILT FENCE DETAIL

NO SCALE DECEMBER 18, 1997

SILT FENCE This sediment barrier utilizes standard strenght or extra strength synthetic filter fabrics It is designed for situations in which only sheet or overland flows are expected, See diagram

1 The height of a silt fence shall not exceed 36 inches (Higher fences may impound volumes of water sufficient to cause failure of the structure.)
2 The filter fabric shall be purchased in a continuous roll cut to the length of the barrier to avoid the use of joint When joints are necessary, filter cloth shall be spliced together only at a support post with a minimum 6-inch overlap, and securely sealed
3 Posts shall be spaced a maximum of 10 feet apart at the barrier location and driven securely into the ground (minimum of 12 inches) When extra strength fabric is used without the wire support fence, Post spacing shall not exceed 6 feet
4 A trench shall be excavated approximately 4 inches wide and 4 inches deep along the line of posts and upslopeed from the barrier
5 When standard strength filter fabric is used, a wire mesh support fence shall be fastened securely to the upslope side of the posts using heavy duty wire staples at least 1 inch long, tie wires of hog rings The wire shall extened into the trench a minimum of 2 inches and shall lot extend more than 36 inches above the original ground surface
6 The standard strength filter fabric shall be stapgled or wired to the fence, and 8 inches of the fabric shall be extended into the trench The fabric shall no exceed more than 38 inches above the original ground surface Filter fabric shall not be stapled to the existing trees
7 When extra strength filter fabric and closer post spacing are used, the wire mesh support fence may be eleminated In such case, the filter fabric is stapled or wired directly to the posts with all other provisions of item No 6 applyng
8 The trench shall be backfilled and soil compacted over the filter fabric
9 Silt fences shall be removed when they have served their usefull purpose, but not before the upslope area has been permantly stabilized

MAINTENANCE

1 Silt fences and filter barriers shall be inspected immediately after each rainfall and at least daily during prlonged rainfall Any required repairs shall be made immediatly
2 Should the fabric on a silt fence of filter barrier decompose or become ineffective prior to the end of the expeced usuable life and the barrier is still necessary, the fabric shall je replaced promptly
3 Sediment deposits should be remove after each storm event They must be removed when deposits reach approximatly one-half the height of the barrier
4 Any sediment deposits remaining in place after the silt fence or filter barrir is no longer required shall be dressed to conform with the existing grade, prepared and seeded

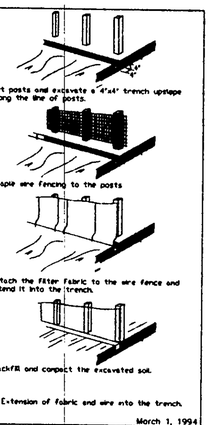

SILT FENCE

NO SCALE March 1, 1994

CONCORD TOWNSHIP ZONING OFFICE

ZONING PERMIT # 6101-10016

ISSUED 01-18-01

SUBJECT TO APPROVAL BY:

- ☑ Lake Co. Sanitary Engineer
- ☐ Lake Co. Eng. Dept.
- ☐ Lake Co. Planning Comm.
- ☑ Lake Co. Building Dept.
- ☑ Lake Co. Soil & Water Cons. Dist.

UNDERGROUND UTILITIES NOTE:
THE LOCATION, BOTH HORIZONTAL AND VERTICAL, OF UNDERGROUND UTILITIES SHOWN HEREON, HAVE BEEN DETERMINED BY A SEARCH OF AVAILABLE RECORDS. EXCEPT WHERE SUCH INFORMATION HAS BEEN CONFIRMED BY FIELD OBSERVATION HAS BEEN CONDUCTED BY THE APPROPRIATE UTILITY COMPANIES. HOWEVER, LDC INC. DOES NOT GUARANTEE THE COMPLETENESS NOR ACCURACY THEREOF.

2 WORKING DAYS BEFORE YOU DIG

CALL TOLL FREE 800-362-2764

OHIO UTILITIES PROTECTION SERVICE

SITE PLA

For : Hanna Homes
CLIENT

ADDRESS STREET

37 SUBLOT No. Little Mountain Country SUBDIVISION NAME

LOT TRACT Concord CITY/TOWNSHIP

L.D.C. Inc. d.b.a. LAND DESIGN con
Civil Engineers and Surv
6686 EAST AVENUE · MENTOR, OHIO
TELEPHONE 255-8483 354-6838

Prepared By:

DESIGN CERTIFICAT

THIS PLAN WAS PREPARED BY ME, AND I BEST OF MY KNOWLEDGE AND BELIEF.

NAME 12/12/

CHECK LIST

LOT DIMENSIONS & BEARINGS
ST. TO NEAREST STREET
SUBLOT No. (TRACT, No.)
EXISTING STRUCTURES
BUILDING LINES
SETBACKS: FRONT, REAR/YARD
PROPOSED STRUCTURES
CURB & APRON TYPE, WIDTH, THICKNESS
DRIVEWAY TYPE, WIDTH, THICKNESS
WATER MAIN SIZE, LOCATION
SANITARY SEWER SIZE, LOCATION
SAN. SEW. CLASS REQ. INV. ELEV.
STORM SEWER SIZE, LOCATION
STORM SEW. CLASS REQ. INV. ELEV.
PAVT TYP, GRADE, CURB
GAS LINE LOC. SIZE
SEPTIC SYSTEM & SUPLICATION
WELL LOCATION & ISOLATION RADIUS

"AS BUILT" CERTIFICA

I HEREBY CERTIFY THAT THE CIRCLED INF EXISTING AS OBTAINED ON THE SITE AND IS CORRECT TO THE BEST OF MY KN AND BELIEF.

NAME

LEGEND	DRAWN BY
STORM MANHOLE	G.S.V.
SANITARY MANHOLE	CHK'D BY/FI
EXISTING CONTOURS	R.A.T.
PROPOSED CONTOURS	
EXIST. ELEV. 100.0	1 Site/G
F.G.100.0 = PROP. ELEV.	2
DIRECTION OF SURFACE DRAINAGE	

ACCEPTED: CLIENT

BENCHMARK: B.M.=Invert of Existin Located At The Oakmont Way & Invert Elev..... (Per 'As-Built' Prepared By Fo Group, Dated 9-

T.B.M. Set On Top Of At The Intersa Way & Augusa Elev.....

Grading Pl as shown JAMES R. Lake Coun

By

Install yard Example show

ROOF SHALL D TO SPLASI