

N 46°48'51" W
S/L # 2
VACANT

CURVE DATA R/W
Δ = 92°00'00"
R = 75.00'
T = 71.71'
L = 120.43'
C = 107.90'
N 25°41'00" E

426.61'

S 49°20'03" W
50.00'

237.81'

S 30°17'20" W



ZONING PERMIT B5516-8451
ISSUED 4/28/96
SUBJECT TO APPROVAL BY:
Lake County Sanitary Eng. ☐
Lake County Eng. Dept. ☒
Lake County Planning Comm. ☐
Lake County Bldg. Dept. ☐

A yard drain must be installed before a septic permit will be issued.

N 53°23'22" W

S/L # 4
VACANT

379.94'

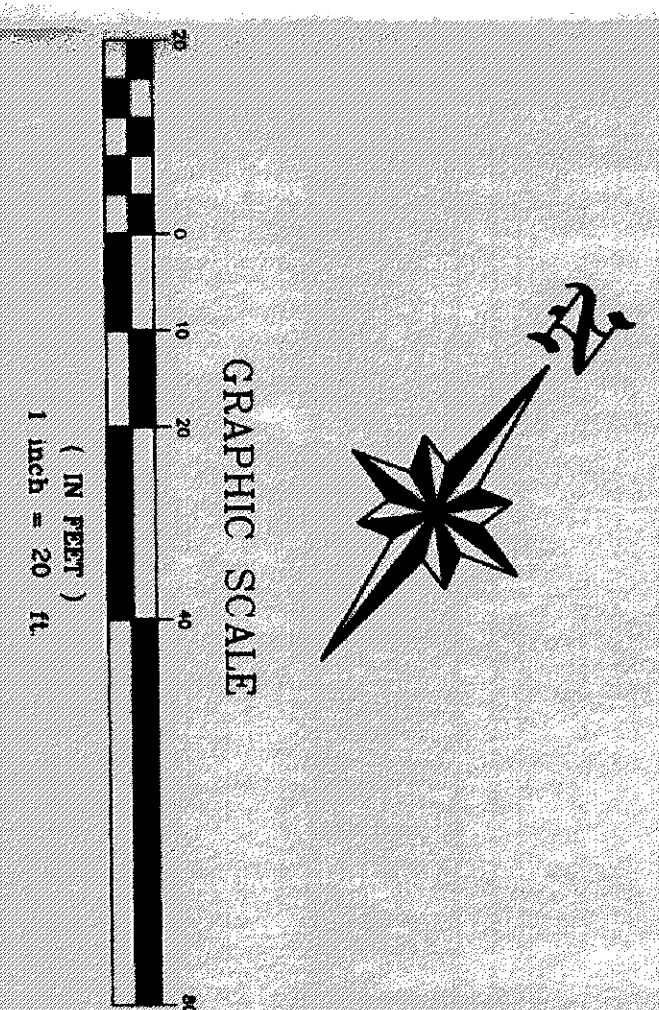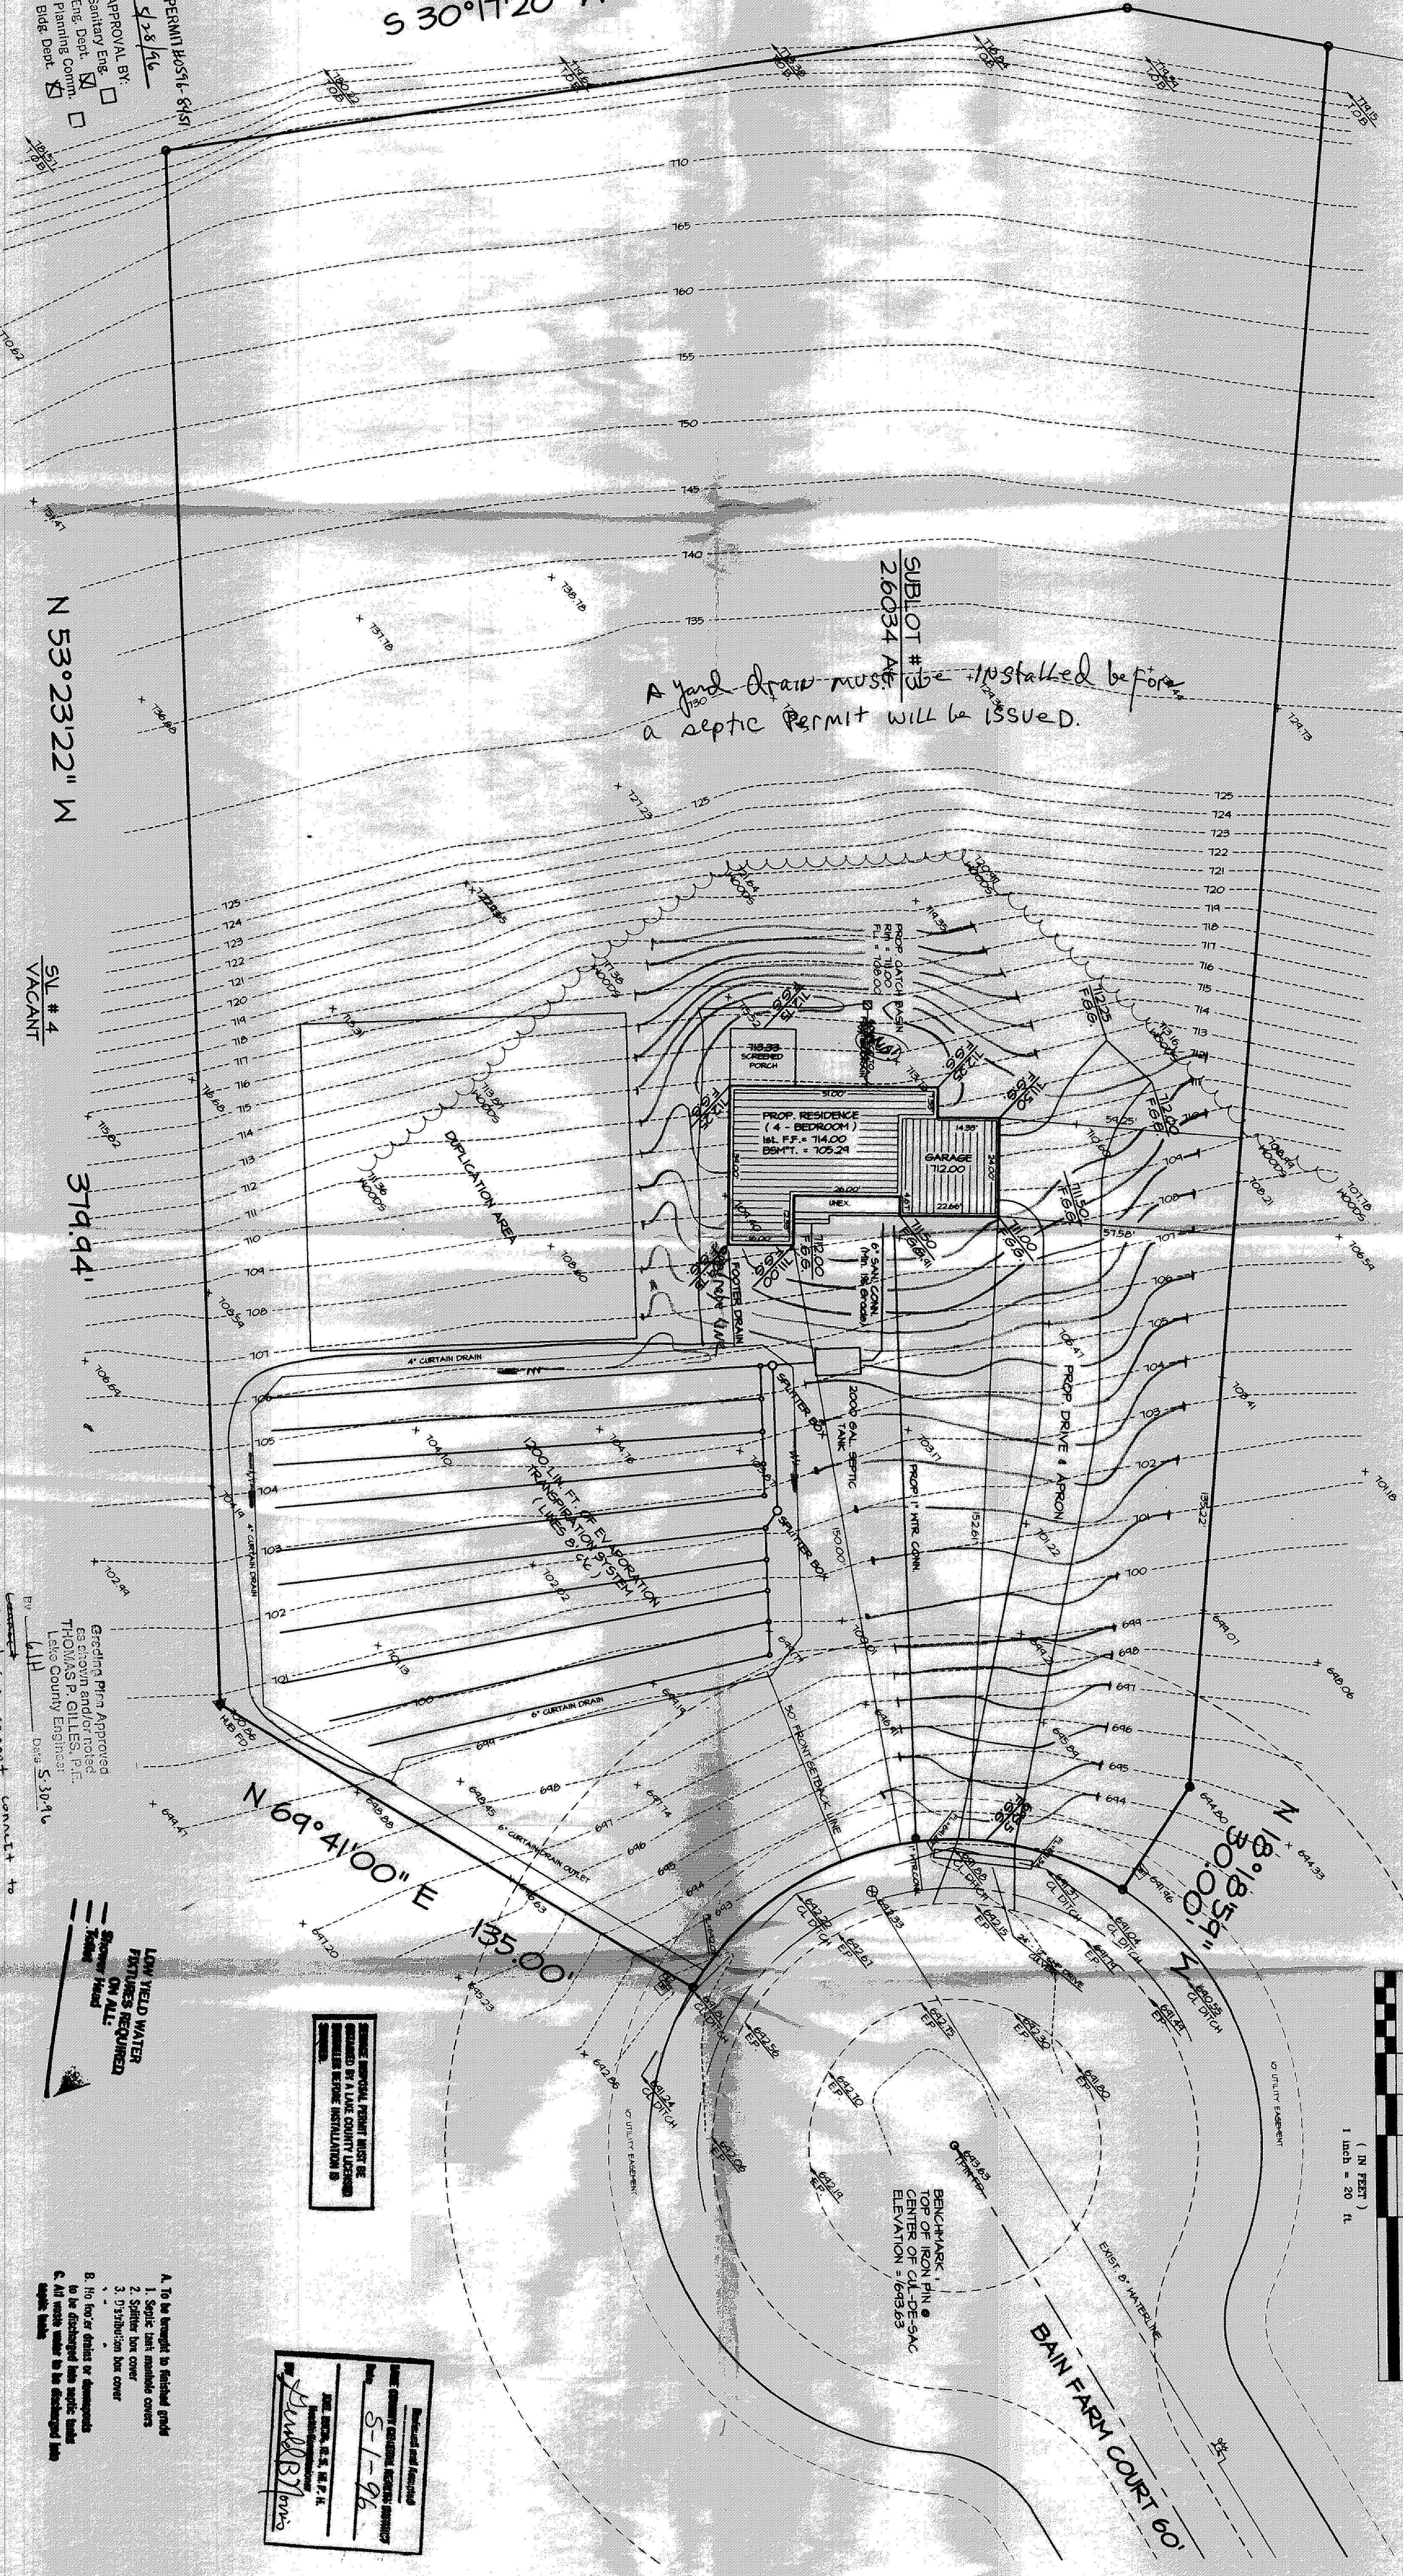

SEPTIC PERMIT MUST BE OBTAINED BY LAKE COUNTY ENGINEER BEFORE INSTALLATION IS ALLOWED

Revised and Resubmitted
LAKE COUNTY ENGINEER'S OFFICE
Date: 5-1-96
JIM ANON, E.S., M.E., P.E.
Professional Engineer
by: David B. Jones

LOW YIELD WATER
PROTECTORS REQUIRED
ON ALL


ROOF DRAINS
SHALL DISCHARGE
TO SPLASH BLOCKS.

REV. PER LAKE COUNTY HEALTH DEPT.
4. SLOPED CURTAIN DRAIN
LAKE INC. APRIL 28/1996



Rev. No.	Description	Date	By	CHK'D

SITE PLAN for
SIGNATURE HOMES, Inc.

Drawn By: D. Abbott
Filename: #05-204-95-204
Checked By:
Approved By:

S/L # 3

Scale:	Horiz. 1" = 20'
	Vert. 1" = 20'
Sheet No.	Of
1	2