SITE PLAN

FOR

TOM REED

7220 PAINESVILLE-RAVENNA RD.
CONCORD TWP.

BEING PART OF LOTS NOS. 14 & 15, TRACT 1, CONCORD TOWNSHIP, LAKE COUNTY, STATE OF OHIO. PERMANENT PARCEL NOS. 315-10-56 & 57

SCALE: 1" = 40'

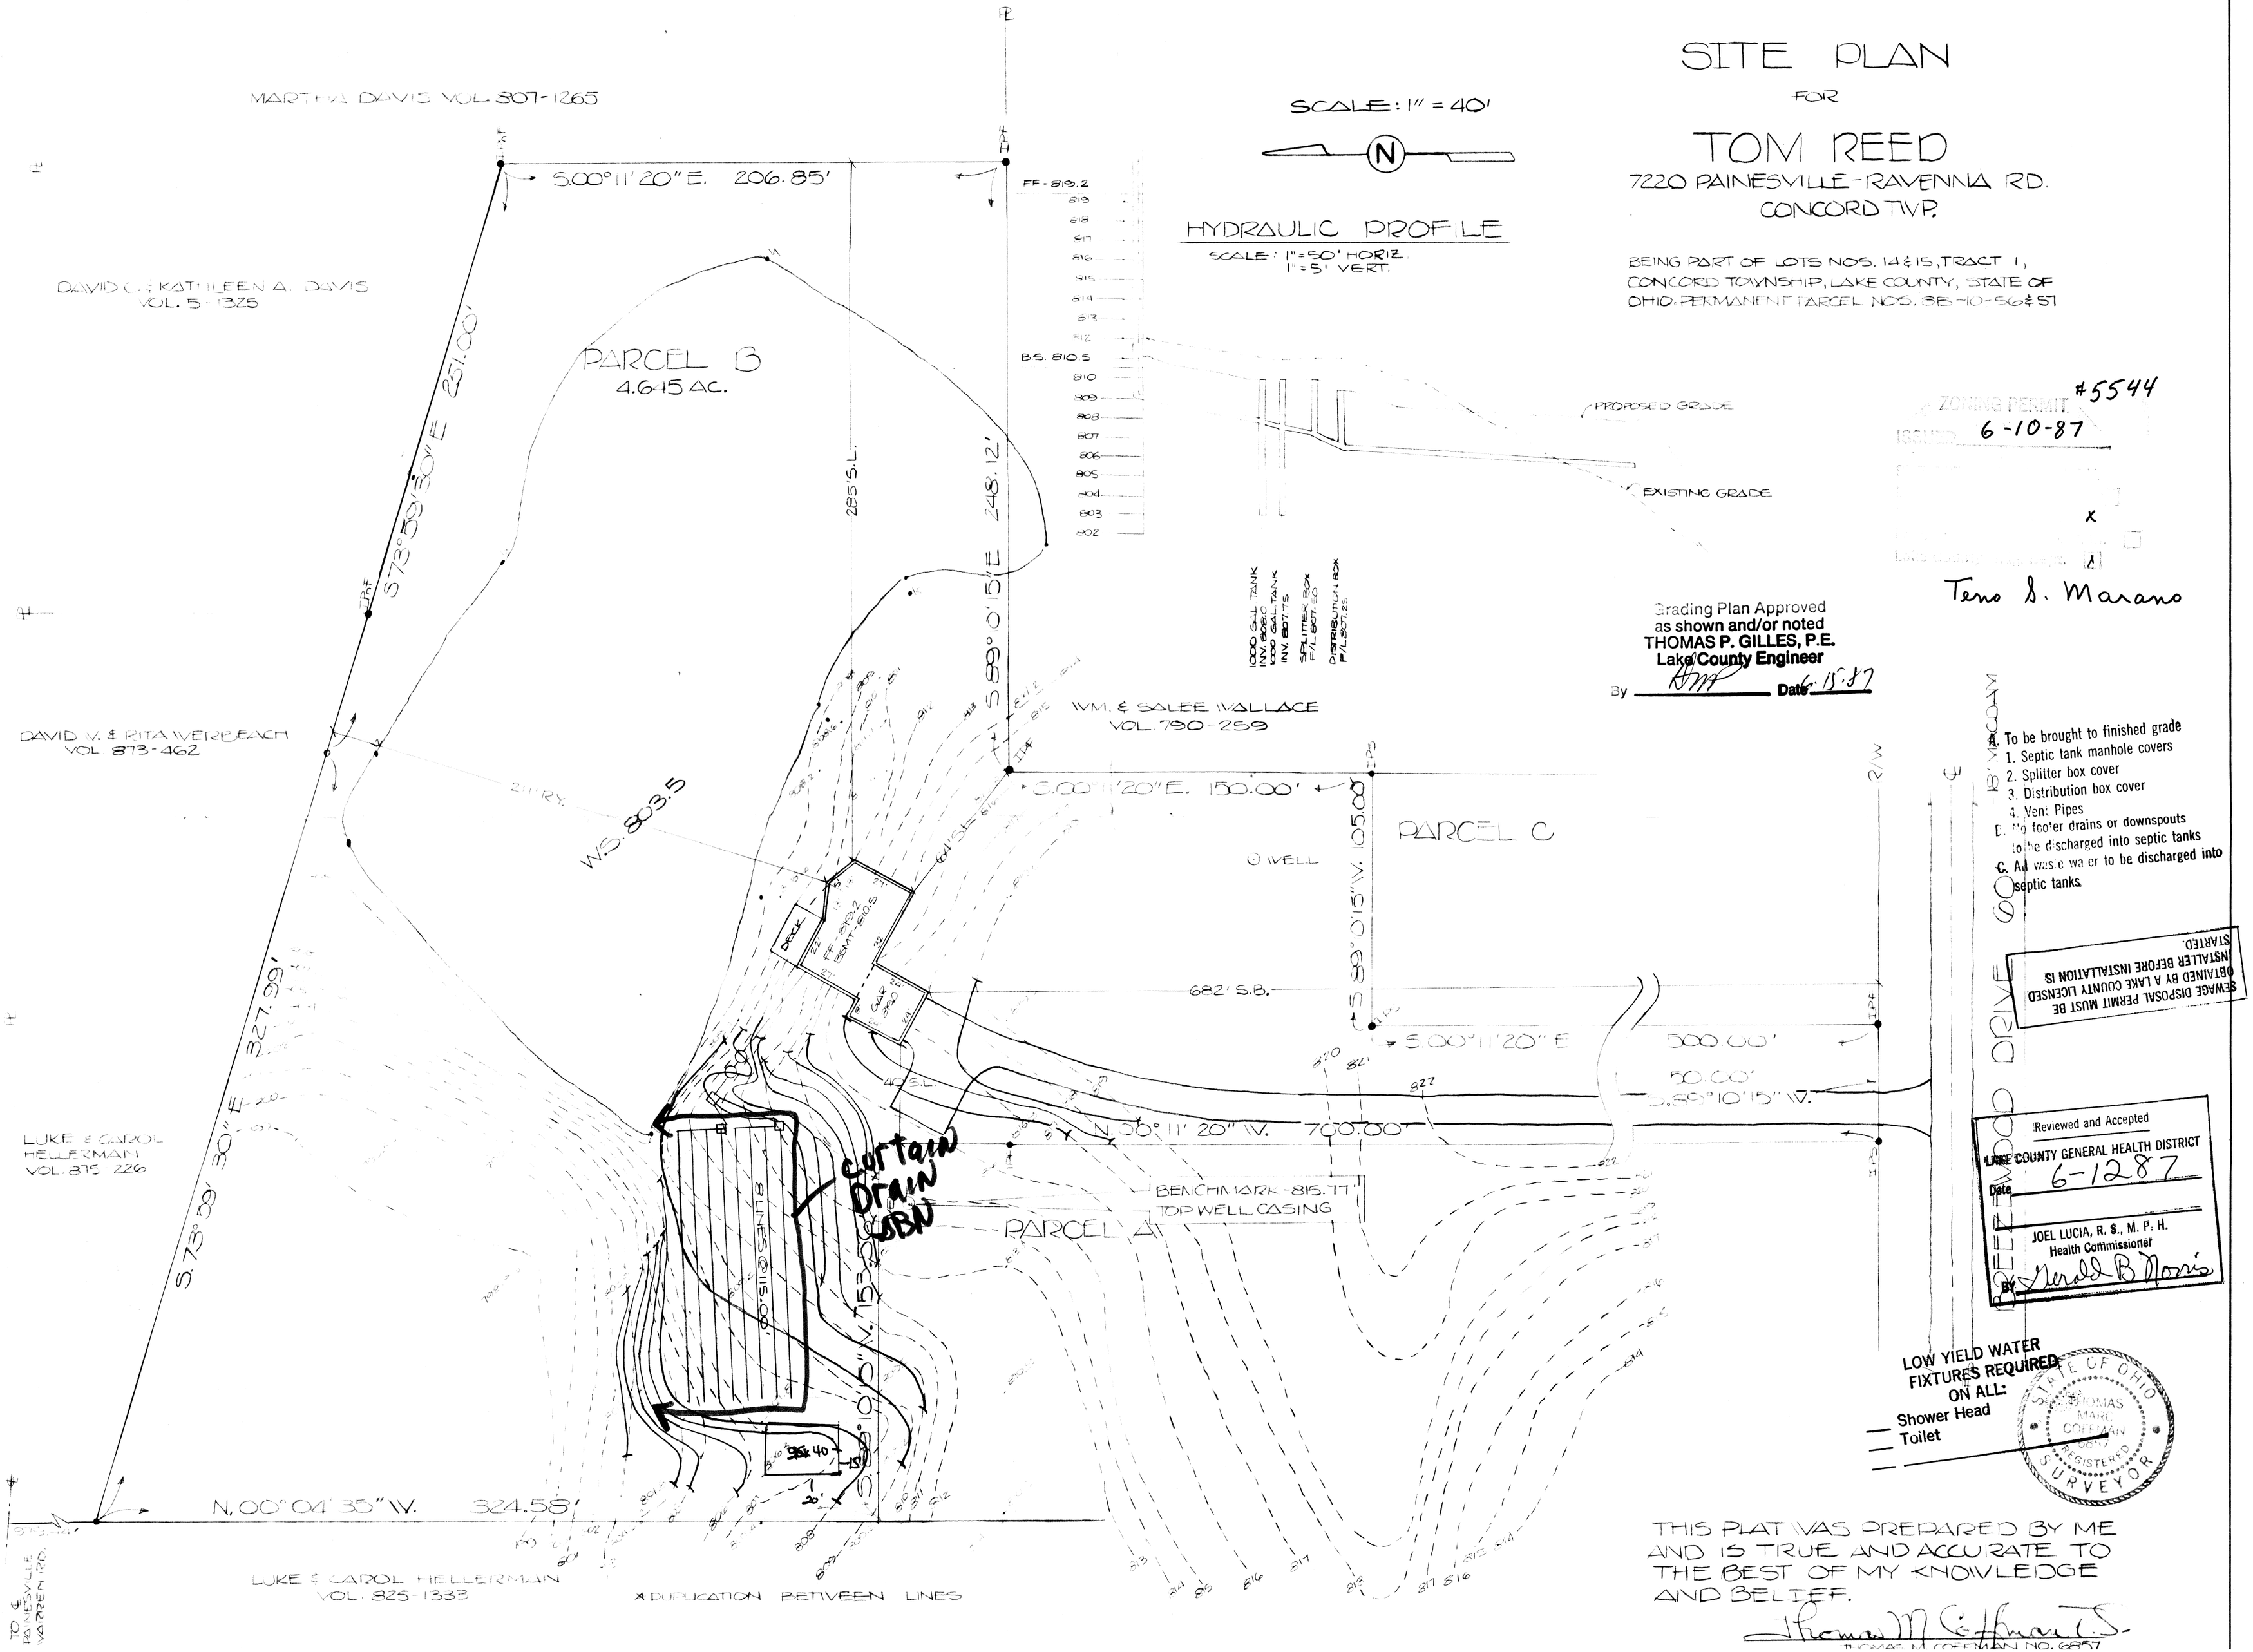

RUNING 44:232 71376