

HYDRAULIC PROFILE
HOR. : 1" = 40'
VERT. : 1" = 5'

1098.3

1096.3

1094.3

FIN GRADE

4" CURTAIN DRAIN

TANK 1104.14

TANK 1103.61

1103.42
1103.24
1103.04
1102.84
1102.64
1102.44
1102.24
1101.94
1101.64

ZONING PERMIT #0397-8653

1096.3 3/13/97

3-21-97

Daniel Brown









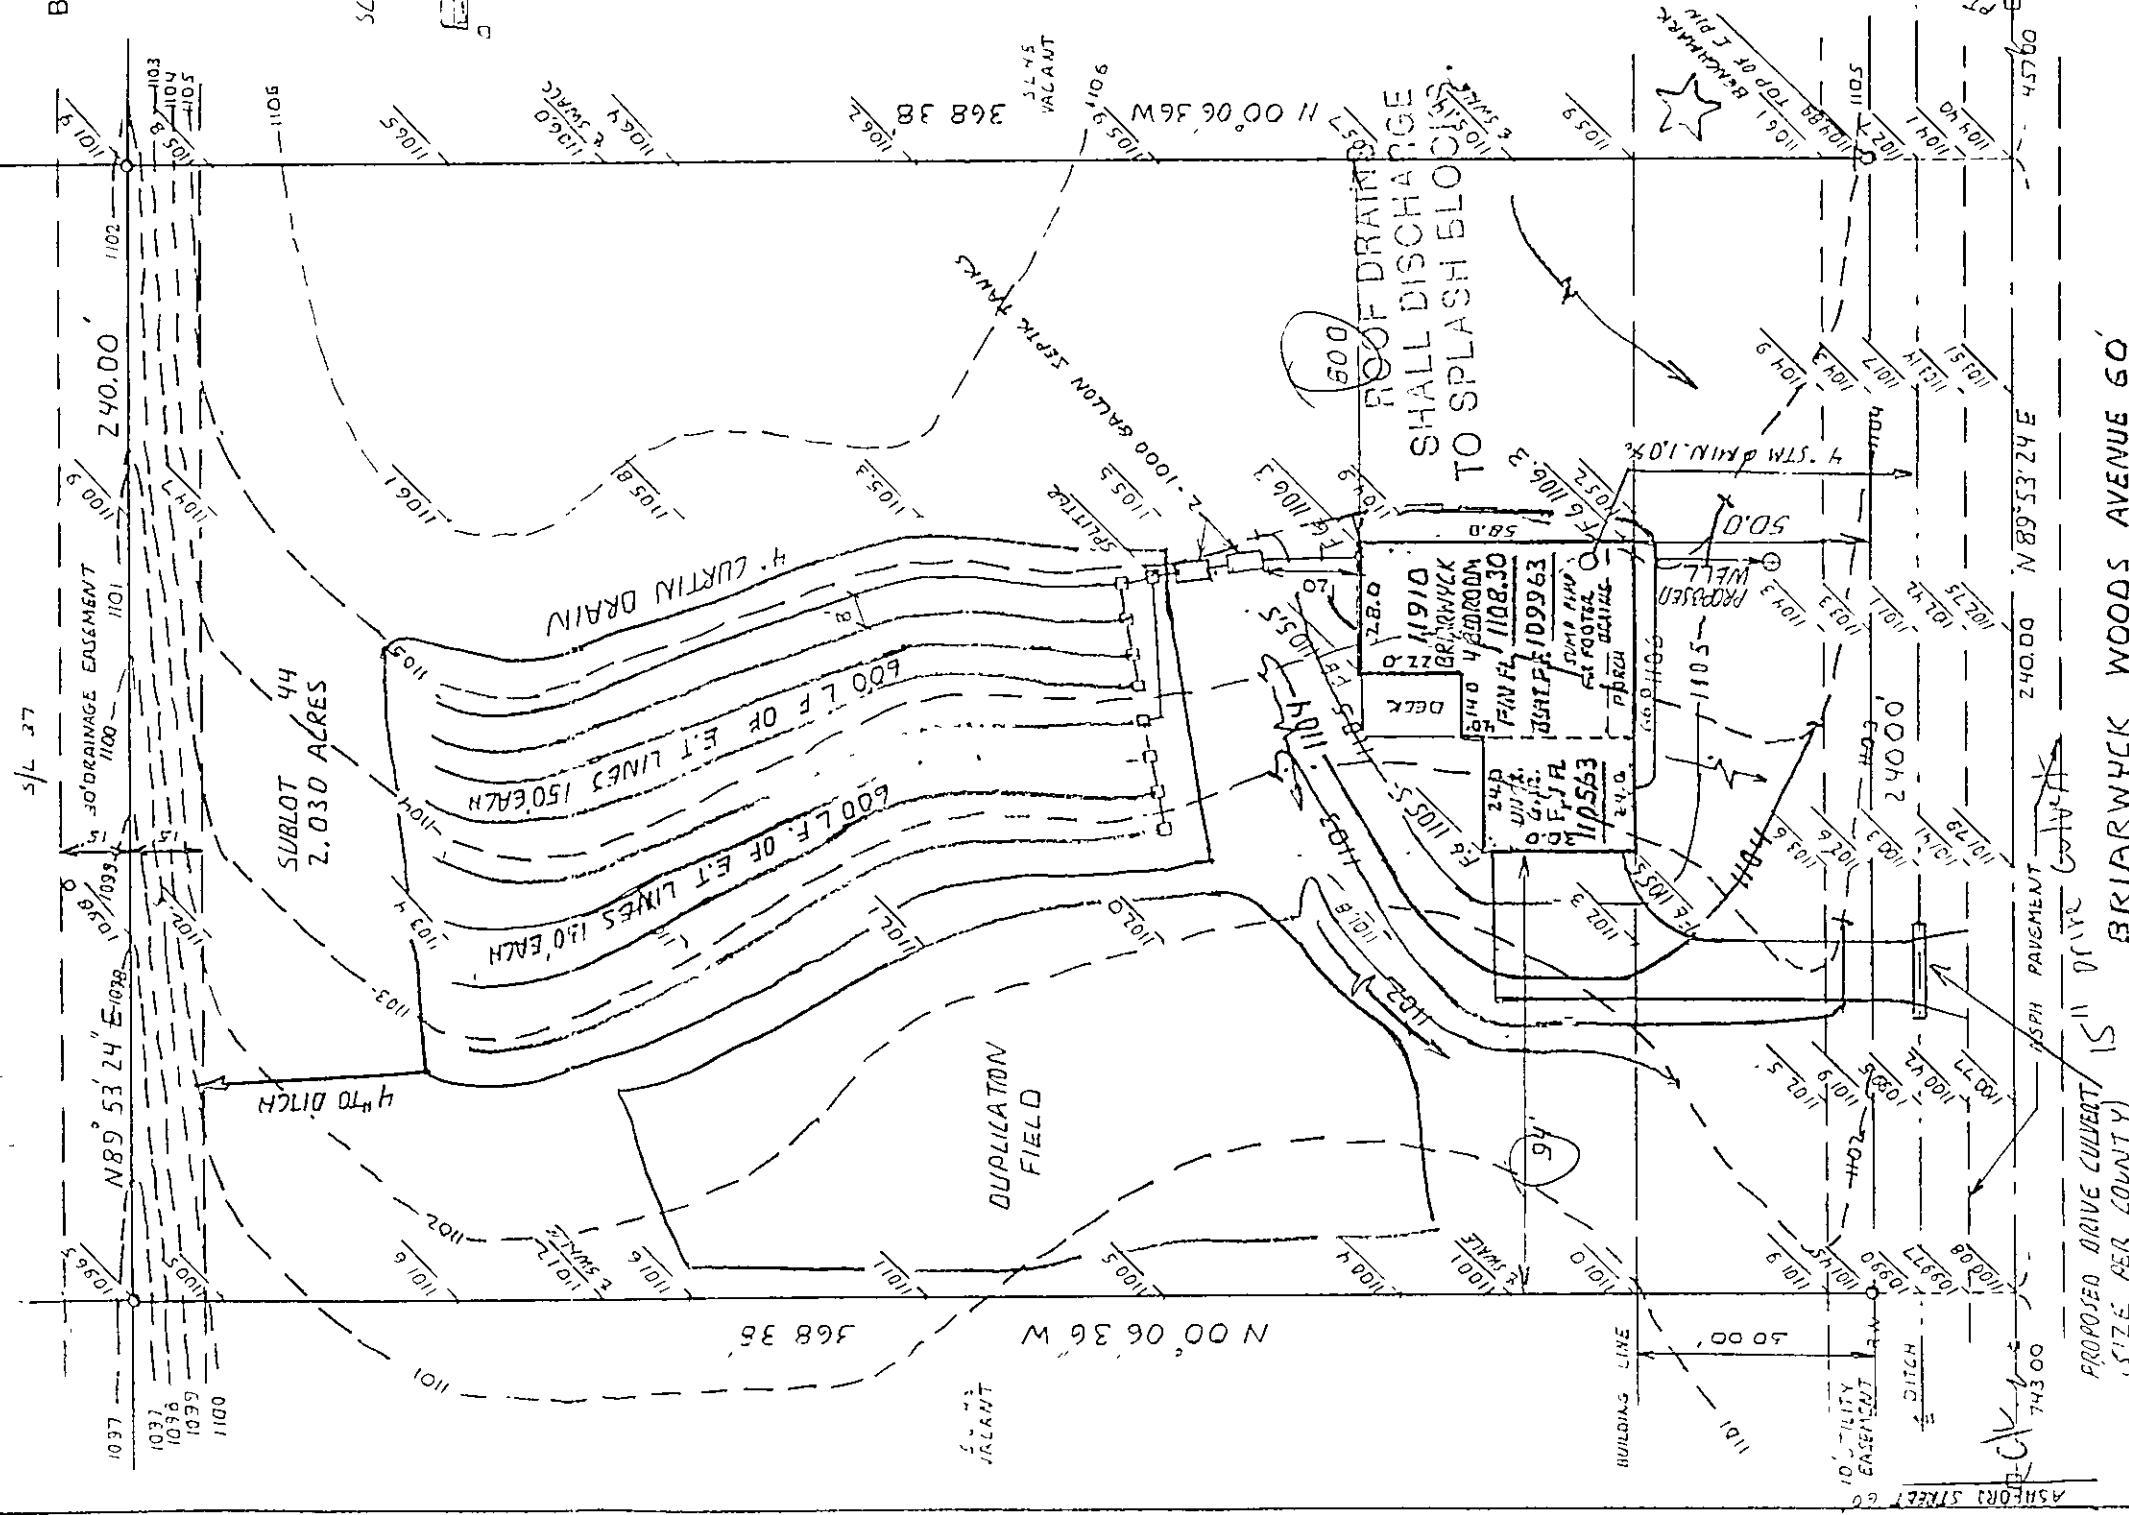

TYPICAL EVAPOTRANSPIRATION TRENCH CROSS SECTION


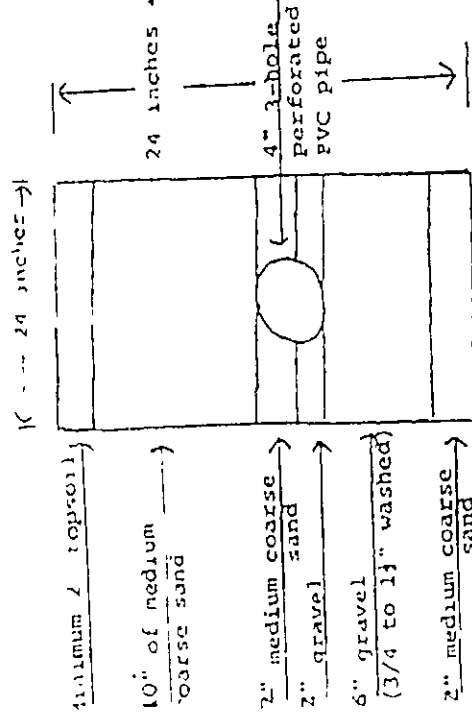


* The standard ET trench is 24 inches, however the trench can vary between 18 inches to 30 inches deep if necessary. When trench depth varies, the sand at the top of trench will vary from 10 to 18 inches deep.

Grading Plan Approved
shown and/or noted
THOMAS P. GILLES, P.E.
Lake County Engineer

By 6/14 Date 4/17

SCALE 1" = 40' FEB 11, 1997

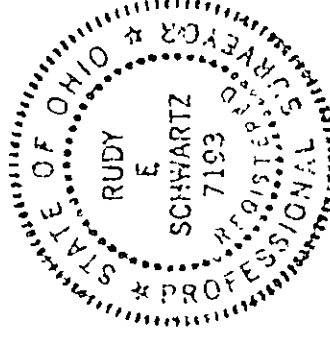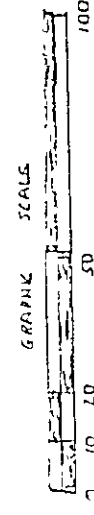

"I, the undersigned hereby certify that this topography, indicated by 6" or 2" contours, and elevations shown hereon represent an actual field survey made by me on the 20 day of JAN., 1997 and that the elevations were taken at appropriate intervals and that as of that date they existed as indicated hereon "

Name Rudy E. Schwartz

PREPARED BY:
RUDY E. SCHWARTZ
PROFESSIONAL SURVEYOR
15750 AUBURN ROAD
NEWBURY, OHIO 44065
(216)564-7528
FAX: (216)564-5675

PREPARED FOR
WATERFORD DESIGN HOMES, INC
P.O. BOX 855
CHARDON, OHIO 44024

SITE PLAN

SUBLOT NO. 44 BRIARWYCK WOODS AVENUE, CONCORD, OHIO
HAWTHORNE WOODS SUBDIVISION
RECORDED IN VOLUME 15, PAGE 46
OF LAKE COUNTY PLAT RECORDS

BRIARWYCK WOODS AVENUE 60'

PROPOSED DRIVE CULVERT 15" (SIZE PER COUNTY)

ASPH PAVEMENT

15" DRIVE