REVISIONS	BY

Barrington CONSULTING GROUP, INC.
9114 TYLER BLVD., MENTOR, OHIO 44060
PHONE 440.205.1260 FAX 440.205.1262
www.BarringtonCGI.com

STATE OF OHIO — DAVID W. NOVAK S-7507 — REGISTERED SURVEYOR

SITE PLAN

7991 BUTLER HILL DR., CONCORD TWP., OHIO 44077
S/L 90 MOUNTAINSIDE FARMS SUBDIVISION PH. 3A VOL. 61 PG. 7

PROBUILT HOMES, INC.

DRAWN	WSO
CHECKED	DWN
DATE	MAY 7, 2014
SCALE	1" = 20'
JOB NO.	11007-090
SHEET	2/3
OF SHEETS	

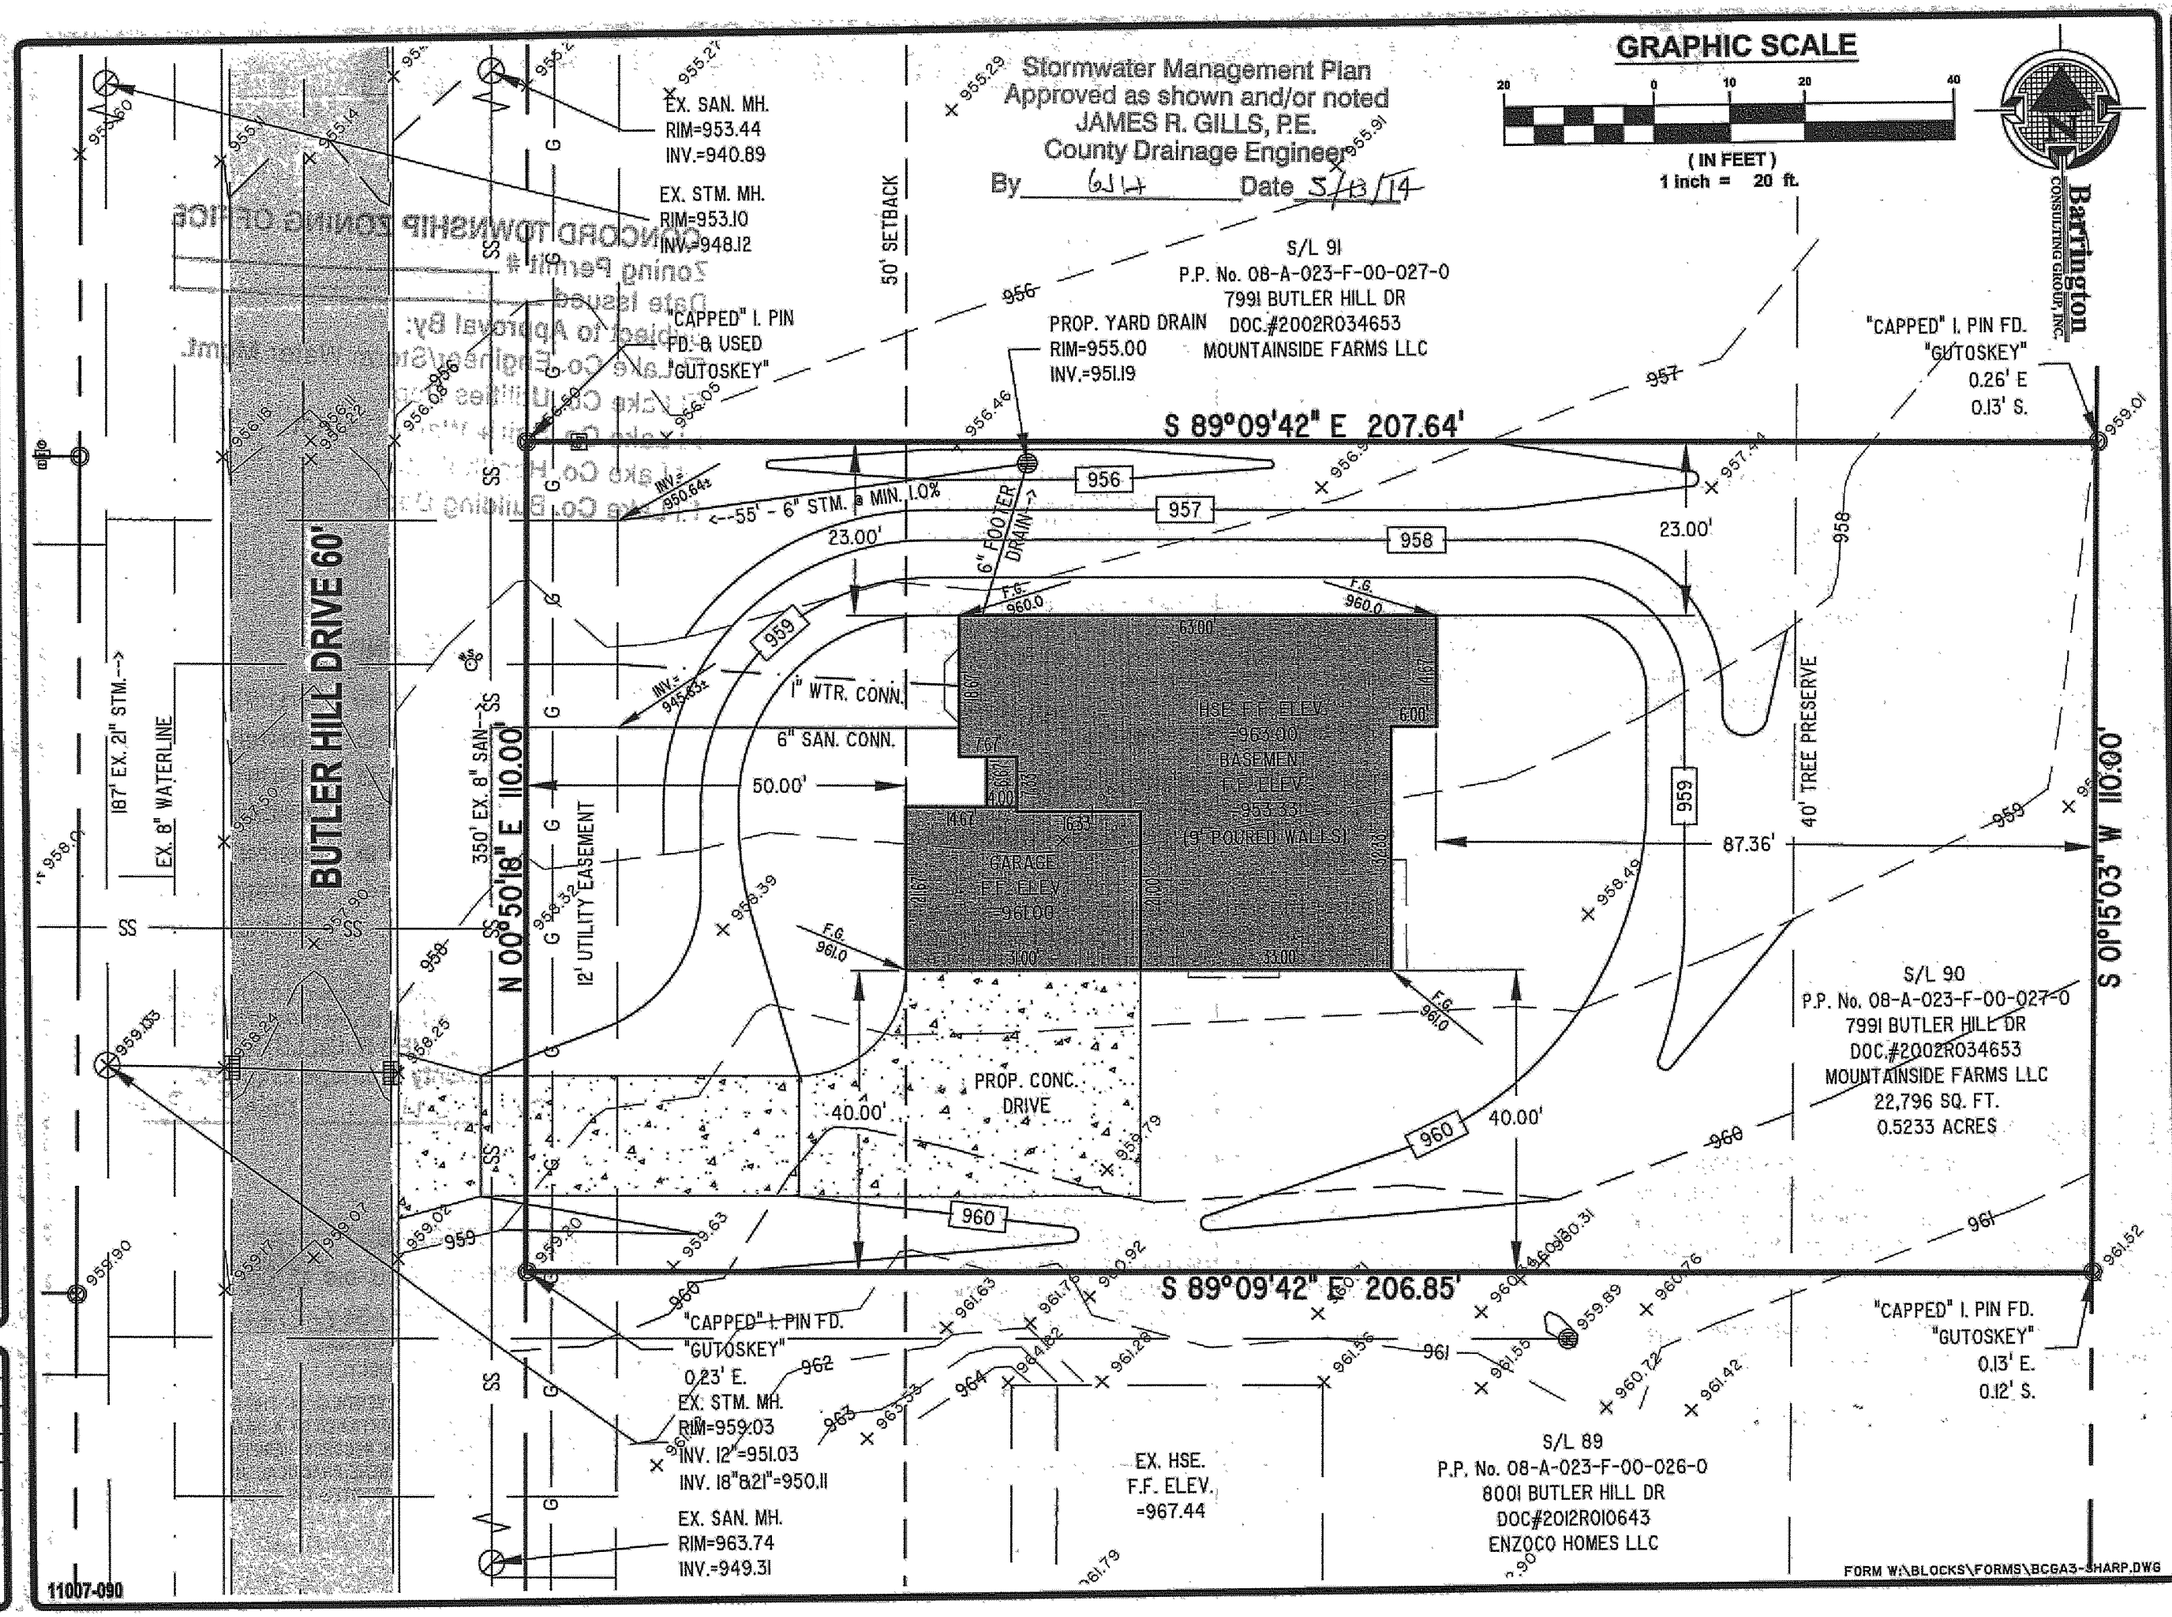

Barrington CONSULTING GROUP, INC.
9114 TYLER BLVD., MENTOR, OHIO 44060
PHONE 440.205.1260 FAX 440.205.1262
www.BarringtonCGI.com

Civil Engineers - Surveyors - Land Planners