


DRAWN
WSO
CHECKED
DWN
DATE
JUNE 17, 2014
SCALE
1" = 20'
JOB NO.
11007-075
SHEET
213
OF SHEETS

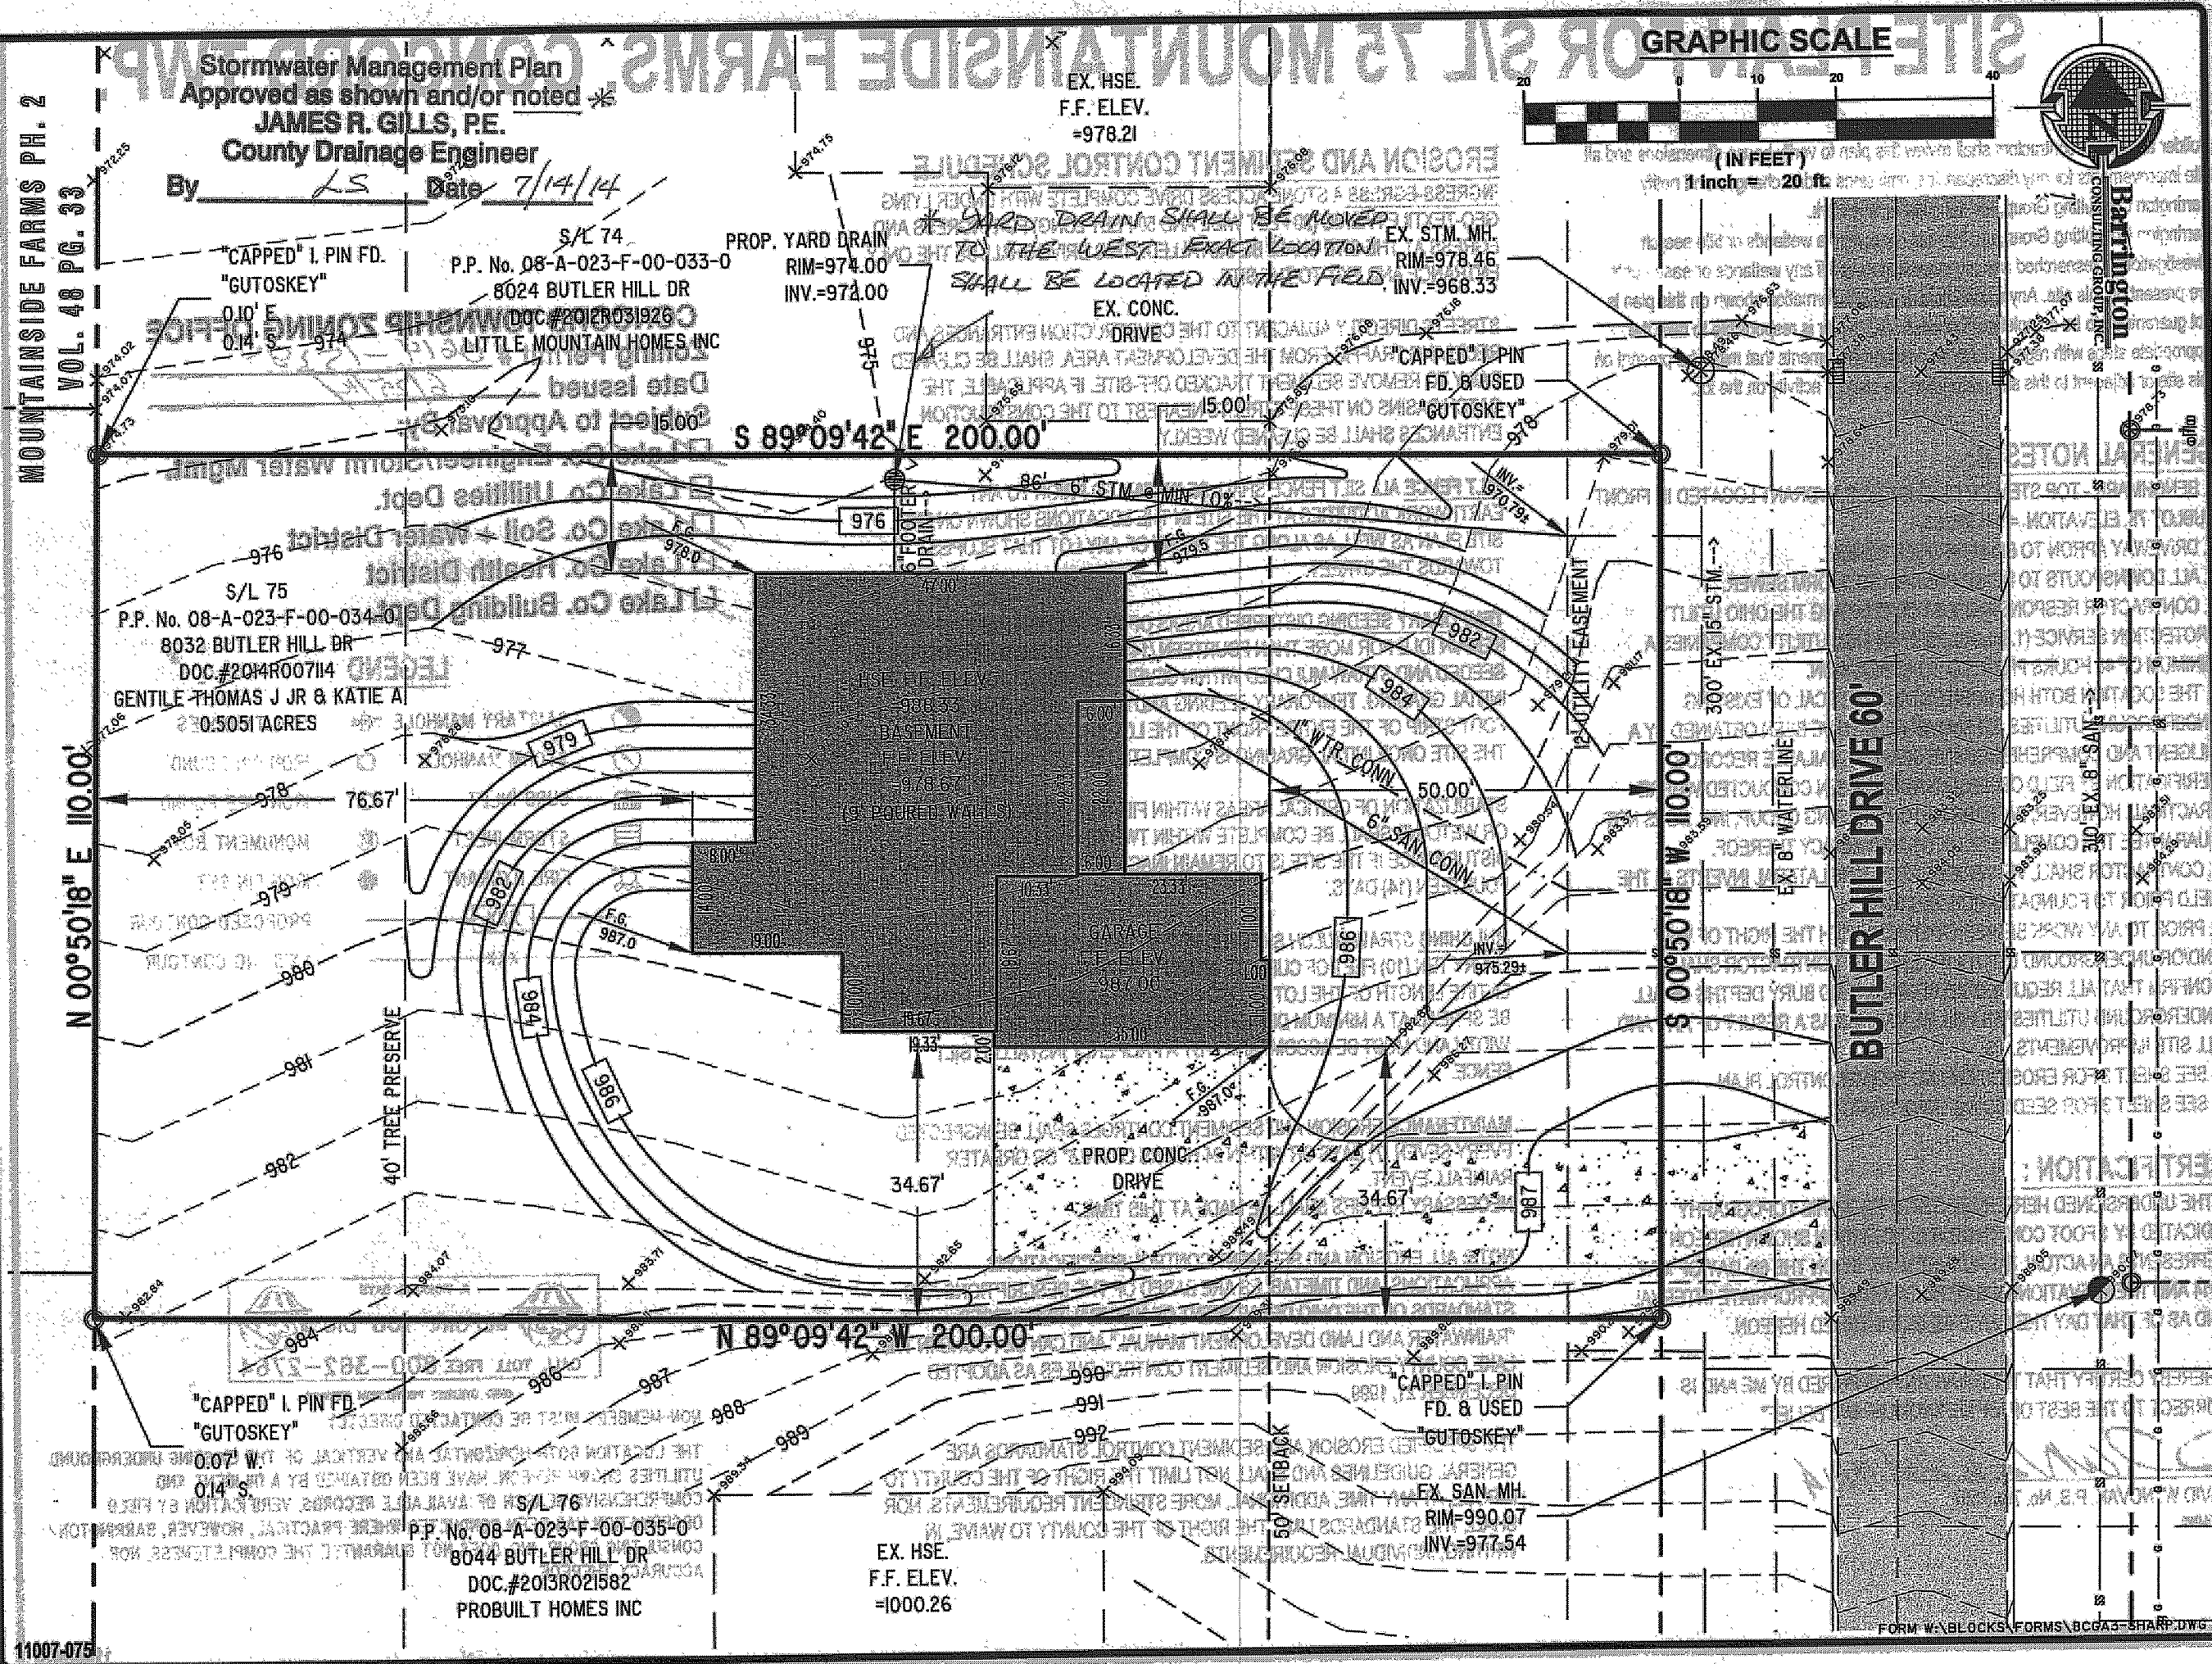

Civil Engineers - Surveyors - Land Planners

9114 TYLER BLVD., MENTOR, OHIO 44060
PHONE 440.205.1260 FAX 440.205.1262
www.BarringtonCGI.com

Barrington
CONSULTING GROUP INC.