


CURVE DATA
R = 720.58'
A = 129.09'
 $\Delta = 10^{\circ} 15' 53''$
T = 64.72'
C = 128.92'
S. $6^{\circ} 57' 46''$ E.

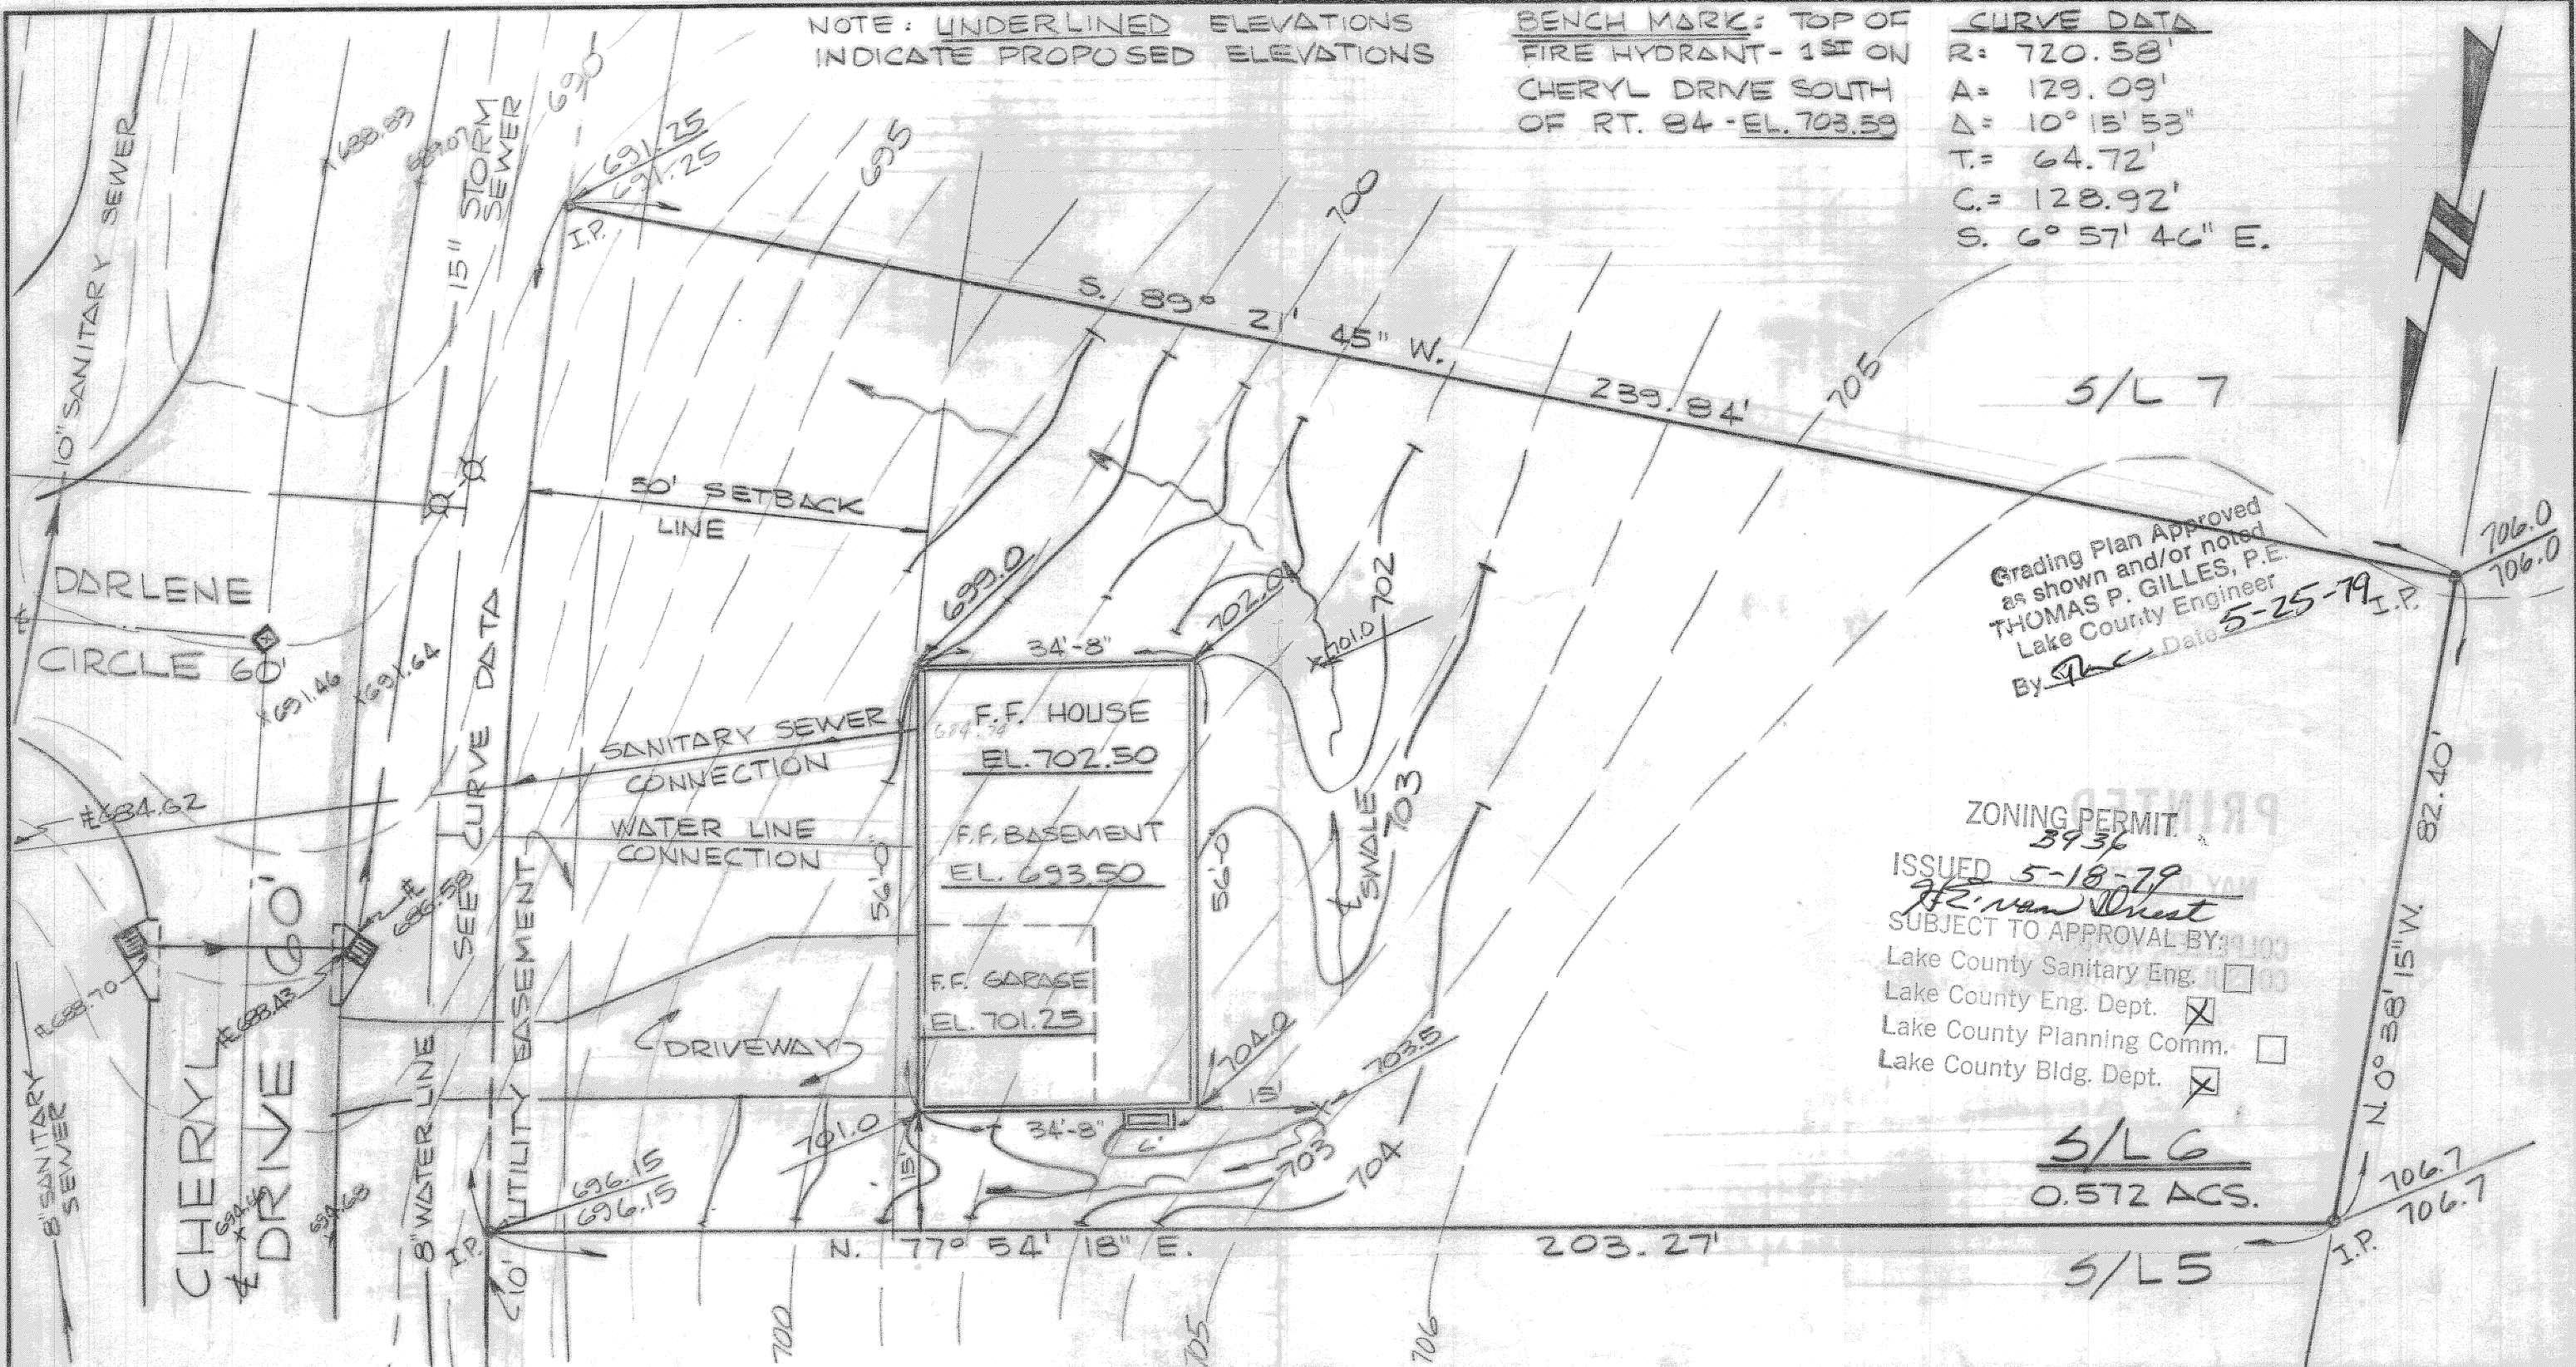

REG. SURVEYOR NO. 4003

REG. SURVEYOR NO.



IDENTIFICATION OF THE SUBJECT

FB 361 PG 56

BEING S/L #6, CONCORD KELLOGG PARK ESTATES
CONCORD TWP., LAKE COUNTY, OHIO