


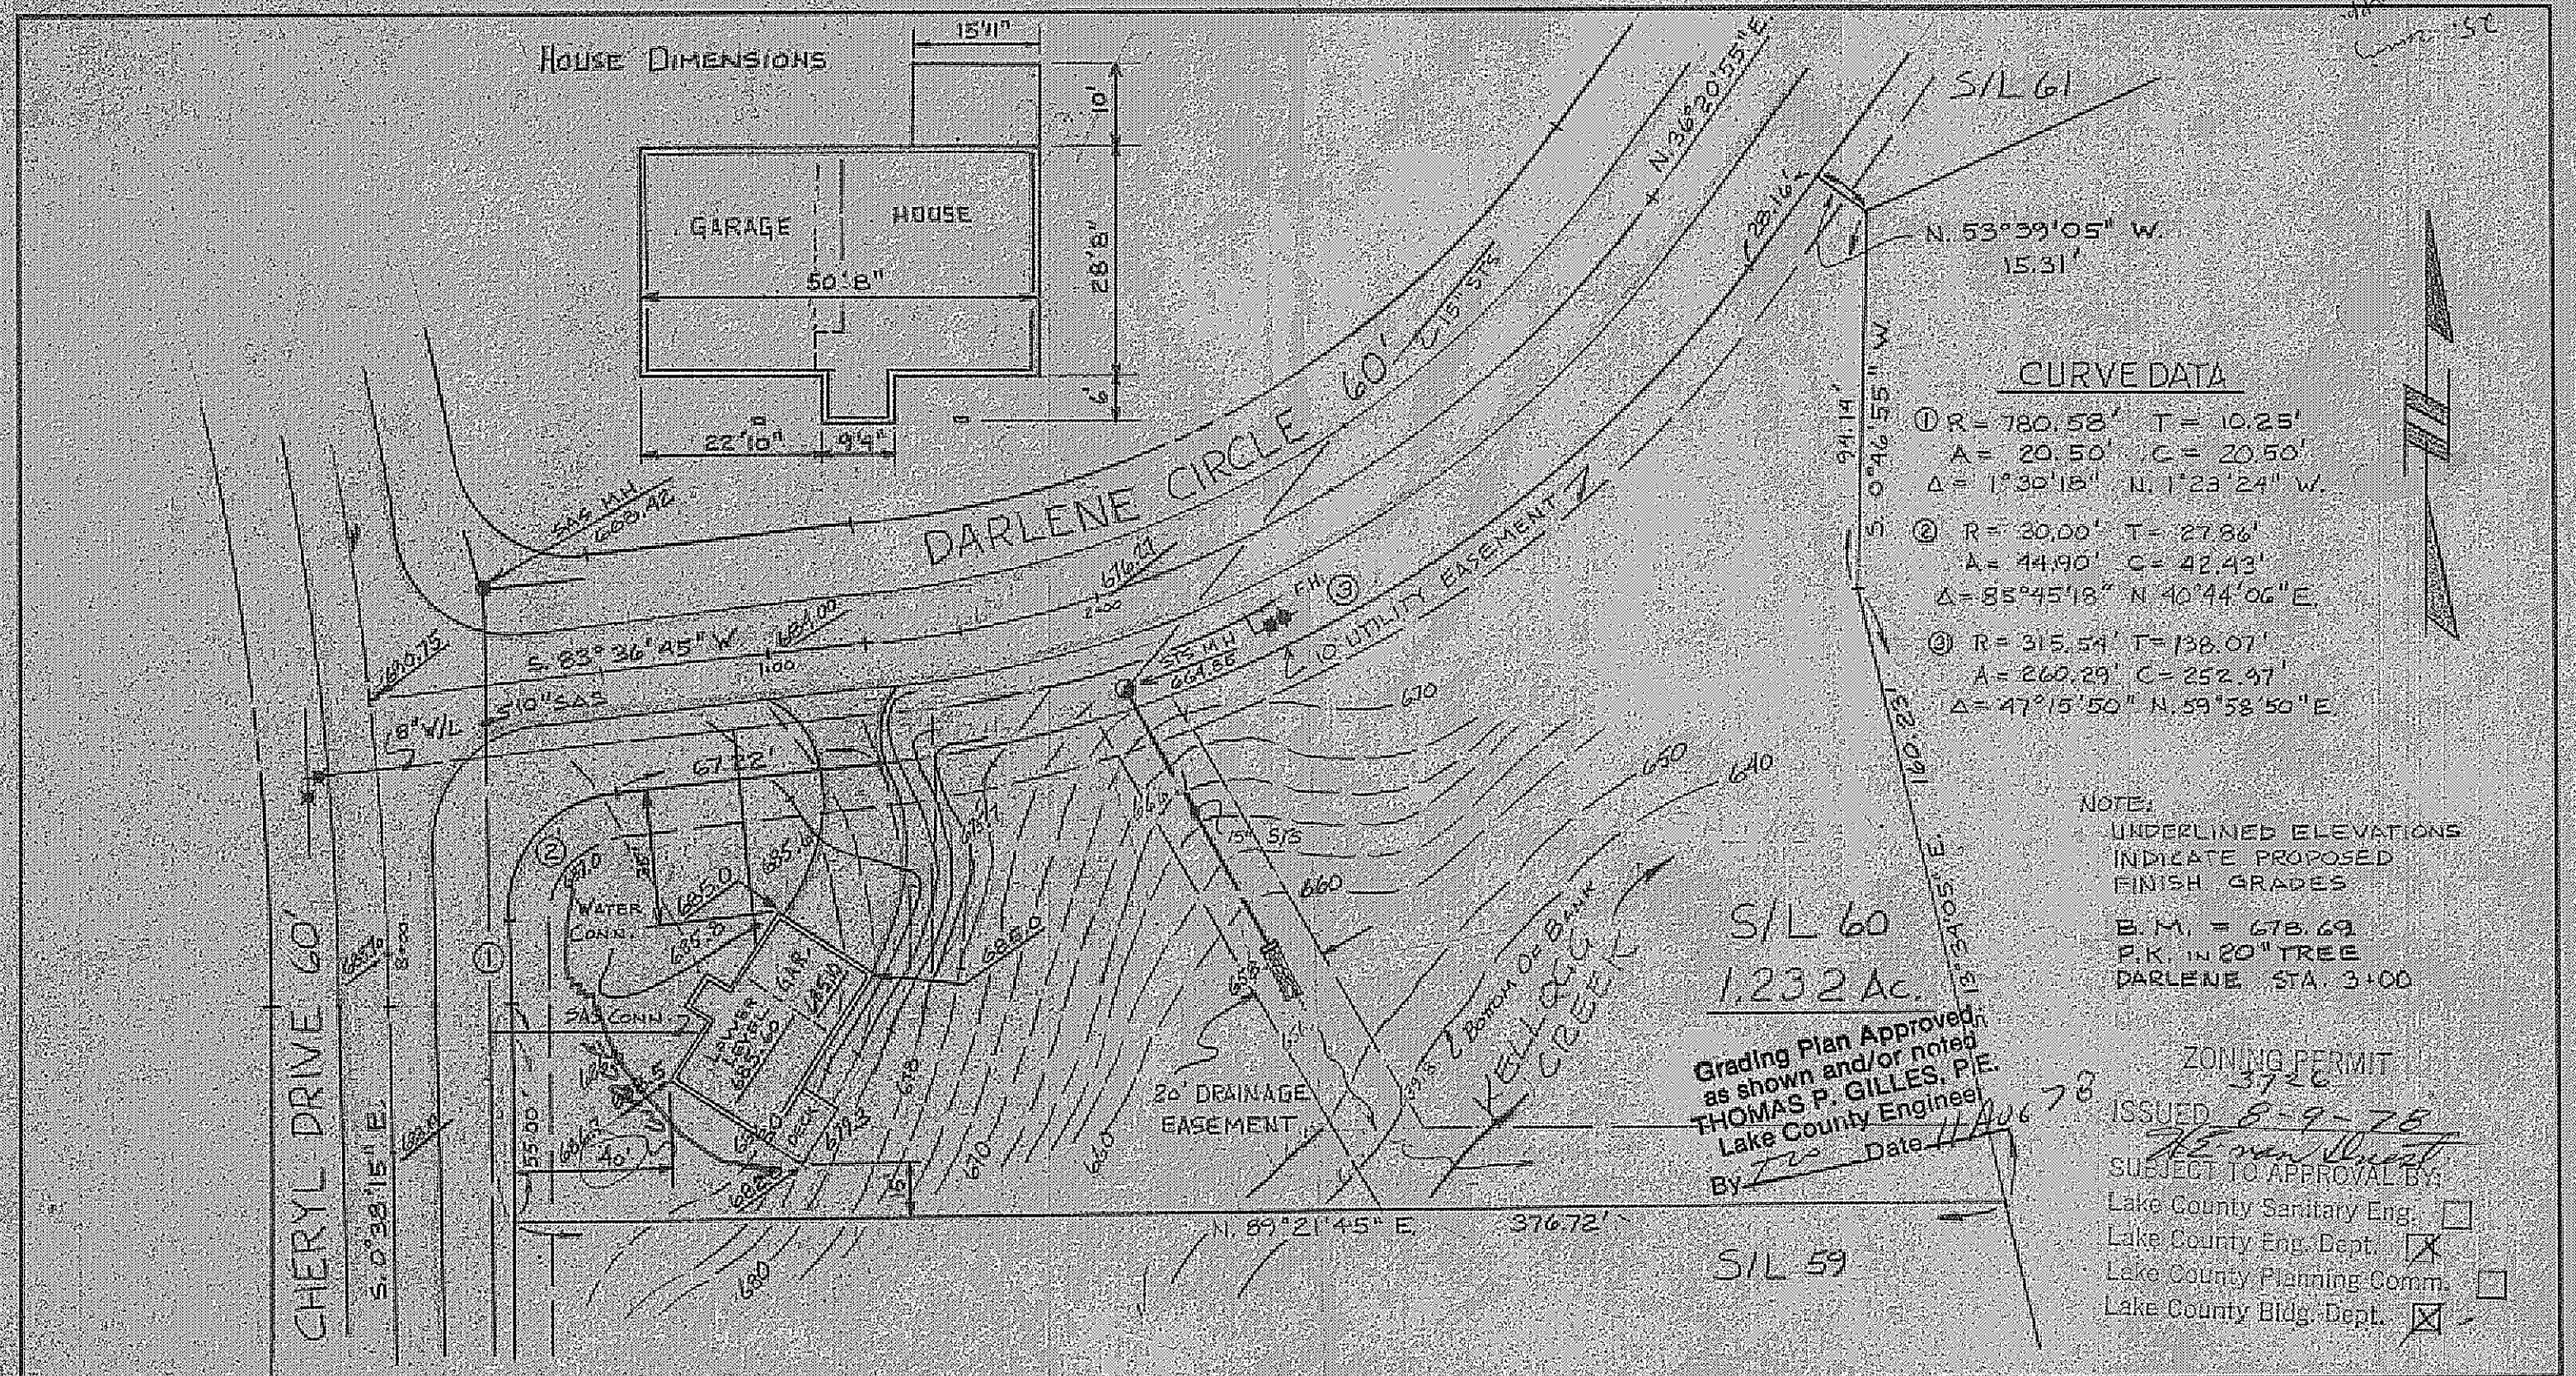

DESIGN CERTIFICATION THIS PLAN WAS PREPARED BY ME AND IS CORRECT TO THE BEST OF MY KNOWLEDGE AND BELIEF. <i>Elisabeth</i> REG. SURVEYOR NO. 4785	AS BUILT CERTIFICATION I HEREBY CERTIFY THAT THE CIRCLED GRADES ARE EXISTING FINISH GRADES CHECKED IN THE FIELD ON _____ AND THAT SURVEY IS CORRECT TO THE BEST OF MY KNOWLEDGE AND BELIEF. REG. SURVEYOR NO. _____	COLPETZER WOODS CONSULTANTS, INC. 180 SOUTH STATE STREET • PAINESVILLE, OHIO 44077 • (216) 357-7569	DATE <u>MAY 1975</u> SCALE <u>1" = 40'</u> DRAWN BY <u>J.T.G.</u> CHKD BY <u>E.</u> JOB NO. <u>78-100</u> PB <u>326</u> PG <u>52</u>	SITE PLAN FOR TOM REED BEING S/L 60, CONCORD KELLOGG PARK ESTATES CONCORD TOWNSHIP, LAKE COUNTY, OHIO
--	--	--	---	--