


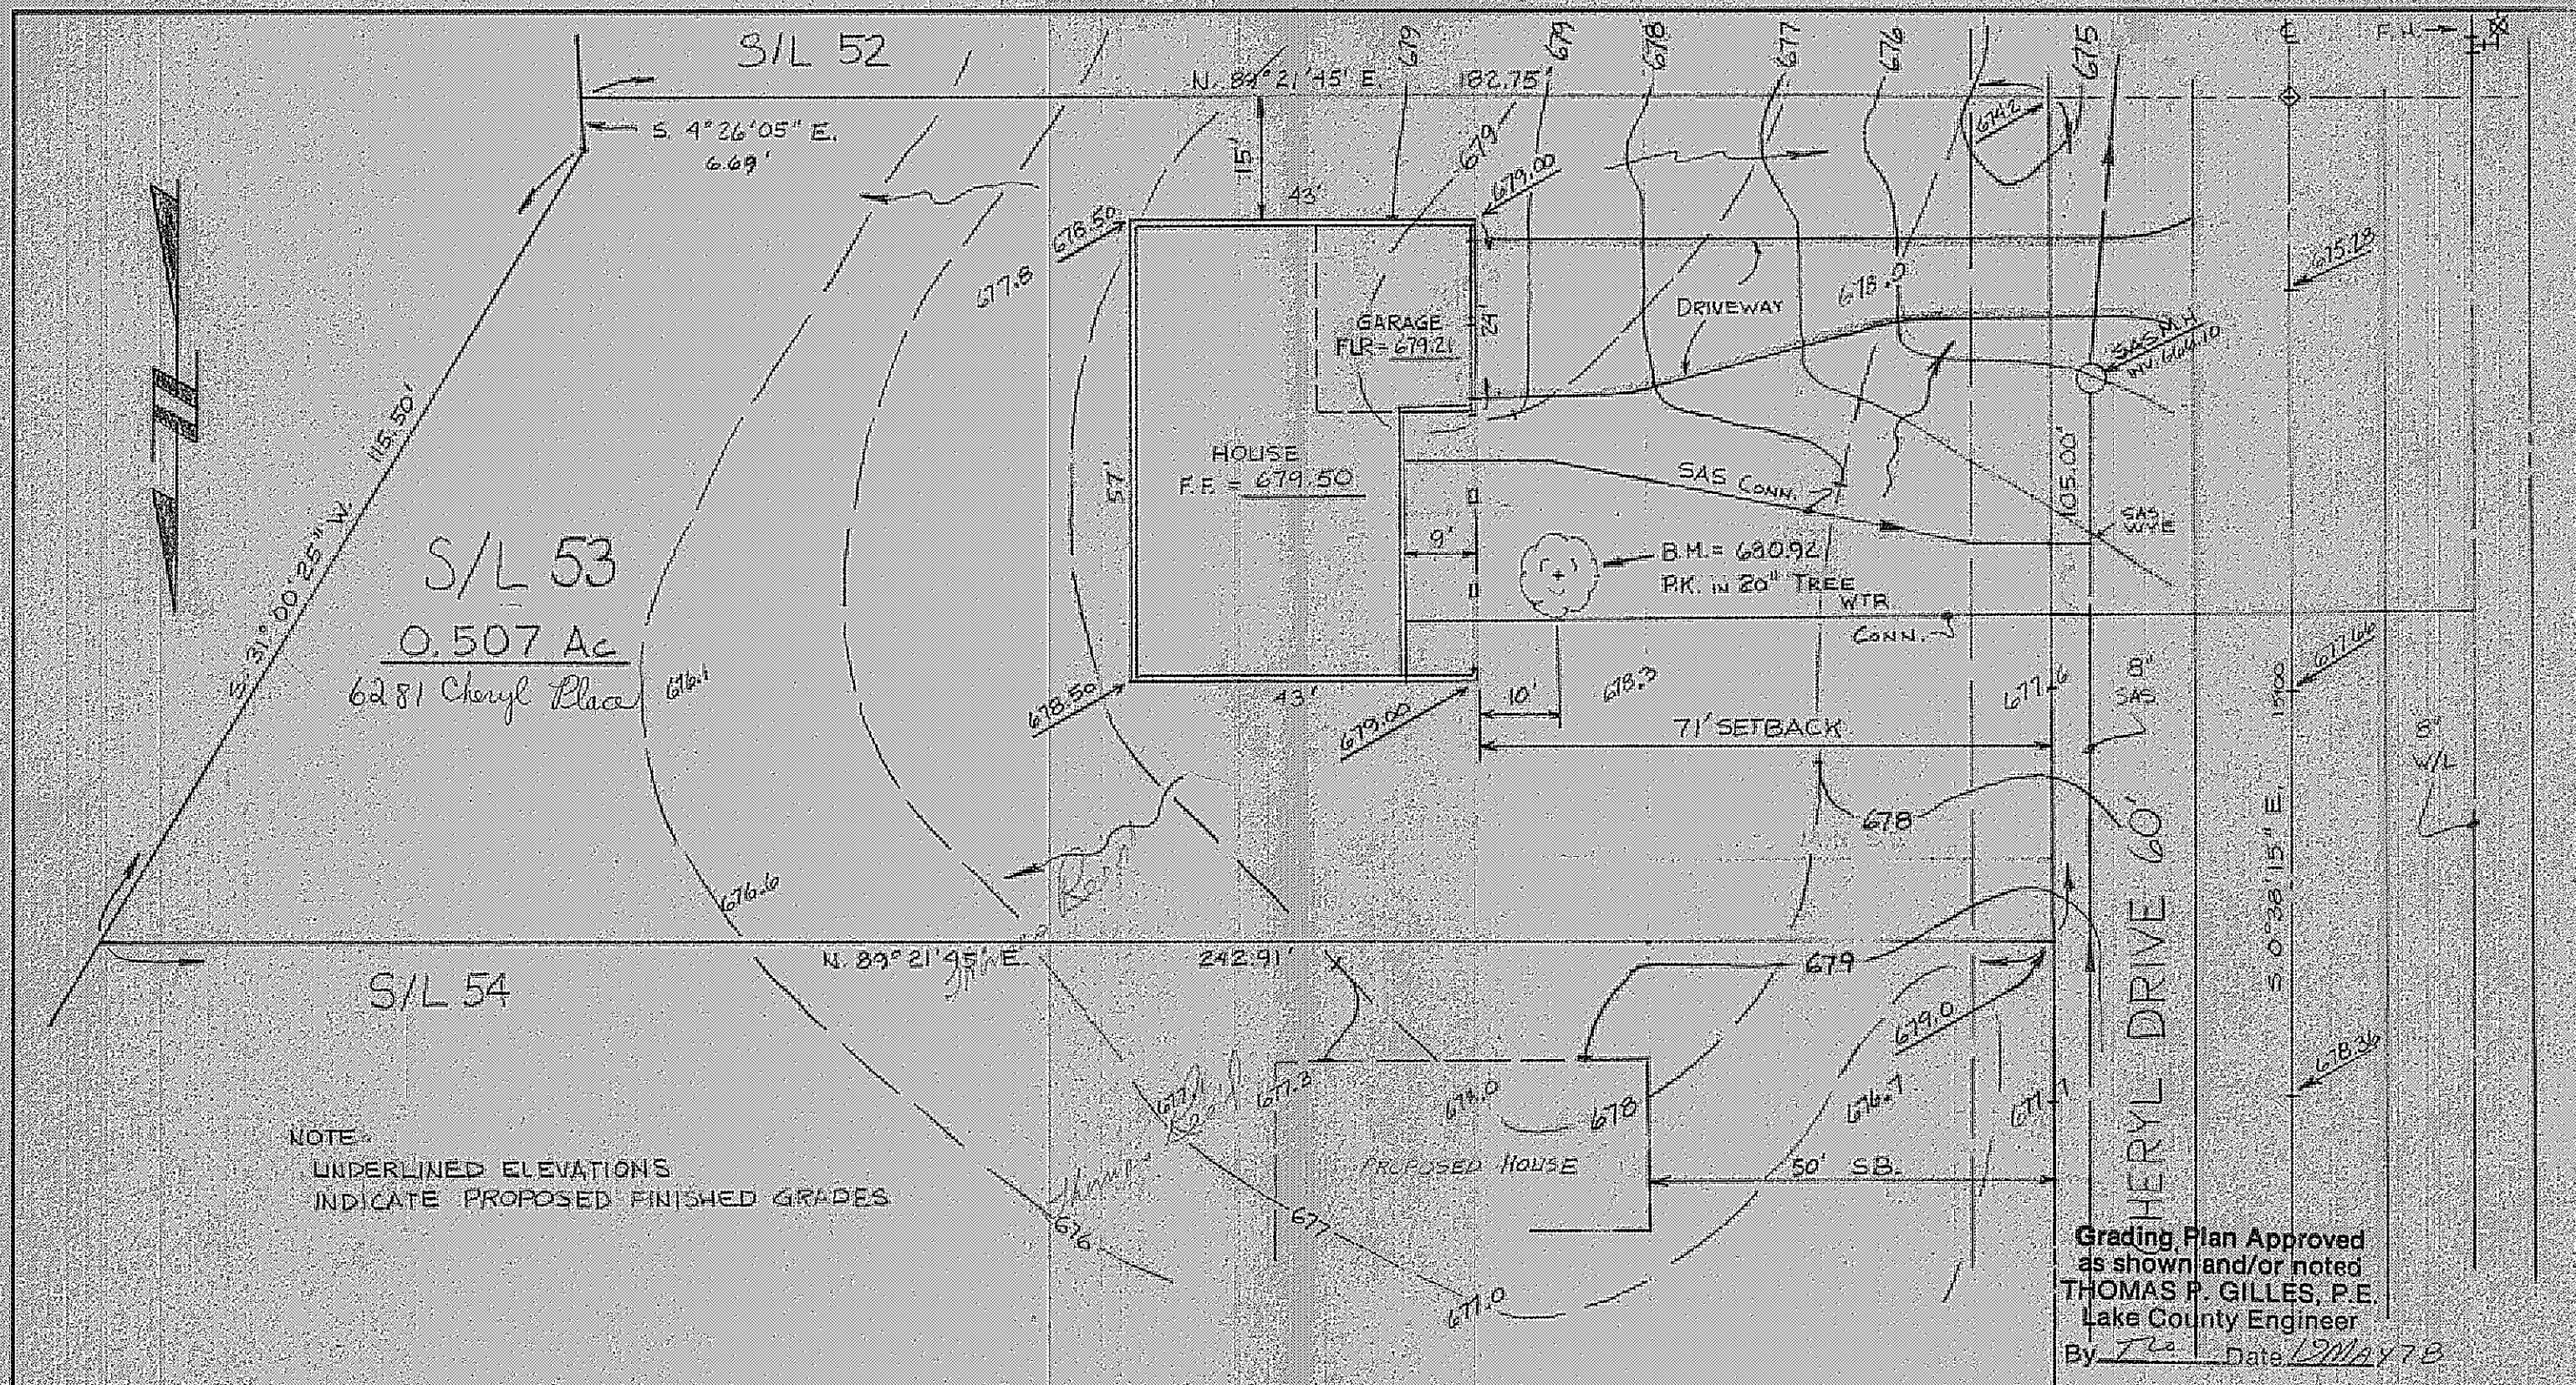

DESIGN CERTIFICATION

THIS PLAT WAS PREPARED BY ME,
AND IS CORRECT TO THE BEST OF
MY KNOWLEDGE AND BELIEF.

Thomas P. Gilles
REG. SURVEYOR NO. 4785

AS BUILT CERTIFICATION

I HEREBY CERTIFY THAT THE CIRCLED GRADES
ARE EXISTING FINISH GRADES CHECKED IN THE
FIELD ON AND THAT
SURVEY IS CORRECT TO THE BEST OF MY
KNOWLEDGE AND BELIEF.

REG. SURVEYOR NO.



COLPETZER WOODS
CONSULTANTS, INC.

180 SOUTH STATE STREET • PAINESVILLE, OHIO 44077 • (216) 357-7568

DATE MAY 1978

SCALE 1" = 20'

DRWN BY J.T.G.

CHKD BY

JOB NO. 78-108

FB. 326 PG. 52

SITE PLAN FOR
TOM REED

BEING S/L 53, CONCORD KELLOGG PARK ESTATES, OF LOT 3,
TRACT 4, CONCORD TOWNSHIP, LAKE COUNTY, OHIO