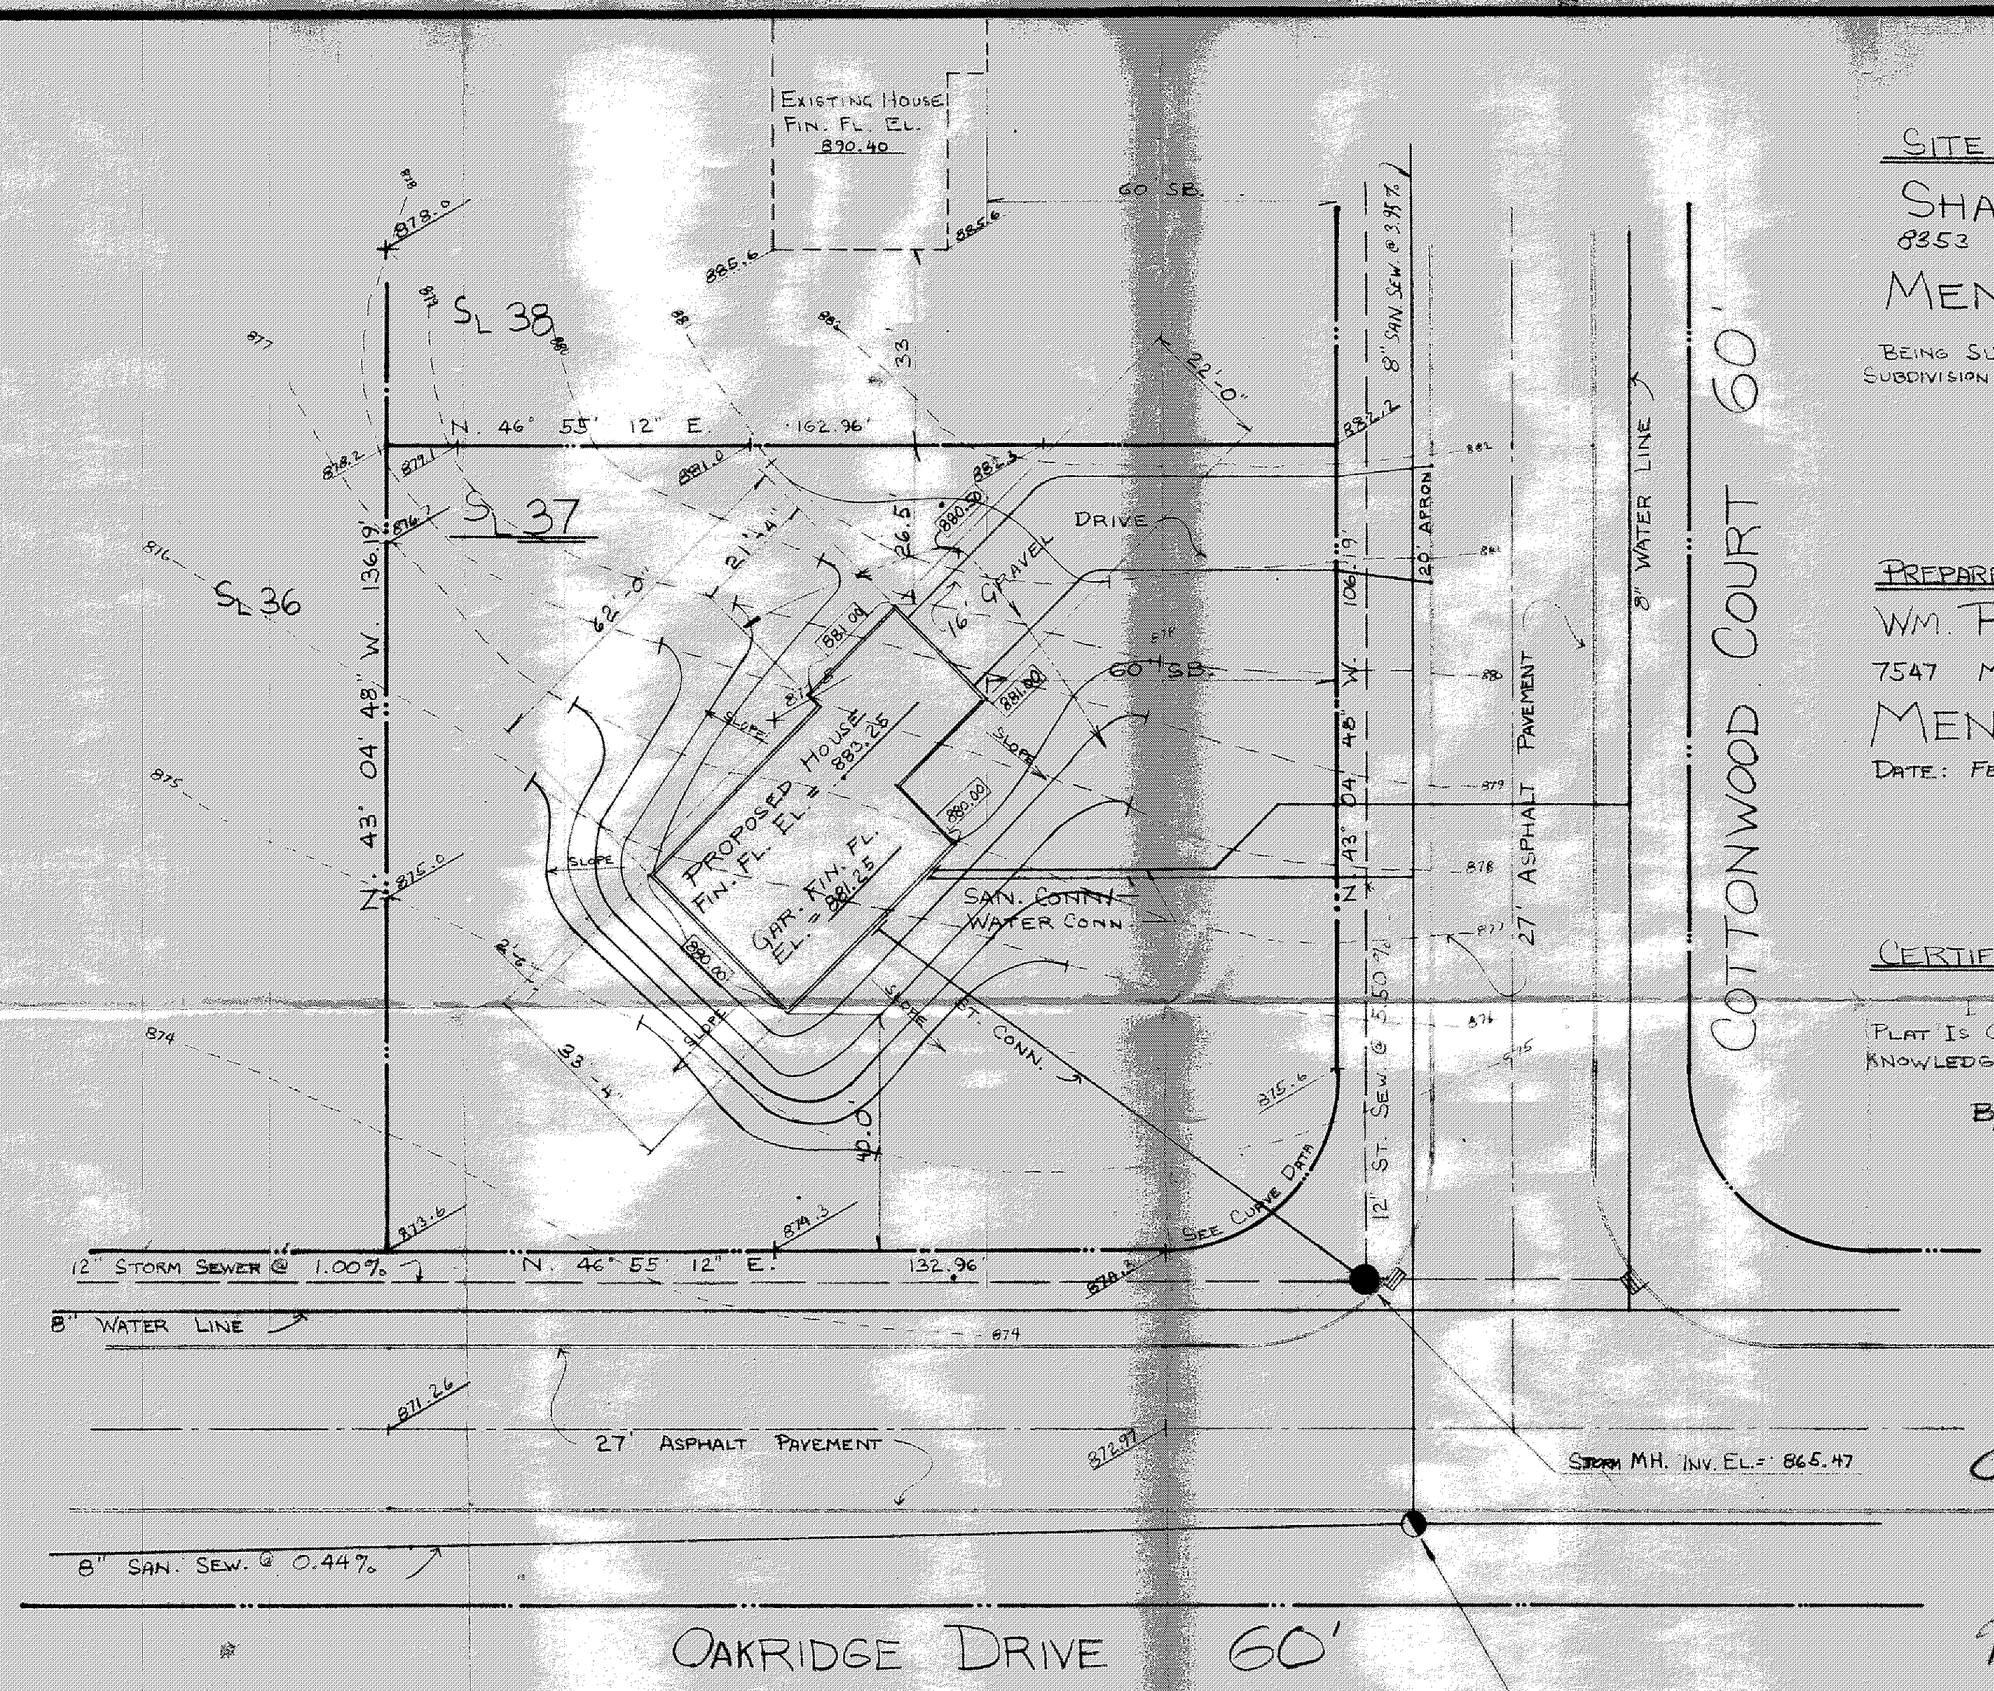

SITE PLAN FOR:

SHANDLE CONST.

8353 MENTOR AVE.

MENTOR, OHIO

BEING SUBLOT NO. 37 IN MORLEY HILLS ESTATES SUBDIVISION NO. 2 IN CONCORD TWP., OHIO.

PREPARED BY:

WM. R. GRAY ASSOC. INC.

7547 MENTOR AVE.

MENTOR, OHIO

DATE: FEB. 5, 1975 SCALE: 1" = 20'

CERTIFICATION:

I HEREBY CERTIFY THAT THIS PLAT IS CORRECT TO THE BEST OF MY KNOWLEDGE.

By: Wm. R. Gray

WM. R. GRAY REG. SURV. # 2752

STATE OF OHIO
WM. R. GRAY
2752
REGISTERED
PROFESSIONAL SURVEYOR

Zoning Permit # 2774
issued 2-13-75
N.E. new Draft

CURVE DATA:

RAD. = 30.00' ARC = 47.12
CH. = 42.43' N. 1° 55' 12" E.

Grading Plan Approved
as shown and/or noted
THOMAS P. GILLES, P.E.
Lake County Engineer

By: JWK Date 2-13-75