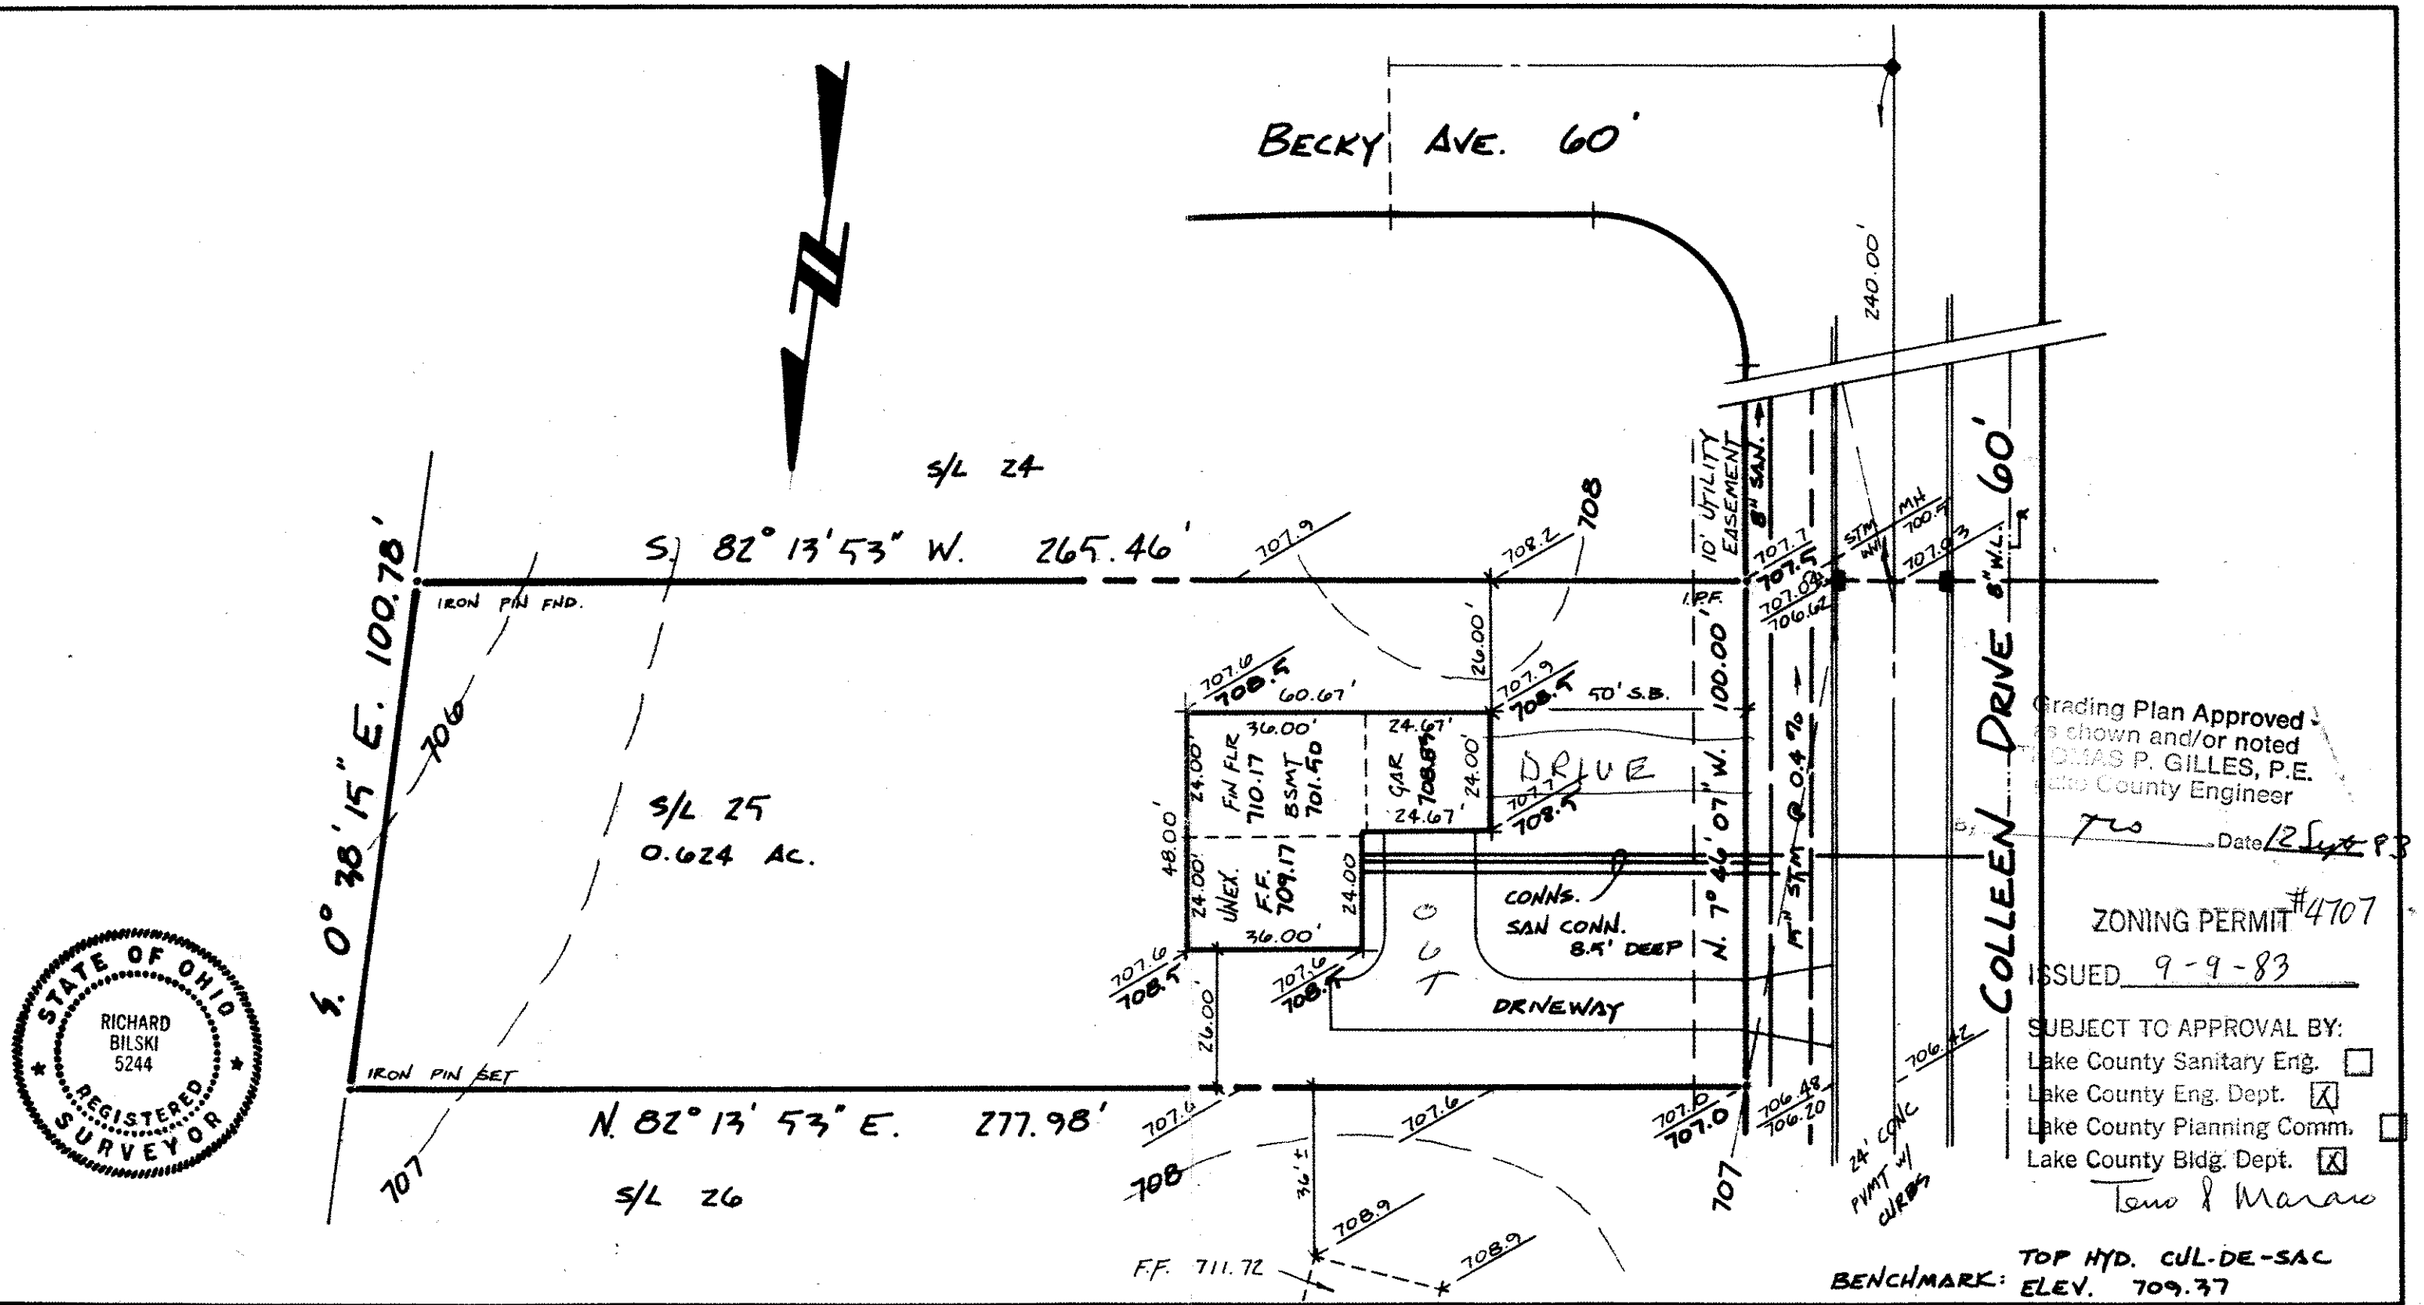

Grading Plan Approved
as shown and/or noted
THOMAS P. GILLES, P.E.
Lake County Engineer
By: [signature] Date 12 Sept 83

ZONING PERMIT #4707
ISSUED 9-9-83
SUBJECT TO APPROVAL BY:
Lake County Sanitary Eng. ☐
Lake County Eng. Dept. ☒
Lake County Planning Comm. ☐
Lake County Bldg. Dept. ☒
[signature]

BENCHMARK: TOP HYD. CUL-DE-SAC ELEV. 709.37

STATE OF OHIO
RICHARD BILSKI
5244
REGISTERED SURVEYOR

DESIGN CERTIFICATION

THIS PLAT WAS PREPARED BY ME, AND IS CORRECT TO THE BEST OF MY KNOWLEDGE AND BELIEF.

[signature]

REG. SURVEYOR NO. PS#5244

AS BUILT CERTIFICATION

I HEREBY CERTIFY THAT THE CIRCLED GRADES ARE EXISTING FINISH GRADES CHECKED IN THE FIELD ON _____ AND THAT SURVEY IS CORRECT TO THE BEST OF MY KNOWLEDGE AND BELIEF.

REG. SURVEYOR NO. _____

COLPETZER · WOODS
CONSULTANTS, INC.
9470 MENTOR AVENUE • MENTOR, OHIO 44060 • (216) 357-7569

DATE 8-30-83
SCALE 1" = 30'
DRWN BY BMM
CHKD BY
JOB NO 83-245
FB 468 PG 88

SITE PLAN
DONALD MYERS
S/L 25 CONCORD KELLOGG PARK ESTATES
VOL X-13
CONCORD TWP. LAKE COUNTY OHIO