


NORTH

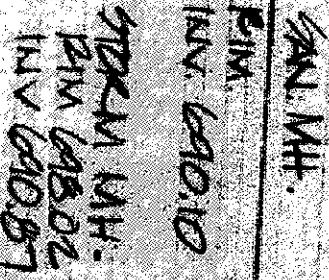

COLLEEN DR. 60'

SUBJECT TO APPROVAL BY:

Lake County Sanitary Eng.	<input type="checkbox"/>
Lake County Eng. Dept.	<input checked="" type="checkbox"/>
Lake County Planning Comm.	<input type="checkbox"/>
Lake County Bldg. Dept.	<input checked="" type="checkbox"/>

*Teno & Mariano*

SITE PLAN FOR:



MENTOR, OHIO 44060

SHEET 1 OF 1

CONTRACT NO. 12-00