

ERNEST G. & HAZEL O. GIBBS
V. 340-555

SITE PLAN
FOR
TOM CONDON
BEING A PART OF LOT 17 TRACT 1
IN THE TOWNSHIP OF CONCORD,
COUNTY OF LAKE, STATE OF OHIO.

THOMAS O. WILLIAMS
V. 541-347

CONLEY ROAD 60'

CLIFFORD & EVELYN M. WALLACE
V. 701-338

Grading Plan Approved
as shown and/or noted
by THOMAS P. GILLES, P.E.
Lake County Engineer
Date 7/21/90
By G.H.
1. MINIMUM 12" DRIVE CURVE

Reviewed and Accepted
LAKES COUNTY GENERAL HEALTH DISTRICT
Date 7-27-90
JOEL LUCKA, R.S., M.P.H.
Health Commissioner

zoning #
0542

WM K. & SALLEE L. WALLACE
V. 701-336

HYDRAULIC PROFILE
A. To be brought to finished grade 1" = 4' Horiz 1" = 40'
1. Septic tank manhole covers
2. Splitter box cover
3. Distribution box cover
B. No footer drains or downspouts
to be discharged into septic tanks
C. All waste water to be discharged into
septic tanks


LOW YIELD WATER
FIXTURES REQUIRED
ON ALL:
Shower Head
Toilet

NOTE
SEWAGE DISPOSAL PERMIT MUST BE
OBTAINED BY LAKE COUNTY LICENSED
INSTALLER BEFORE INSTALLATION IS
STARTED.

EVAPORATION-TRANSPIRATION
METHOD DETAIL

CURTAIN DRAIN DETAIL

J.J. NAGY
V. 572-372

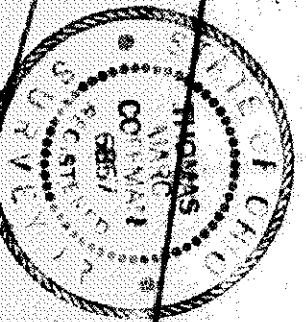

1. The undersigned hereby certifies that
this plan was prepared by him or under
his direct supervision and that he is a
 duly licensed Professional Engineer in
the State of Ohio and that the work
shown on this plan was done by him or
under his direct supervision and that he
is the author of the plan.

VILLAGE SURVEYING CO.

J. W. Coffman JS
No 6857