


BEING SUBJECTS No. 1 & 2 IN THE DANVERS
ESTATES SUBDIVISION LOCATED IN
CONCORD TWP., OHIO.


DATE: NOV. 26, 1974 SCALE: 1" = 20'
REVISED APR. 16, 1975

I HEREBY CERTIFY THAT
THIS PLAN IS CORRECT TO THE
OF MY KNOWLEDGE.

By: Wm. R. Gray
WM. R. GRAY REGISTRAR

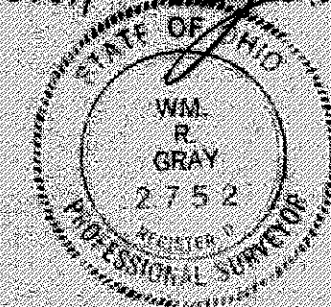

ZP #2784
3-12-75

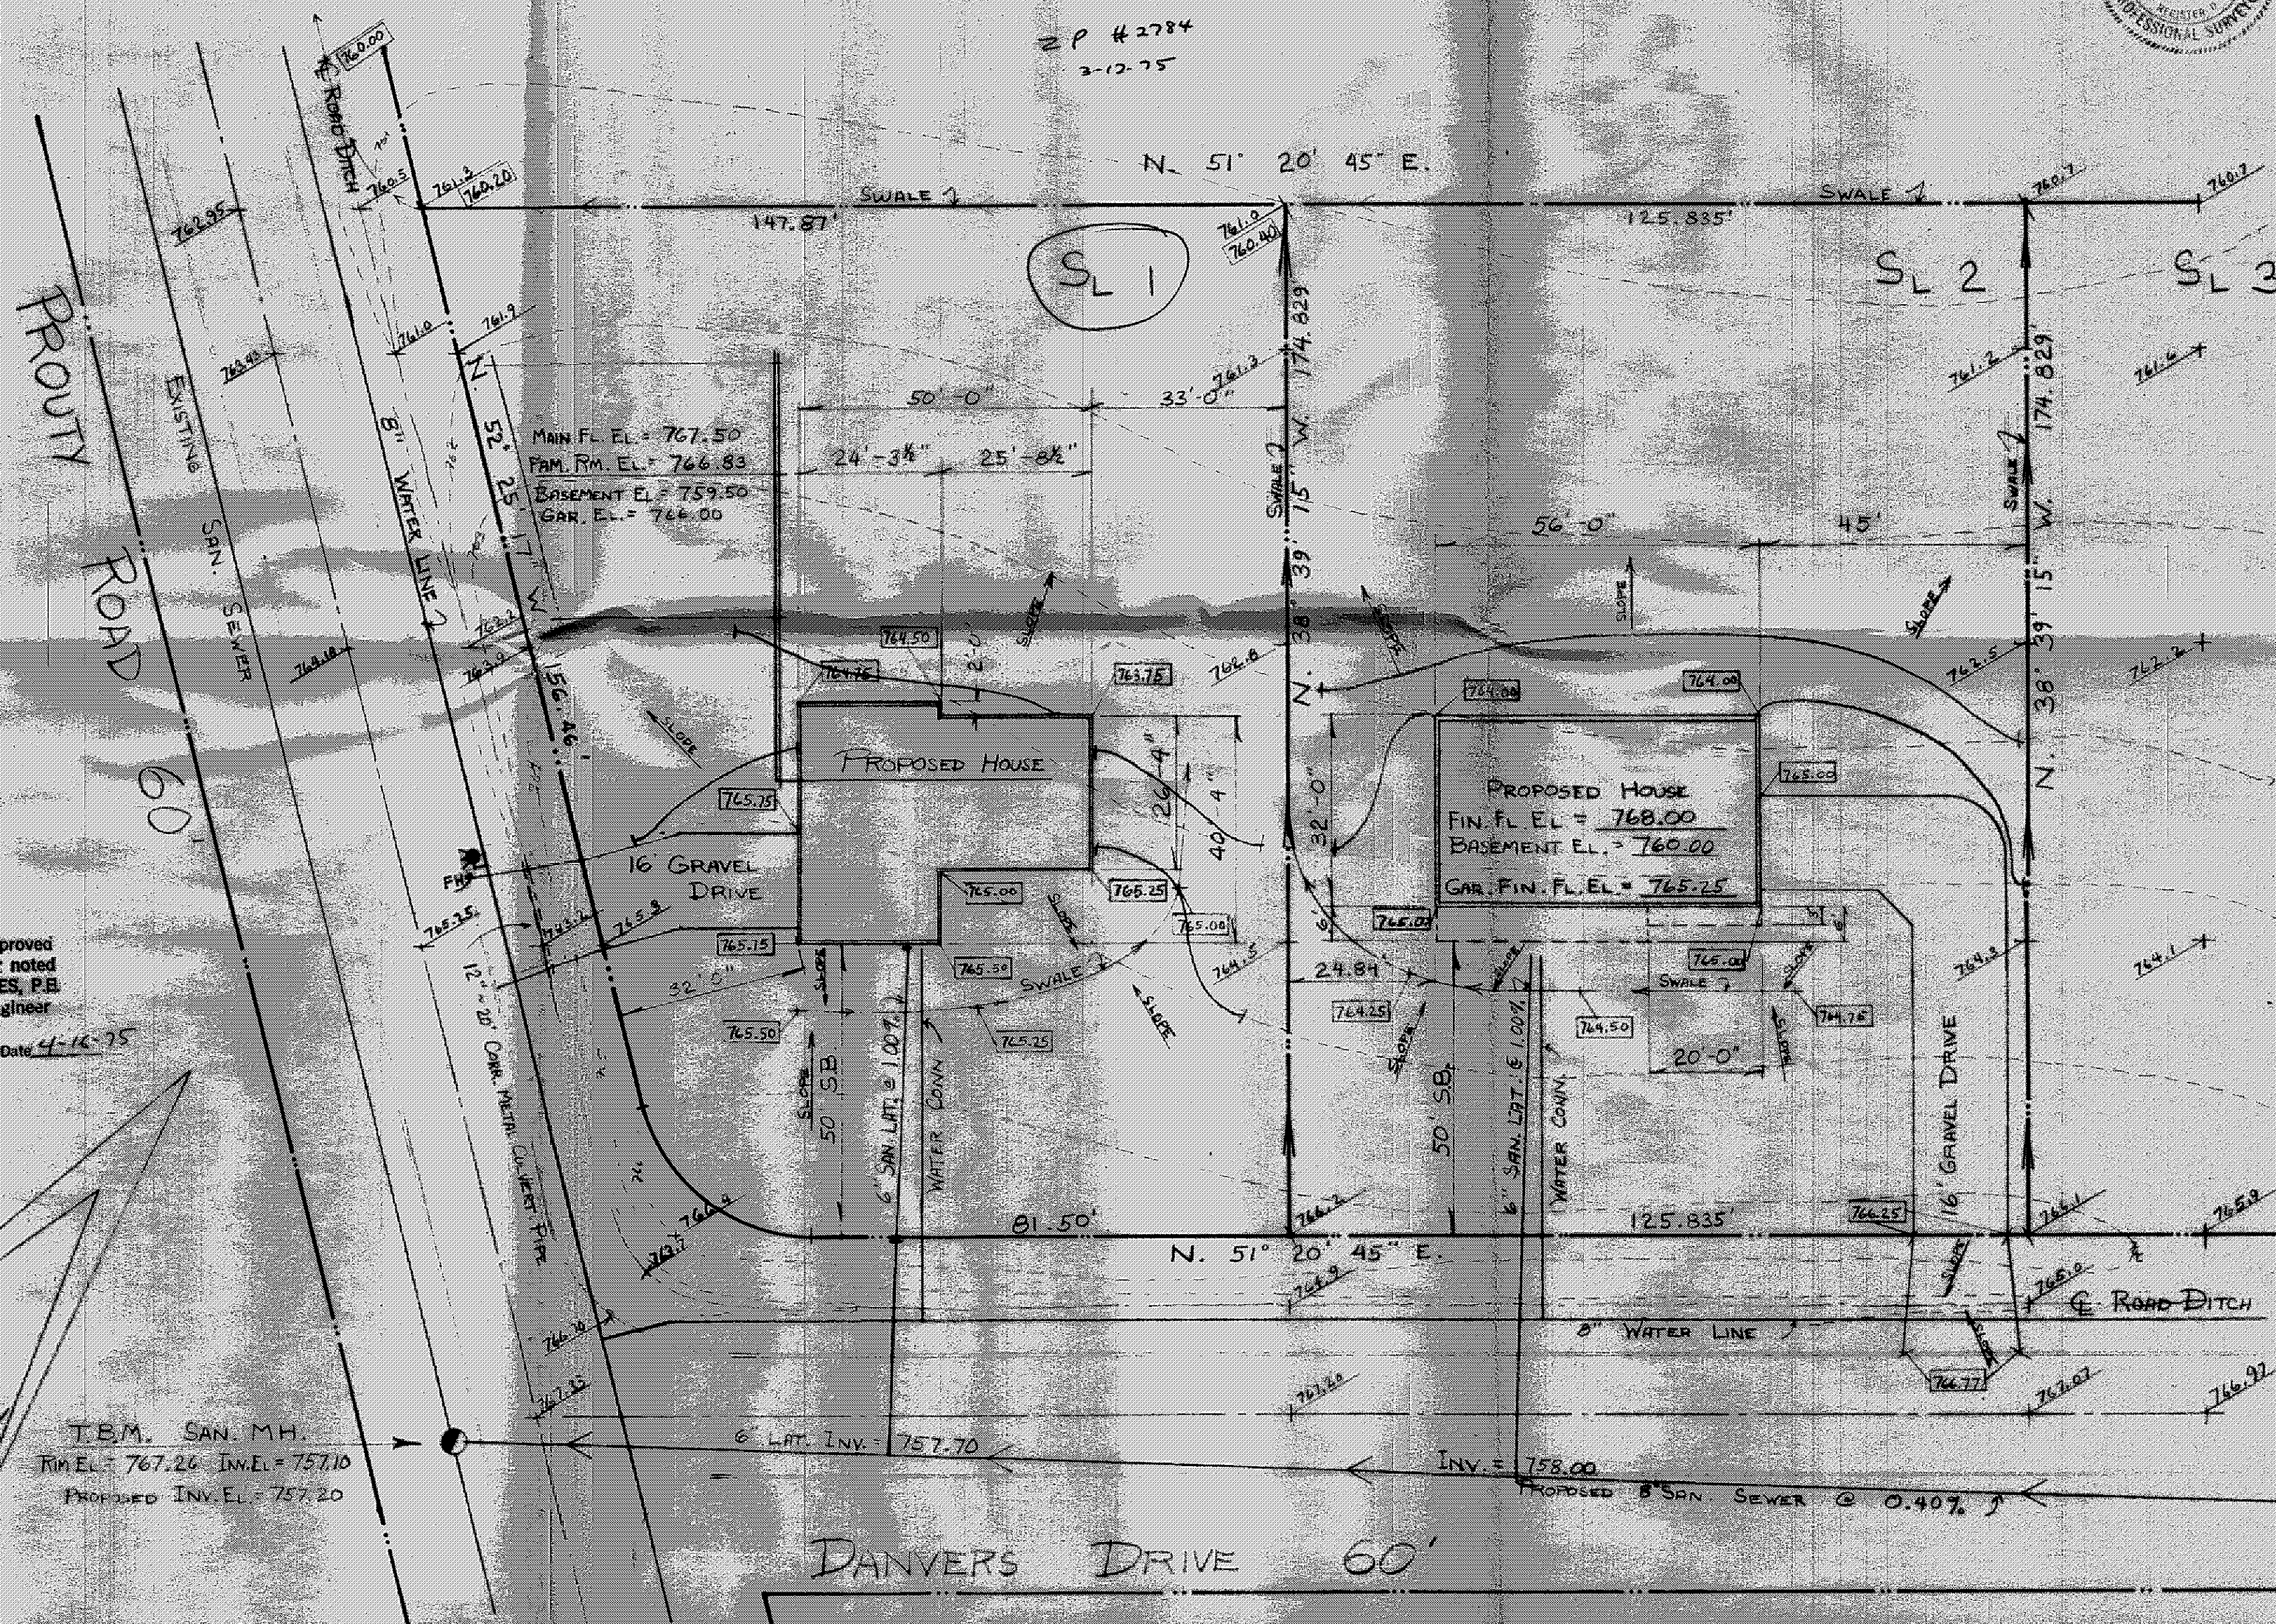

Grading Plan Approved
as shown and/or noted
THOMAS P. GILLES, P.E.
Lake County Engineer

T.B.M. SAN. MH.
RIM EL = 767.26 INV. EL = 757.10
PROPOSED INV. EL = 757.20