

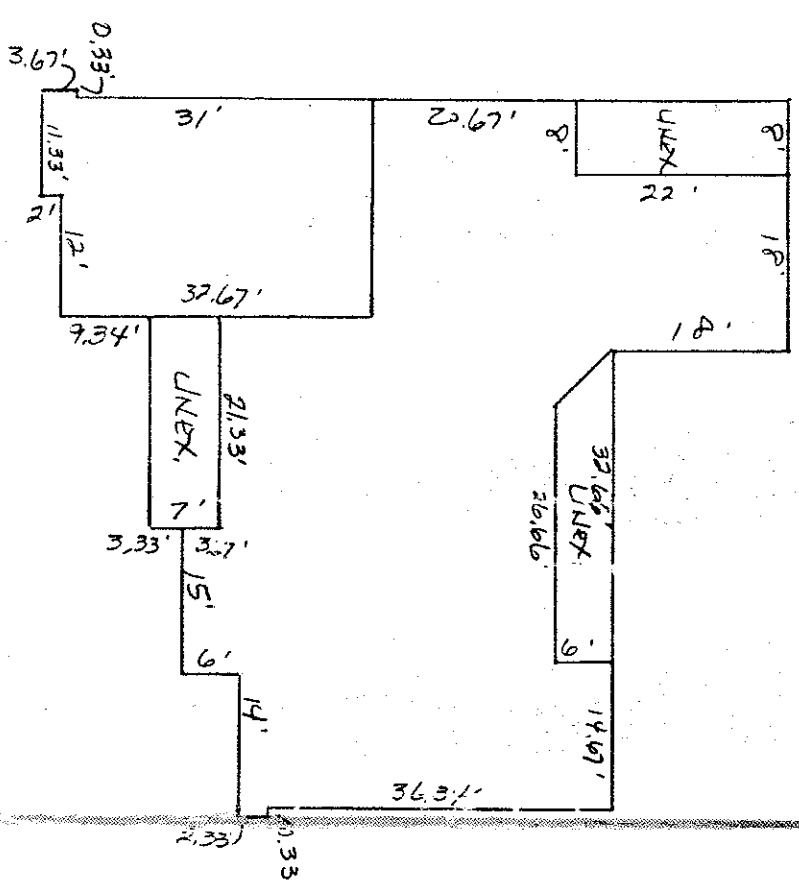


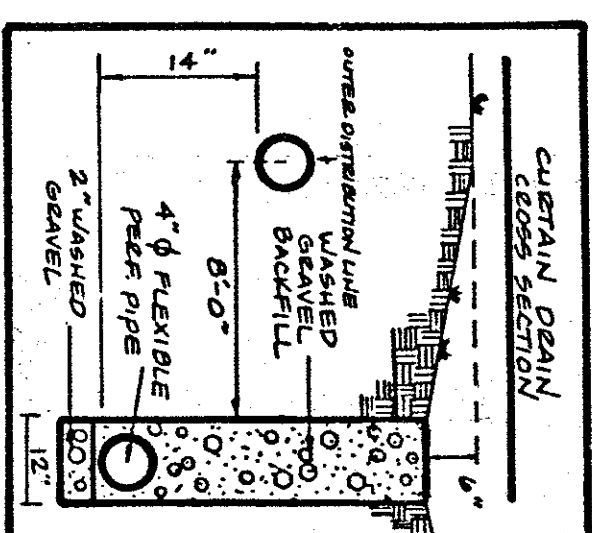

SCALE: 1"=20'

A=75.25'
R=70.00'
 $\Delta=61^{\circ}35'46''$
B=S 17° 45' 35" W
C=71.68'

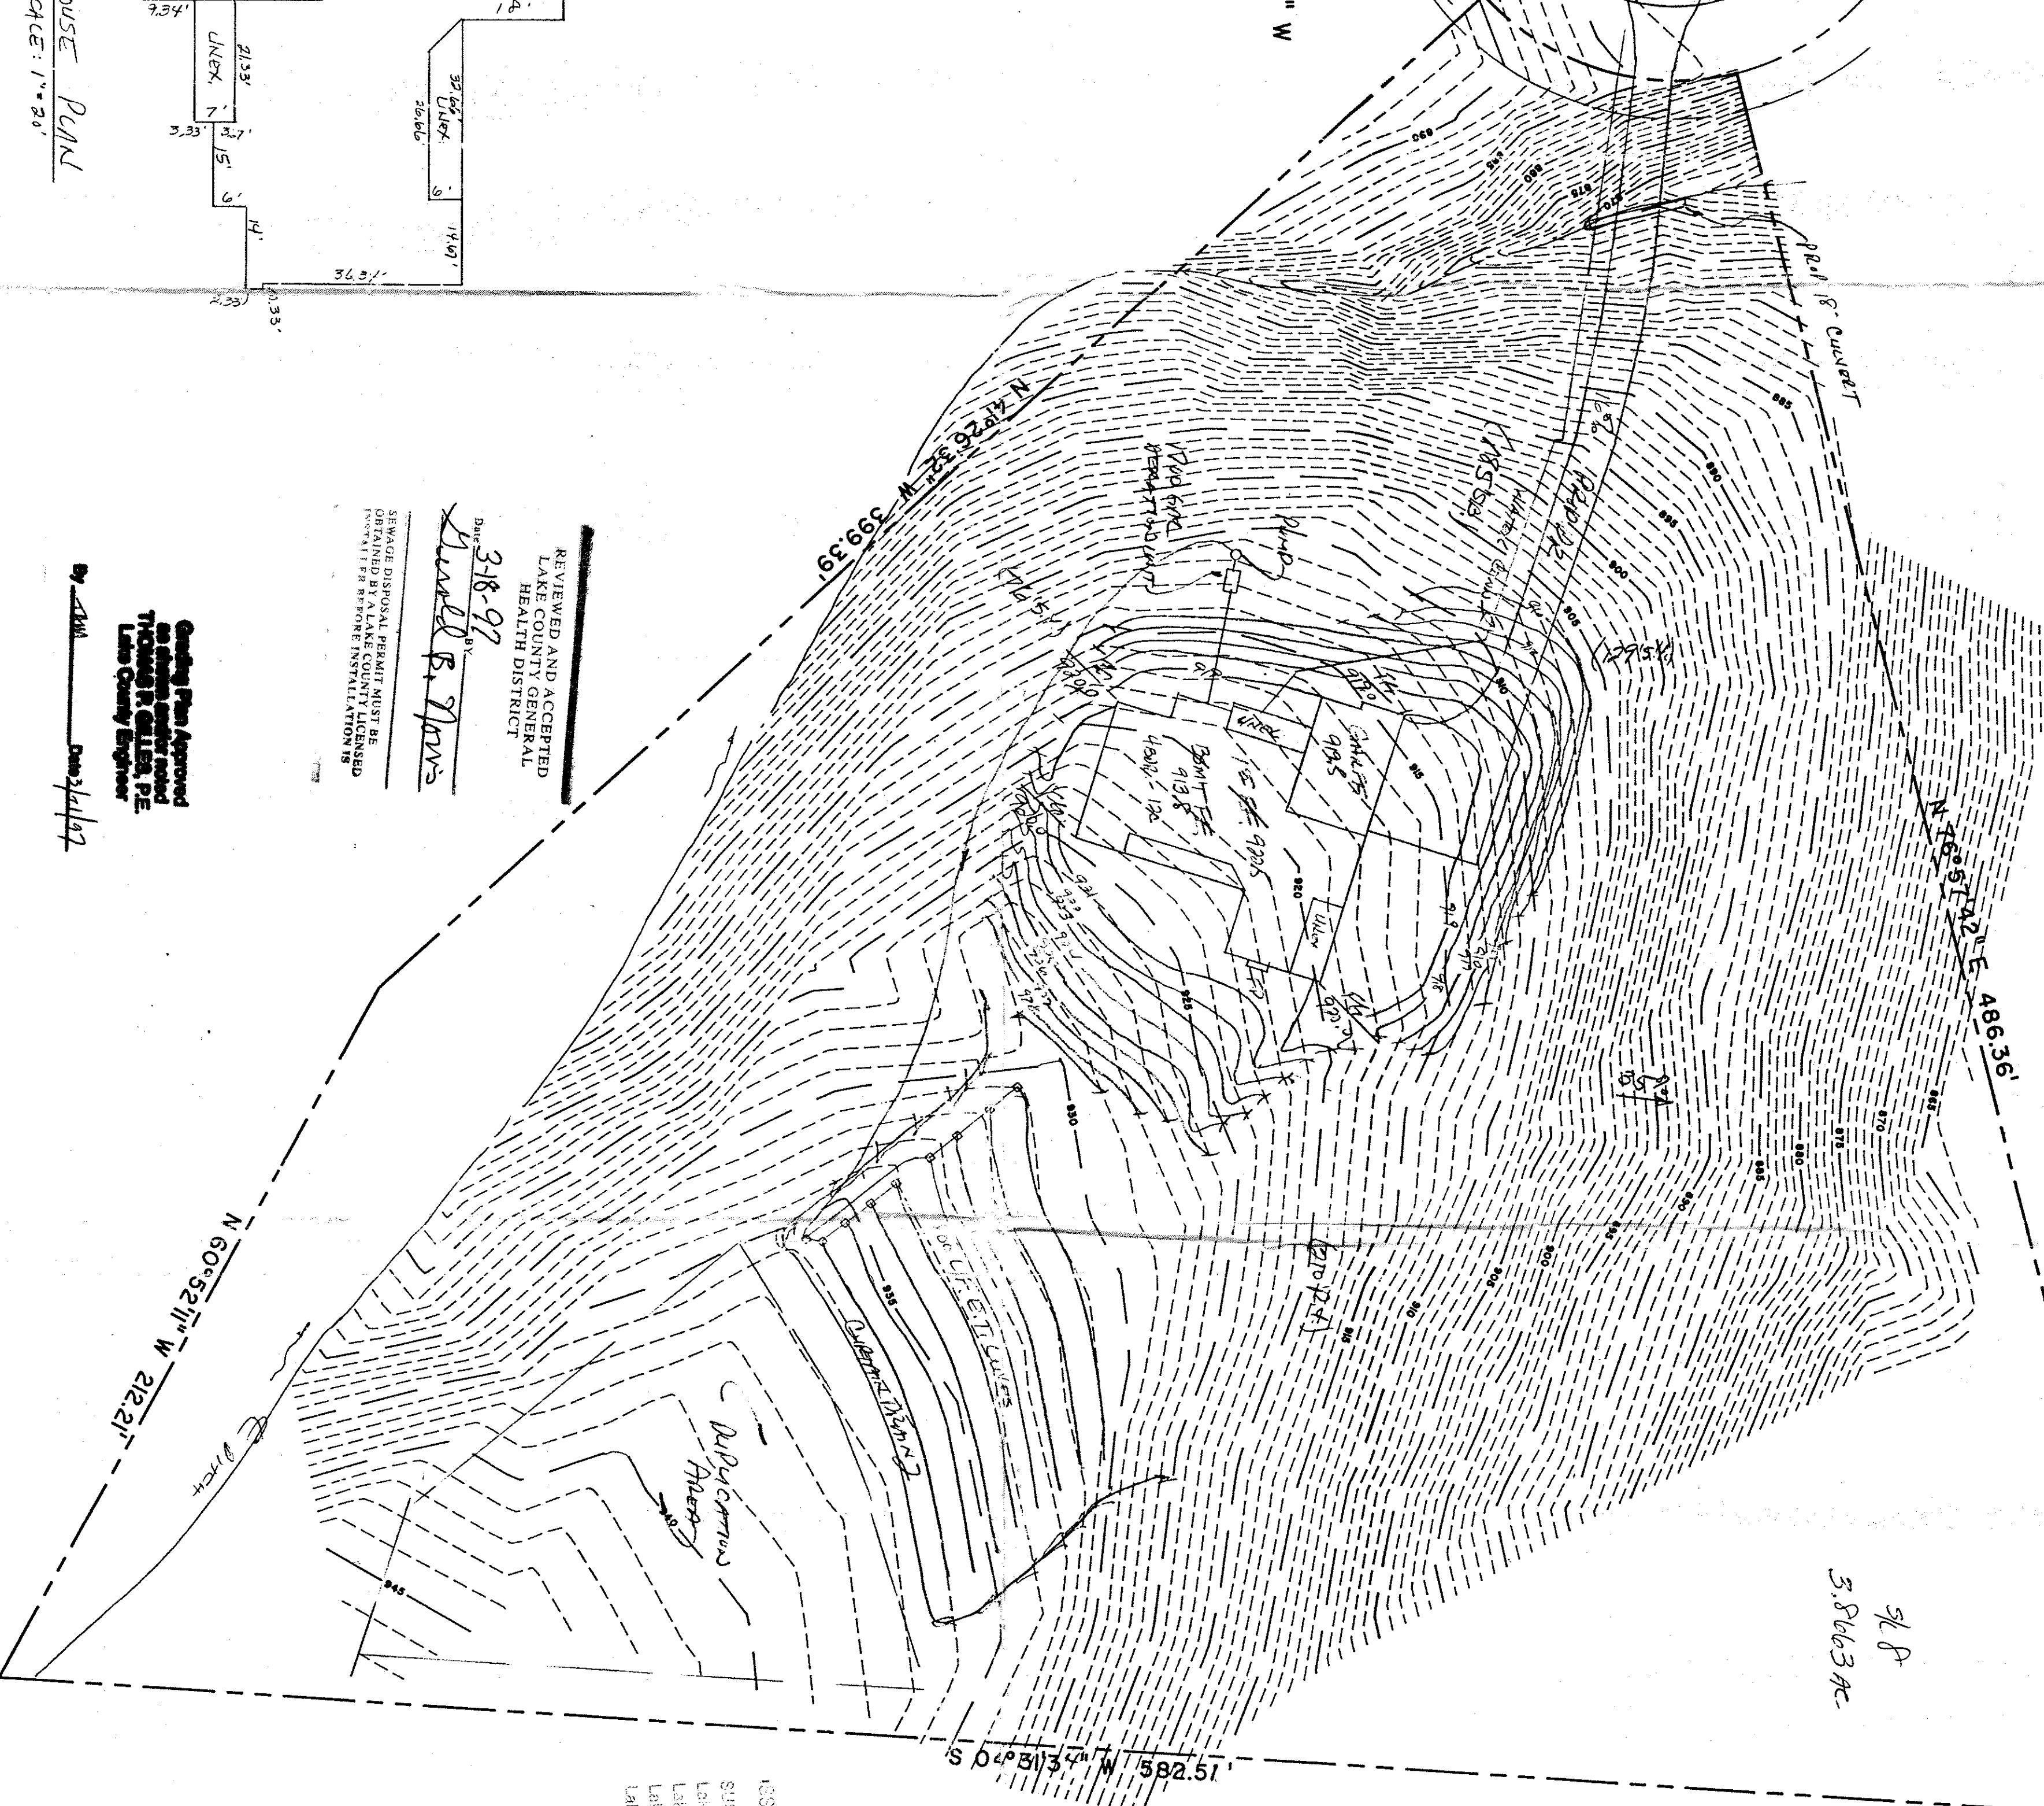

5/8
3.8663 Ac

ISSUED 3/14/57

ZONING PERMIT # 0357-8658

SUBJECT TO APPROVAL BY:

Lake County Planning Com. ☐


Lake County Eng. Dept. ☒

Lake County Planning Comm. ☐

Lake County Bldg. Dept. ☒

"I, the undersigned hereby certify that this topography indicated by 6", 1' or 2' contours, and elevations shown hereon represent an actual field survey made by me on the 24 day of Feb, 1957 and that the elevations were taken at appropriate intervals and that as of that date they existed as indicated hereon."


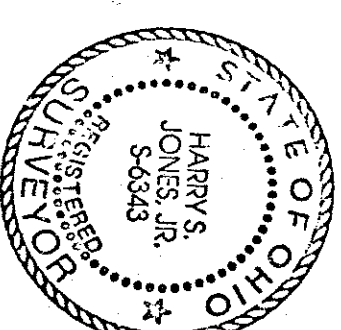[illegible]

JB **EABCOCK, JONES AND ASSOCIATES, INC.**
CIVIL ENGINEERS - SURVEYORS - LAND PLANNERS
PAINESVILLE OHIO 44077



DATE	Feb. 12, 1997
DESIGN BY	HTG
DRAWN BY	HTG
APPROVED BY	HTG

SITE PLAN
FOR
KAY HOMES
SUBLOT NO. 5 - Cmt 140005
LADIS COUNTY
Caledonia Township

SCALE 1"=30'	JOB NO 95-323-8
SHEET OF	