

EXISTING UNDERGROUND UTILITIES NOTE:
THE SIZE & LOCATION, BOTH HORIZONTAL AND VERTICAL, OF THE UNDERGROUND UTILITIES SHOWN HEREON, HAVE BEEN OBTAINED BY A SEARCH OF AVAILABLE RECORDS. VERIFICATION BY FIELD OBSERVATION HAS BEEN CONDUCTED WHERE PRACTICAL. HOWEVER, LDC INC. DOES NOT GUARANTEE THE COMPLETENESS NOR ACCURACY THEREOF.

 2 WORKING DAYS
BEFORE YOU DIG 
CALL TOLL FREE 800-362-2764
OHIO UTILITIES PROTECTION SERVICE

L.D.C. Inc. d.b.a.
LDCE
LAND DESIGN consultants
Civil Engineers and Surveyors
8686 EAST AVENUE • MENTOR, OHIO 44040
TELEPHONE 255-8463 354-6838 951-LAND


209 8.1.98
NAME

LOT DIMENSIONS & BEARINGS
TIE TO NEAREST STREET
SUBLOT No. (PARCEL No.)
SURROUNDING OWNERS
BURNED DIMENSIONS
SETBACKS, DRIVEWAY, REARYARD
FINISHED GRACES
DRIVE & APRON TYPE, WIDTH, THICKNESS
SIDEWALK TYPE, WIDTH, THICKNESS
CULVERT, DRAIN, DRAINAGE
WATER MAIN SIZE, LOCATION
SAN. SEWER SIZE, & GRADE, LOD.
SAN. MH. CAST. ELEV., INV. ELEV.
STORM SEWER SIZE, & GRADE, LOD.
STORM MH. CAST. ELEV., INV. ELEV.
PUMP, BACKFLOW PREVENTER
GAS LINE LOD., SIZE
SEPTIC SYSTEM & DUPLICATION
WELL LOCATION & ISOLATION RADIUS



LEGEND STORM MANHOLE SANITARY MANHOLE EXISTING CONTOURS PROPOSED CONTOURS EAST. ELEV. 100.0 100.0 PROP. ELEV. DIRECTION OF SURFACE DRAINAGE	DRAWN BY M.G.P./J.B.R.		SCALE 1" = 30'		
	CHK'D BY R.A.T.		DATE 07.31.98		
	1				
	2				

Mon. Box At Radius Pt. Of	
Cul-De-Sac Exmoor Dr.	
Rim Elev. 775.01	

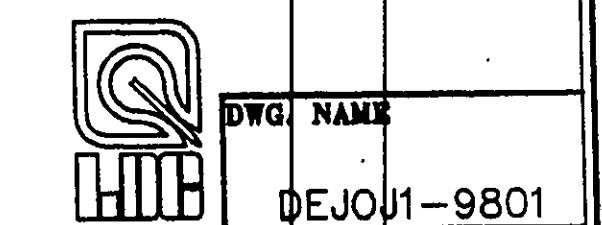

HYDRAULIC PROFILE
SCALE: HORIZ. 1" = 30'
VERT. 1" = 5'

By TAM Date 2/22/99
 _____ TO 15" PER LDC DRAINAGE CALLS.

SAYBROOK,
DRIVE 60,