

SITE PLAN:

RYAN HOMES

8141 TYLER BLVD.
MENTOR, OHIO

BEING SUBLLOT NUMBER
1 IN FAR HILLS ESTATES
SUBDIVISION IN CONCORD
TOWNSHIP, OHIO

PREPARED BY:

WM. R. GRAY ASSOC. INC.

7547 MENTOR AVENUE
MENTOR, OHIO

SCALE: 1" = 30'

DATE: JUNE 17, 1977


REV: JUNE 23, 1977

Grading plan approved
as shown and/or noted
THOMAS P. GILLES, P.E.
Lake County Engineer
By D.J.L. Date 7/1/77

CERTIFICATION:

I HERBY CERTIFY THAT
THIS PLAT IS CORRECT TO
THE BEST OF MY KNOWLEDGE
BY Terrence Gerson
TERRENCE GERSON, P.E.

LEGEND
EXIST. GROUND
PROP. GROUND

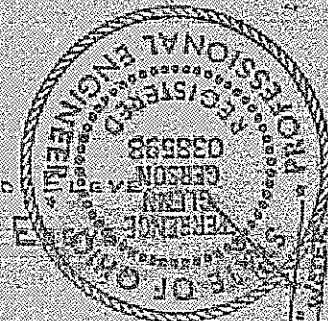

REVISSED
ZONING PERMIT
APPROVED
6-23-77
H.E. Mansfield

*CURVE DATA

R=2904.93'
Δ=2°06'52"
A=107.20'
C=107.20'
S 7°01'51"E

S/L 2

S 75°06'20"E 326.08'

S 75°06'20"E 377.15'

PROP. HSE.
FIN. FLR. = 862.8
GRN. FLR. = 861.5

SAN. CONN.
WATER CONN.

20" CONC. PARALLEL

18" SAN. SEWER

CHRISTIAN AVE 60'

FAR HILLS 60'

SAN. MAN.
RM = 85302
NO. 85302