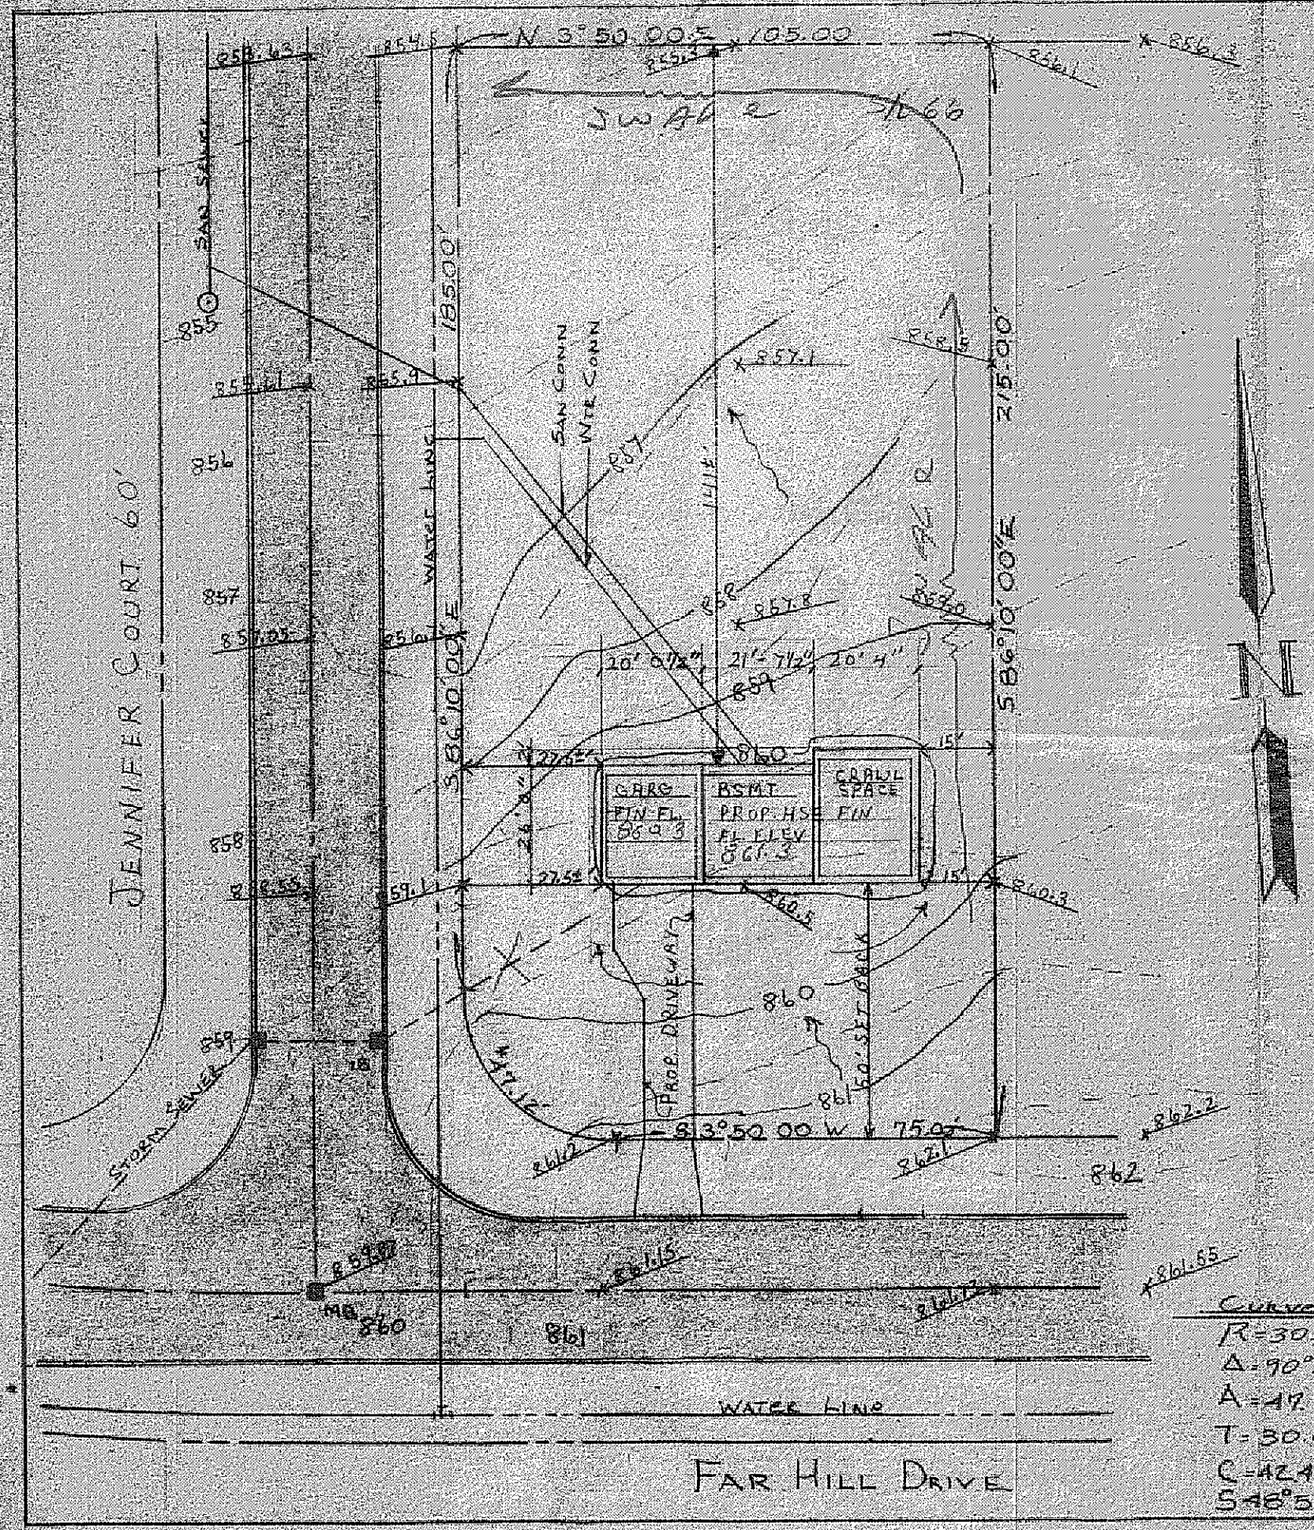

Curve Data*
R=30.00
Δ=90°00'00"
A=47.12
T=30.00
C=42.43
S 48°50'00"W

Site Plan:

Ryan Homes
8141 Tyler Blvd
Mentor Ohio
Being Sublot Number 66
In The Far Hills Estates
No 2 Subdivision In Concord
Township Lake County Ohio

Prepared By:

Wm R Gray Assoc Inc.
7547 Mentor Ave
Mentor, Ohio #3425
Scale: 1" = 30
Date: Sept 8, 1977

ZONING PERMIT
Approved 9-12-77

Certification:

I Hereby Certify That
This Plat Is Correct To
The Best Of My Knowledge
By: Wm R Gray
Wm R Gray Reg Surv #2752

Grading Plan Approved
as shown and/or noted
THOMAS P. GILLES, P.E.
Lake County Engineer
By TG Date 14 Sept 77

NO STM. CONN.

STATE OF OHIO
WM. R. GRAY
2752
REGISTERED
PROFESSIONAL SURVEYOR