


SEWAGE DISPOSAL PERMIT MUST BE OBTAINED BY A LAKE COUNTY LICENSED INSTALLER BEFORE INSTALLATION IS STARTED.

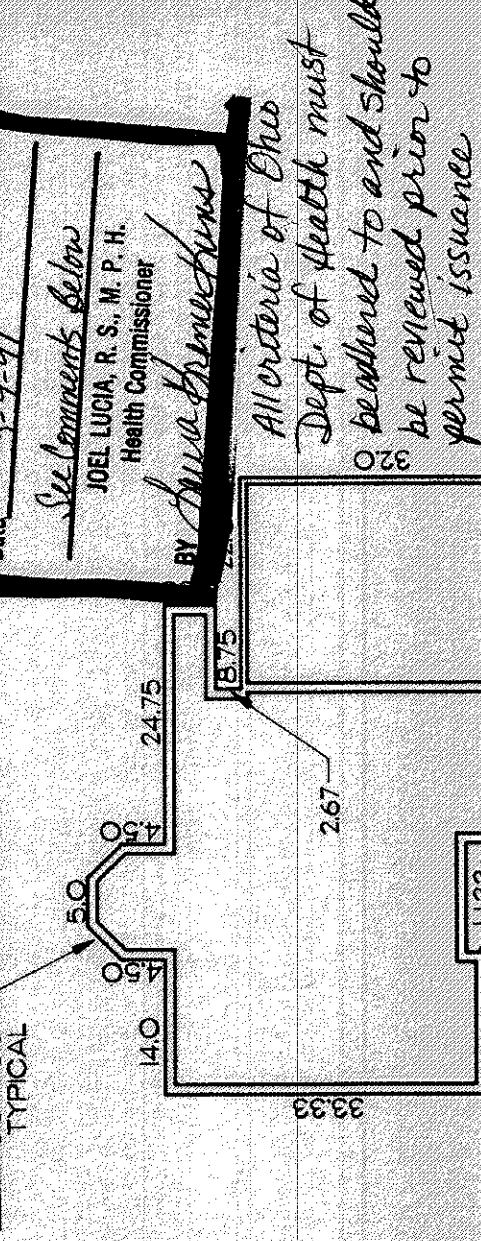

LOW YIELD WATER FIXTURES REQUIRED ON ALL Shower Head Toilet

BUILDING CONSTRUCTION SHALL COMPLY TO ALL APPLICABLE REGULATIONS OF THE LAKE COUNTY BUILDING DEPARTMENT.

RESIDENCE MUST UTILIZE WATER TOILETS, SHOWERHEADS, AND FALCETS. DRAINAGE IMPROVEMENTS OR CHANGES FROM EXISTING GRADE NOTED ON THE APPROVED PLAN SHALL BE INSTALLED PRIOR TO SEWAGE DISPOSAL SYSTEM CONSTRUCTION.

NO OPEN BURNING WILL OCCUR DURING CONSTRUCTION. DOWNSPOUTS AND FOOTER DRAINS SHALL BE CONNECTED TO THE MOUND SYSTEM CLEAN DRAIN AS SHOWN ON THE PLANS.

SURFACE WATER SHALL BE DIVERTED AWAY FROM THE MOUND AREA BY THE USE OF SWALES. SEWAGE LIFT PUMP SHALL BE CAPABLE OF LIFTING RESIDENTIAL SEWAGE EFFLUENT AT A RATE OF 60 GPM AT 13.5 FT. OF HEAD. THE PUMPING CHAMBER SHALL HAVE A MINIMUM CAPACITY OF 750 GALLONS. THE PUMP LEVEL SHALL BE ADJUSTED TO PROVIDE FOR A 15 TO 200 GALLON DRAINAGE VOLUME TO THE MOUND.

ELECTRICAL WORK & EQUIPMENT SHALL CONFORM WITH THE CURRENT EDITION OF THE NATIONAL ELECTRICAL CODE.

MECHANICAL COMPONENTS SHALL BE INSTALLED IN A PROPERLY VENTED LOCATION AND ALL VENTS, AIR INTAKES AND AIR HOSES SHALL BE PROTECTED FROM SNOW, ICE OR WATER AND ACCUMULATIONS. INSTALLATION SHALL BE MADE TO MINIMIZE RELEASE OF ODORS AND AEROSOLS.

MECHANICAL COMPONENTS INSTALLED IN OR AT THE SEWAGE TANK SHALL BE PROTECTED AGAINST DAMAGE OR IMPROVEMENT FROM EXCESSIVE WEIGHTS OR IMPACTS. DRAINAGE PUMPS MUST BE REMOVABLE FROM THE MANHOLE CASE OF PUMP FAILURE.

THROTTLE VALVE SHALL BE EASILY ACCESSIBLE FROM INSIDE OF PUMPING CHAMBER.

CONSTRUCTION NOTES

LOCATION OF MOUND TO BE ESTABLISHED BY CONTRACTOR PRIOR TO BEGINNING CONSTRUCTION. MEASURE THE AVERAGE GROUND ELEVATION ALONG THE UPSLOPE EDGE OF THE UPPER TRENCH. BOTTOM ELEVATION OF THE TRENCHES TO BE A MINIMUM OF 18" ABOVE THIS ELEVATION AS SHOWN ON THE DETAIL.

DETERMINE WHERE THE PIPE FROM THE PUMPING CHAMBER CONNECTS TO THE DISTRIBUTION SYSTEM IN THE MOUND.

TRENCH AND LAY THE EFFLUENT PIPE FROM THE PUMPING CHAMBER TO THE MOUND. LAY THE PIPE IN THE TRENCHES. THE GROUND SURFACE LAY PIPE BELOW FRONT LINE. SLOPE UNFORMALLY BACK TO THE PUMPING CHAMBER SO THAT THE LINE DRAINS AFTER DOWNS BACKFILL AND COMPACT SOIL AROUND PIPE TO PREVENT BACK SEEPAGE OF EFFLUENT ALONG THE PIPE.

CHECK THE MOISTURE CONTENT OF THE SOIL AT 7-8 IN. DEEP. IF IT IS TOO WET, SNEAKING AND COMPACT WILL RESULT. SOIL MOISTURE CAN BE DETERMINED BY ROLLING A SOIL SAMPLE BETWEEN THE HANDS. IT ROLLS INTO A BALL. THE SITE IS TOO WET TO PREPARE FILL. CRUMBLE. SOIL PREPARATION CONTINUED.

CUT TREES TO GROUND LEVEL. REMOVE EXCESS VEGETATION BY MOWING. PREPARE THE SITE USING A MOUNDING SYSTEM. MOWING AND WEEDING SHALL BE COMPLETED AS SOON AS THE BASE AREA HAS BEEN FLOWED. THE CONTRACTOR SHALL AVOID ROUTING OF FLOWED AREA WITH VEHICULAR TRAFFIC.

EXTEND THE EFFLUENT PIPE TO SEVERAL FEET ABOVE THE GROUND SURFACE. PLACE THE FILL MATERIAL WHICH HAS BEEN PROPERLY SELECTED AROUND THE EDGE OF THE FLOWED AREA. KEEP WHEELS OF TRUCK OFF FLOWED AREA. PREVENT TRAFFIC ON THE DOWNSLOPE SIDE OF THE MOUND. WORK FROM THE END AND UPSLOPE SIDE.

MOVE THE FILL MATERIAL INTO PLACE USING A SMALL TRACK TYPE TRACTOR WITH A BLADE ALWAYS KEEP A MINIMUM OF 6" OF SAND BENEATH TRACKS TO PREVENT COMPACTION OF THE NATURAL SOIL.

PLACE THE FILL MATERIAL TO THE REQUIRED DEPTH WHICH IS THE TOP OF THE TRENCHES. SHAPE SLOES TO THE DESIRED SLOPE.

WITH THE BLADE OF THE TRACTOR, FORM THE TRENCHES. HAND LEVEL THE BOTTOM OF THE TRENCHES. THE BOTTOMS SHALL BE AT THE SAME ELEVATION AND LEVEL.

PLACE THE COARSE AGGREGATE IN THE TRENCHES. AGGREGATE SHALL BE 1/2" IN NON-DETERIORATING AGGREGATE.

PLACE THE DISTRIBUTION SYSTEM ON THE AGGREGATE. CONVERT THE MANHOLE TO THE PUMPING CHAMBER. SLOPE MANHOLE TO EFFLUENT PIPE LAY LATERALS LEVEL. REMOVING RIDGES AND DIPS.

PLACE 2 IN. OF AGGREGATE OVER THE DISTRIBUTION PIPES.

PLACE 4-5 IN. OF UNCOMPACTED STRAW OR MARSH HAY. UNTREATED BUILDING PAPER OR A SYNTHETIC FABRIC, SUCH AS TYFAR, MARFIL OR THE EQUIVALENT OVER AGGREGATE.

PLACE SOIL ON TOP OF THE TRENCHES TO A DEPTH OF 1 FT. IN THE CENTER AND 6 IN. AT THE OUTER EDGE OF THE TRENCHES. THIS MAY BE A SUBSOIL OR TOPSOIL.

PLACE 6 IN. OF GOOD QUALITY TOPSOIL OVER THE SUBSOIL. MOUND SURFACE THIS WILL RAISE THE ELEVATION AT THE CENTER OF THE MOUND TO A MINIMUM OF 15 FT. AND THE OUTSIDE EDGES OF THE TRENCHES TO 10 FT.

LANDSCAPE THE MOUND BY SEEDING AND MULCHING. A MATURE 4" DIA. TREE OR 10" DIA. SHRUB MAY BE USED IN THE MOUND. IT WILL NOT BE MANICURED. IF MANICURING IS DESIRED, A COMBINATION OF 60% BLUEGRASS, 30% CREEPING RED FESCUE AND 10% ANNUAL RYE GRASS MAY BE USED. SEEDS CAN BE PLANTED AROUND THE MOUND. THE SEEDS SHOULD BE COVERED WITH A 1/2" LAYER OF TOPSOIL. THE TOP OF THE MOUND MAY BE SOAKED AT MOST DURING VARIOUS TIMES OF THE YEAR.

INSPECTION NOTE

IN ADDITION TO THE INSPECTIONS CONDUCTED BY THE BOARD OF HEALTH, THE MOUND CONSTRUCTION SHALL BE INSPECTED BY THE DESIGNER AS FOLLOWS:

1. AFTER PREPARATION OF THE EXISTING GROUND PRIOR TO PLACING THE FILL.
2. AFTER THE DISTRIBUTION LINES ARE IN PLACE.
3. AFTER FINISH GRADING AND SEEDING IS COMPLETED.

CONTRACTOR SHALL ALLOW INSPECTION BY CALLING S. J. LESSMAN, P.E. 667-2525 AT LEAST 48 HOURS BEFORE INSPECTION IS REQUIRED.

Reviewed and Accepted
LAKE COUNTY GENERAL HEALTH DISTRICT
Date: 3-11-91
Seal: [Signature]
JOEL LUDIA, R.S., M.P., H.
Health Commissioner

Alvordina of Ohio
Dept. of Health must
be notified to and should
be reviewed prior to
permit issuance



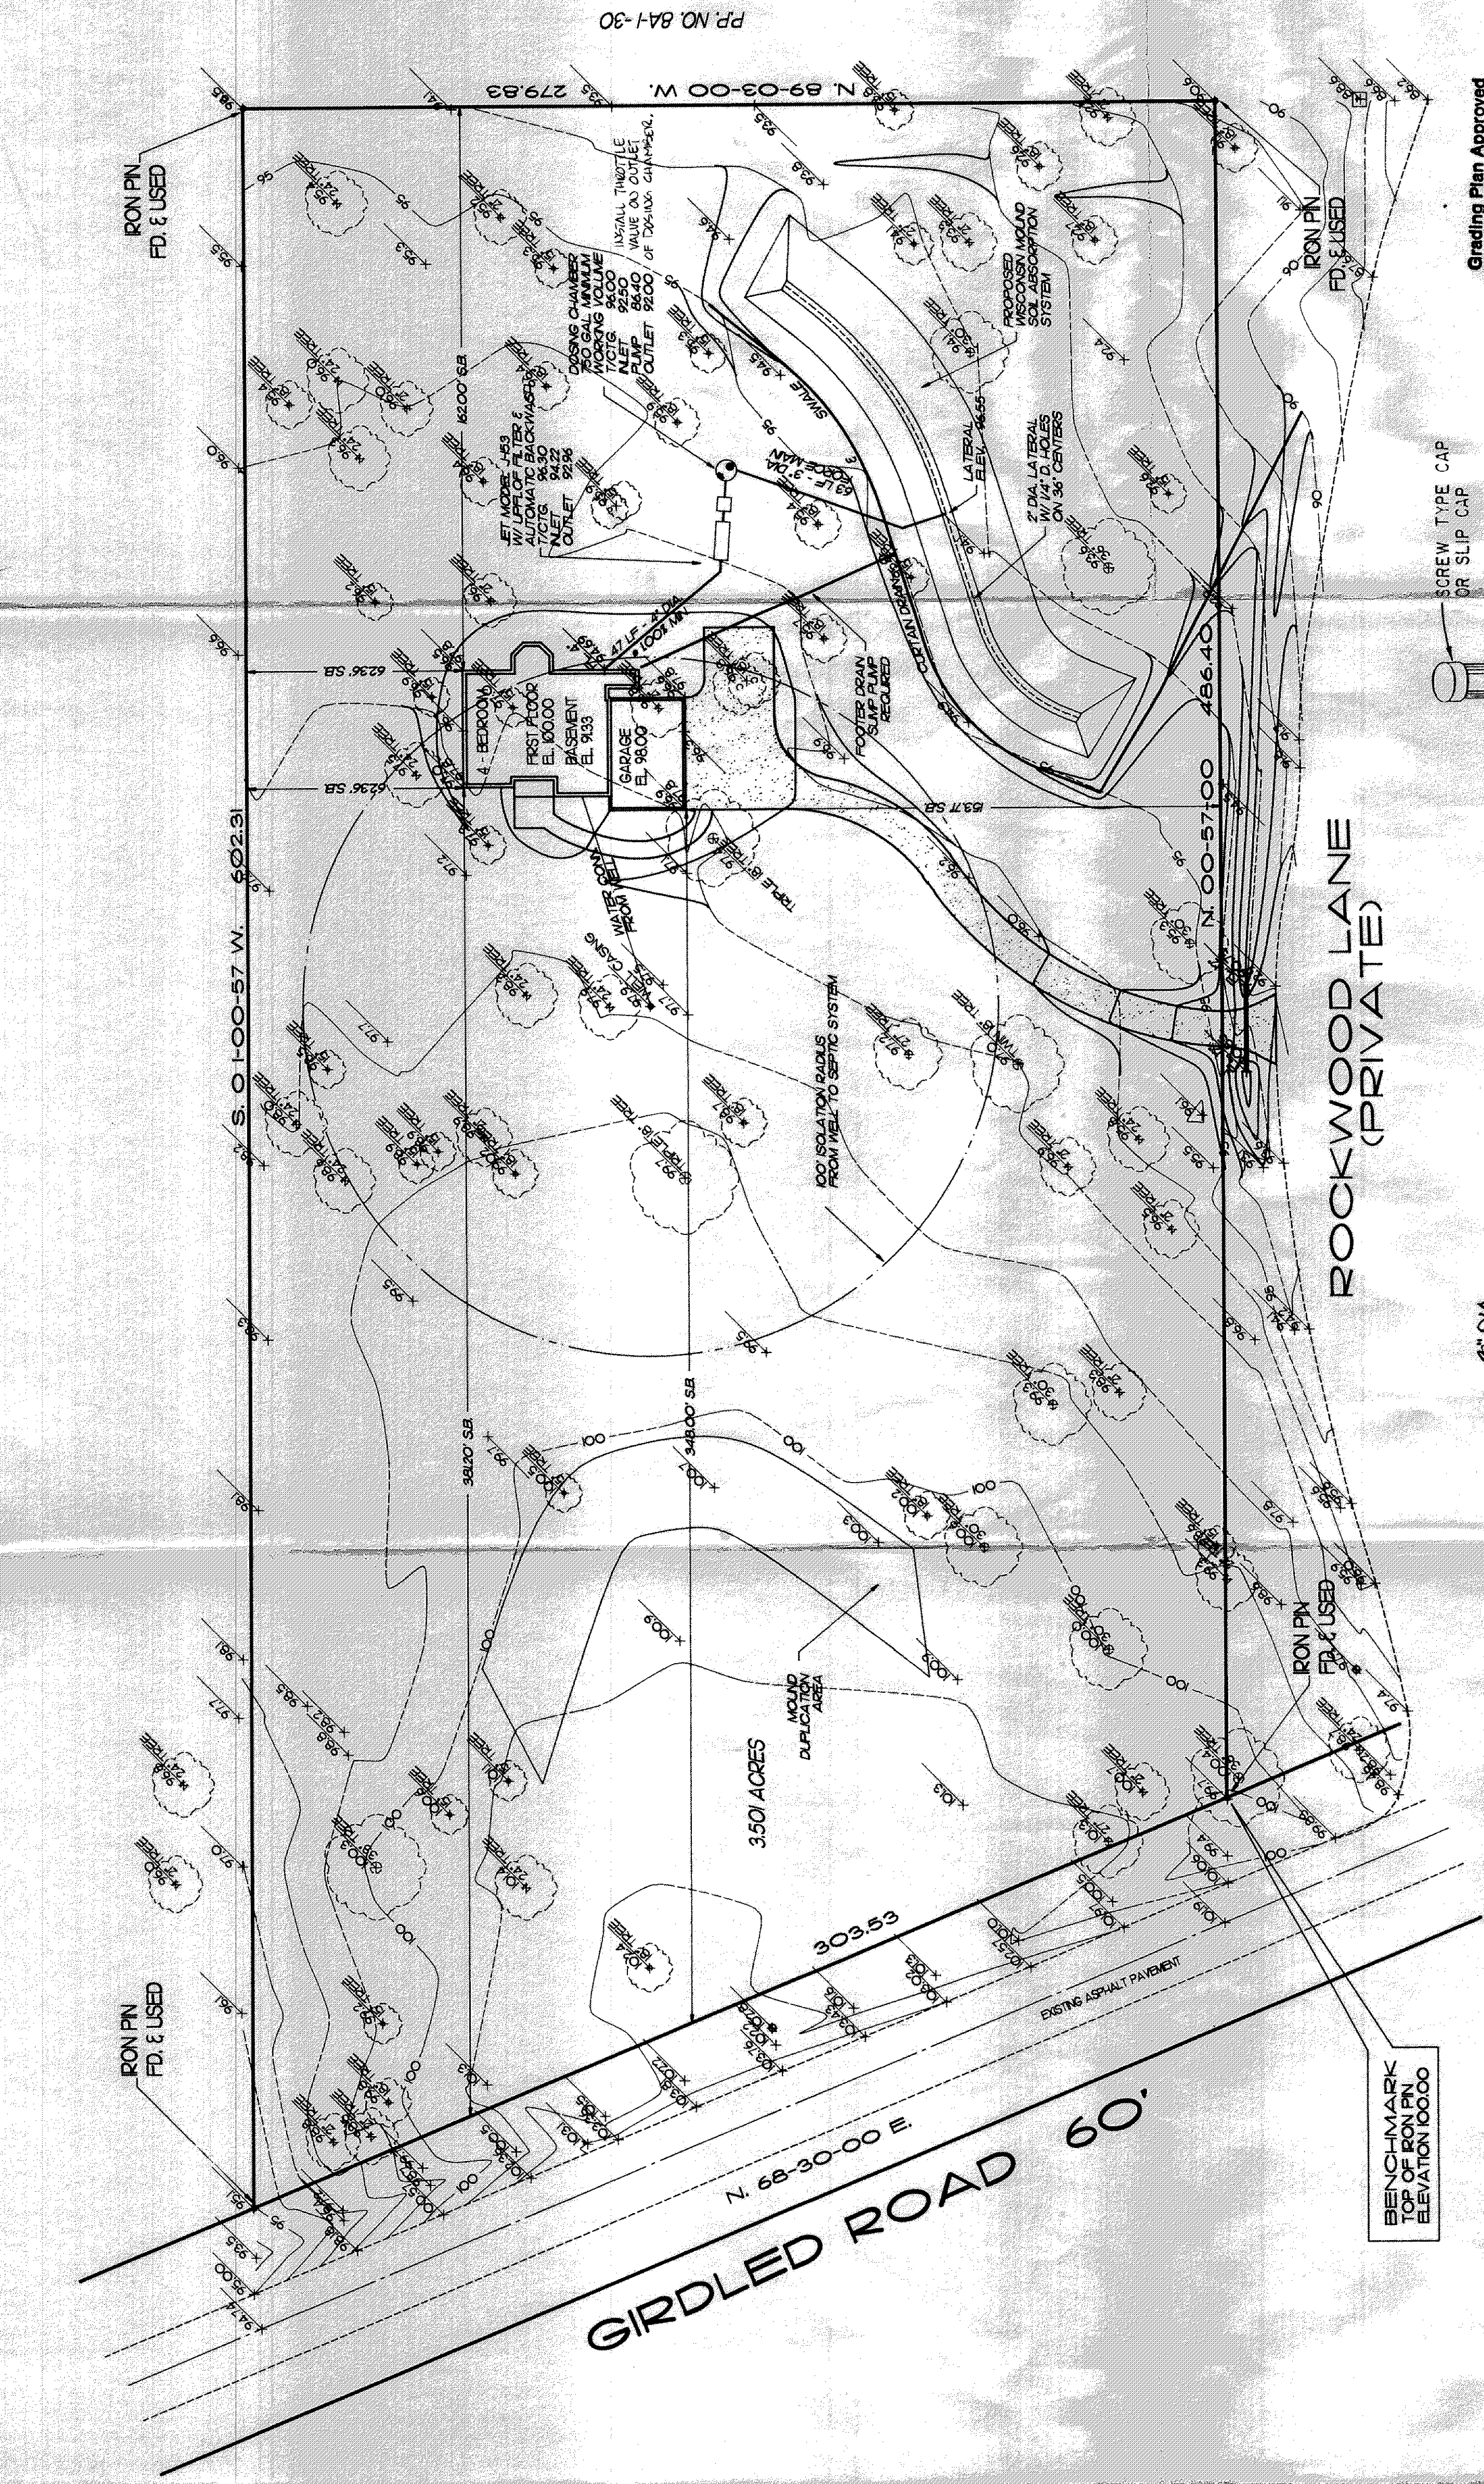

Grading Plan Approved
shown and/or noted
THOMAS P. GILLES, P.E.
Lake County Engineer
by GPH Date 3/11/91
OUTLET FOR CURTAIN DRAIN
TO ROADSIDE DITCH

SCREW TYPE CAP
OR SLIP CAP
4" PVC PIPE
(LENGTH VARIES)
4" PVC TEE

SCREW TYPE CAP
OR SLIP CAP
4" PVC PIPE
(LENGTH VARIES)
TOILET RING
1/4" SLOT


