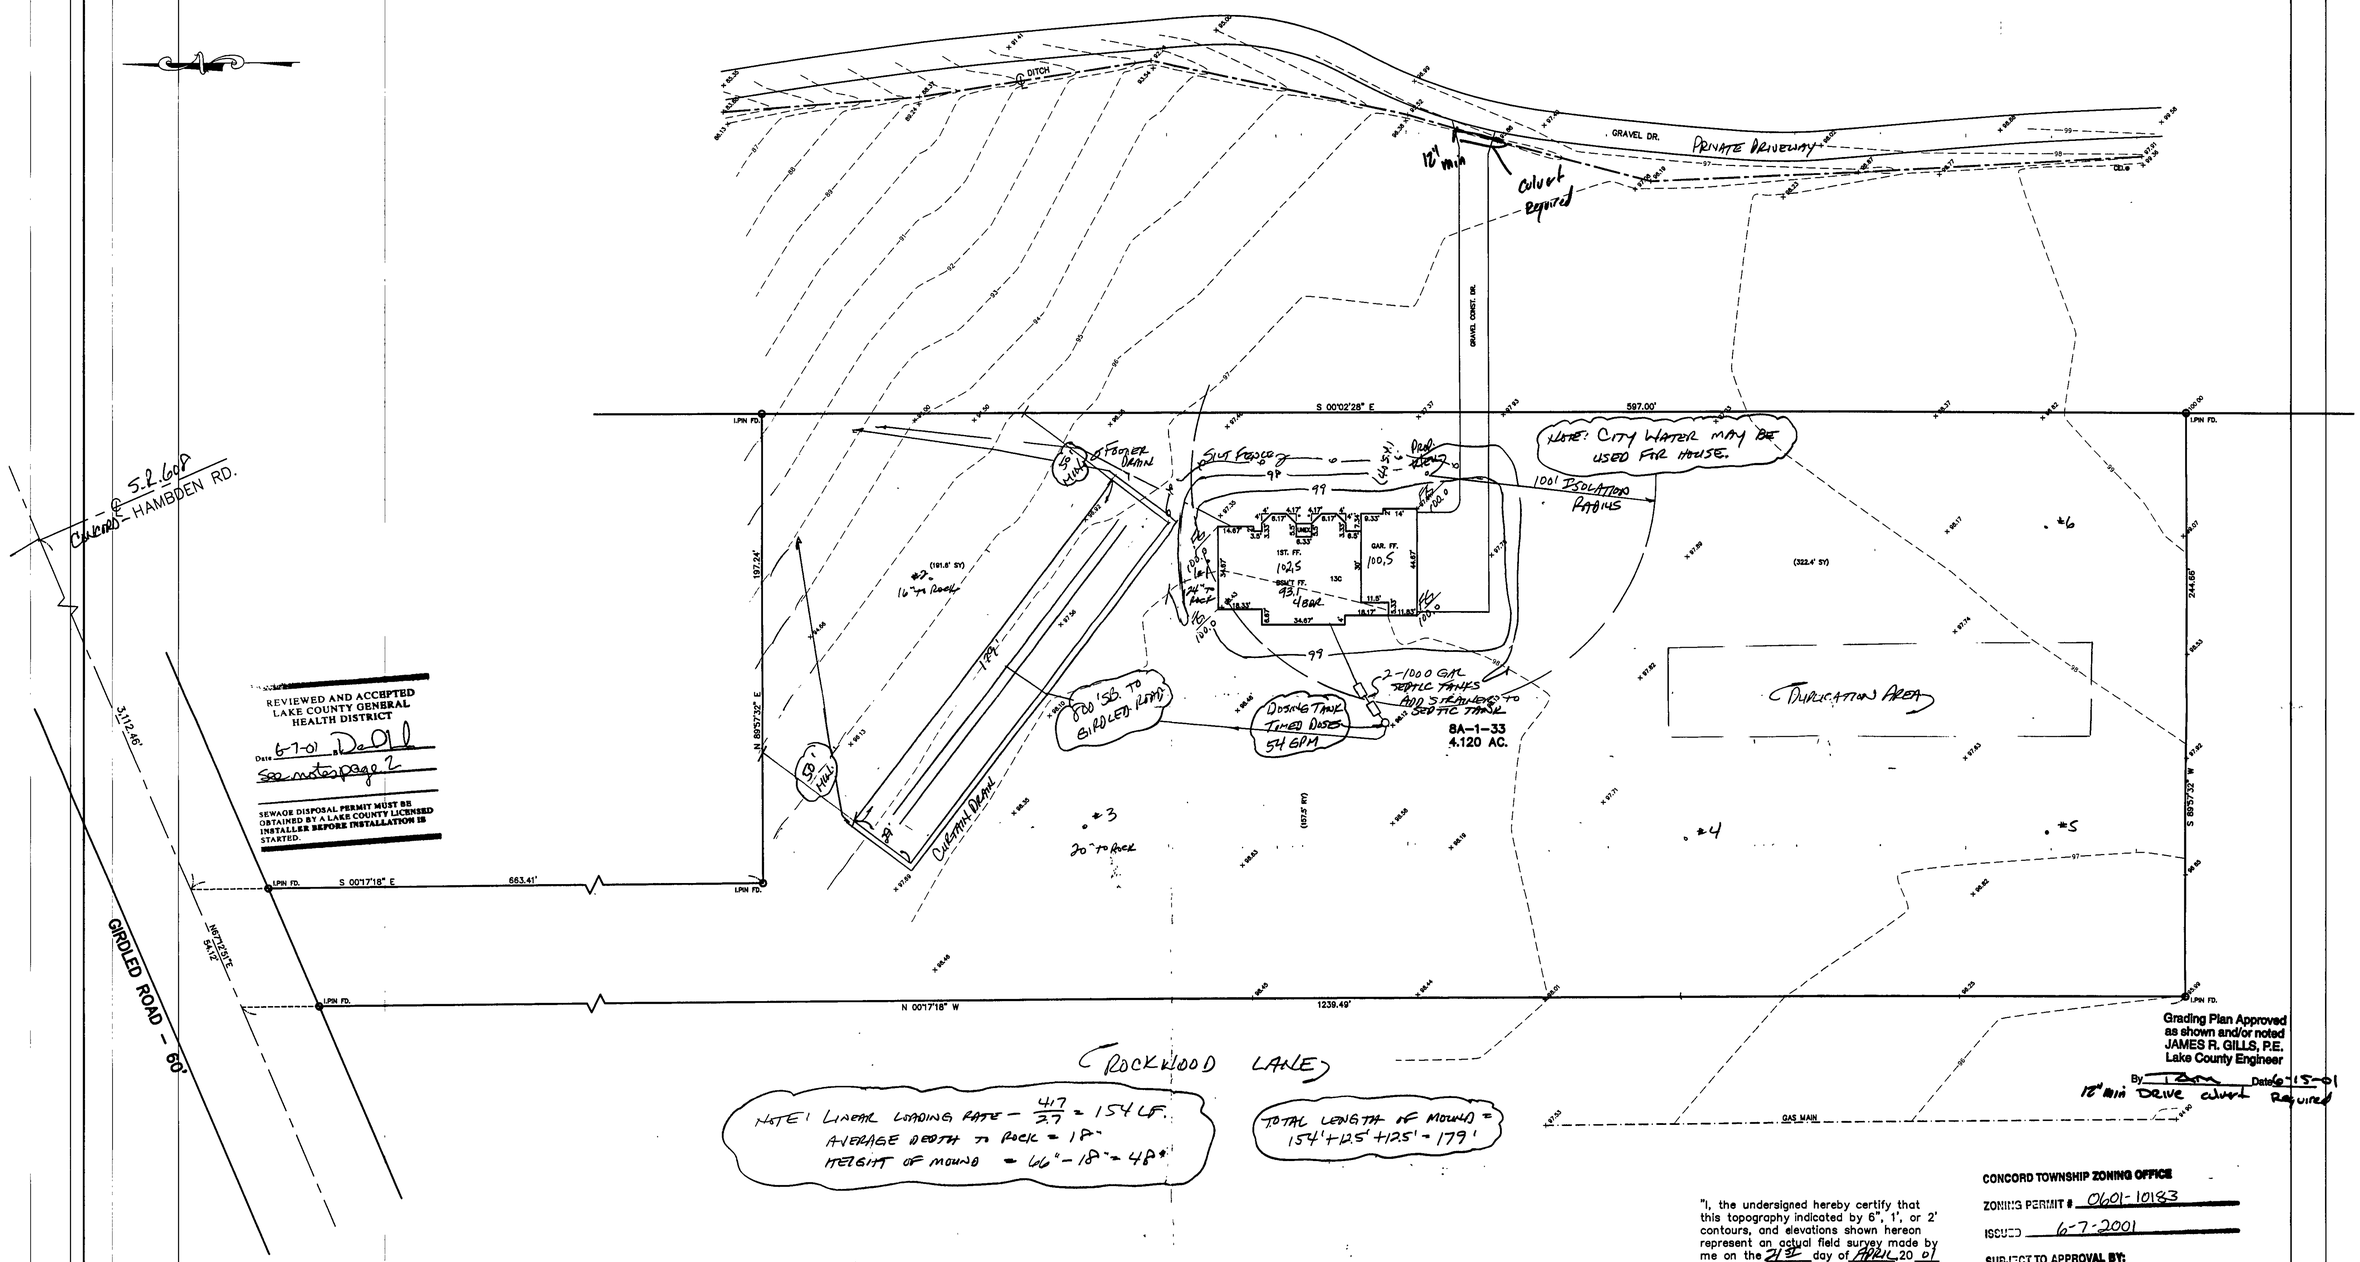

REVIEWED AND ACCEPTED
LAKE COUNTY GENERAL
HEALTH DISTRICT
Date 6-7-01 By Dal
See notes page 2

SEWAGE DISPOSAL PERMIT MUST BE OBTAINED BY A LAKE COUNTY LICENSED INSTALLER BEFORE INSTALLATION IS STARTED.

NOTE: LINEAR LOADING RATE – $\frac{41.7}{2.7}$ = 154 LF.
AVERAGE DEPTH TO ROCK = 18"
HEIGHT OF MOUND = 66" – 18" = 48"

TOTAL LENGTH OF MOUND = 154' + 12.5' + 12.5' = 179'

Grading Plan Approved as shown and/or noted
JAMES R. GILLS, P.E.
Lake County Engineer
By: [illegible] Date 6-15-01
12" min Drive culvert Required

"I, the undersigned hereby certify that this topography indicated by 6", 1', or 2' contours, and elevations shown hereon represent an actual field survey made by me on the 21st day of APRIL 20 01 and that the elevations were taken at appropriate intervals and that as of that date they existed as indicated hereon."

Harry Jones #6343
Name Reg. No.

CONCORD TOWNSHIP ZONING OFFICE
ZONING PERMIT # 0601-10183
ISSUED 6-7-2001

SUBJECT TO APPROVAL BY:
- ☐ Lake Co. Sanitary Engineer
- ☒ Lake Co. Eng. Dept.
- ☐ Lake Co. Planning Comm.
- ☒ Lake Co. Building Dept.
- ☒ Lake Co. Soil & Water Cons. Dist.

STATE OF OHIO — HARRY S. JONES, JR. — S-6343 — REGISTERED — PROFESSIONAL SURVEYOR

NOTE: TEMPORARY SEEDING REQUIRED IN DISTURBED AREAS.

REV NO.	DESCRIPTION	DATE	BY	CHK'D
1	REVISED LENGTH OF MOUND TO 154' LNG	5/30/01	HJ	HJ
2	REVISED MOUND	6/6/01	HJ	HJ

BABCOCK, JONES AND ASSOCIATES, INC
CIVIL ENGINEERS – SURVEYORS – LAND PLANNERS
PAINESVILLE OHIO 44077

DATE 4/23/01
DESIGN BY H.J.
DRAWN BY T.R.
APPROVED BY H.J.

SITE PLAN
FOR
JOHN PURGAR

CONCORD TOWNSHIP — LAKE COUNTY

SCALE: 1"=30'
JOB NO 01-048
SHEET 1 OF 2