SITE PLAN

CONCORD (TOWNSHIP) LAKE COUNTY, OHIO

for: L. R. FREY (CLIENT / OWNER)

8479 (ADDRESS) GRENWAY DRIVE (STREET) MENTOR (CITY) 44060 (ZIP)

GRANDRIDGE POINTE SUBD. (SUBDIVISION NAME)	LOT
5 - 13 (VOL. - PG.)	TRACT
	VOLUME
	PAGE
19 (SUBLOT NO.)	GRANDRIDGE POINTE DR. (STREET)
	PERM. PARCEL NO.
	STREET

LEGEND

SANITARY MANHOLE
STORM MANHOLE
INLET OR CATCH BASIN
HYDRANT
EXISTING CONTOURS
PROPOSED CONTOURS
EXIST. ELEV. 100.0 / 100.0 PROP. ELEV.
WATER VALVE (GAS)
WATER METER (GAS)
AS BUILT ELEVATION 100.0
INDICATES DIRECTION OF SURFACE DRAINAGE

REMARKS

ALL BOUNDARY DATA SHOWN WAS OBTAINED FROM (DEEDS, RECORDED SUBDIVISION PLAT OR OTHER PUBLIC RECORDS)

LOCATIONS AS SHOWN OF ADJACENT WELLS AND SEPTIC TANKS OBTAINED FROM LAKE COUNTY HEALTH DEPARTMENT

DESIGN CERTIFICATION

THIS PLAT WAS PREPARED BY ME, AND IS CORRECT TO THE BEST OF MY KNOWLEDGE AND BELIEF.

Edward Gillespie 4914
NAME SURVEYOR REGISTRATION NO.

Grading Plan Approved as shown and/or noted
THOMAS P. GILLES, P.E.
Lake County Engineer
By _____ Date 1-29-86

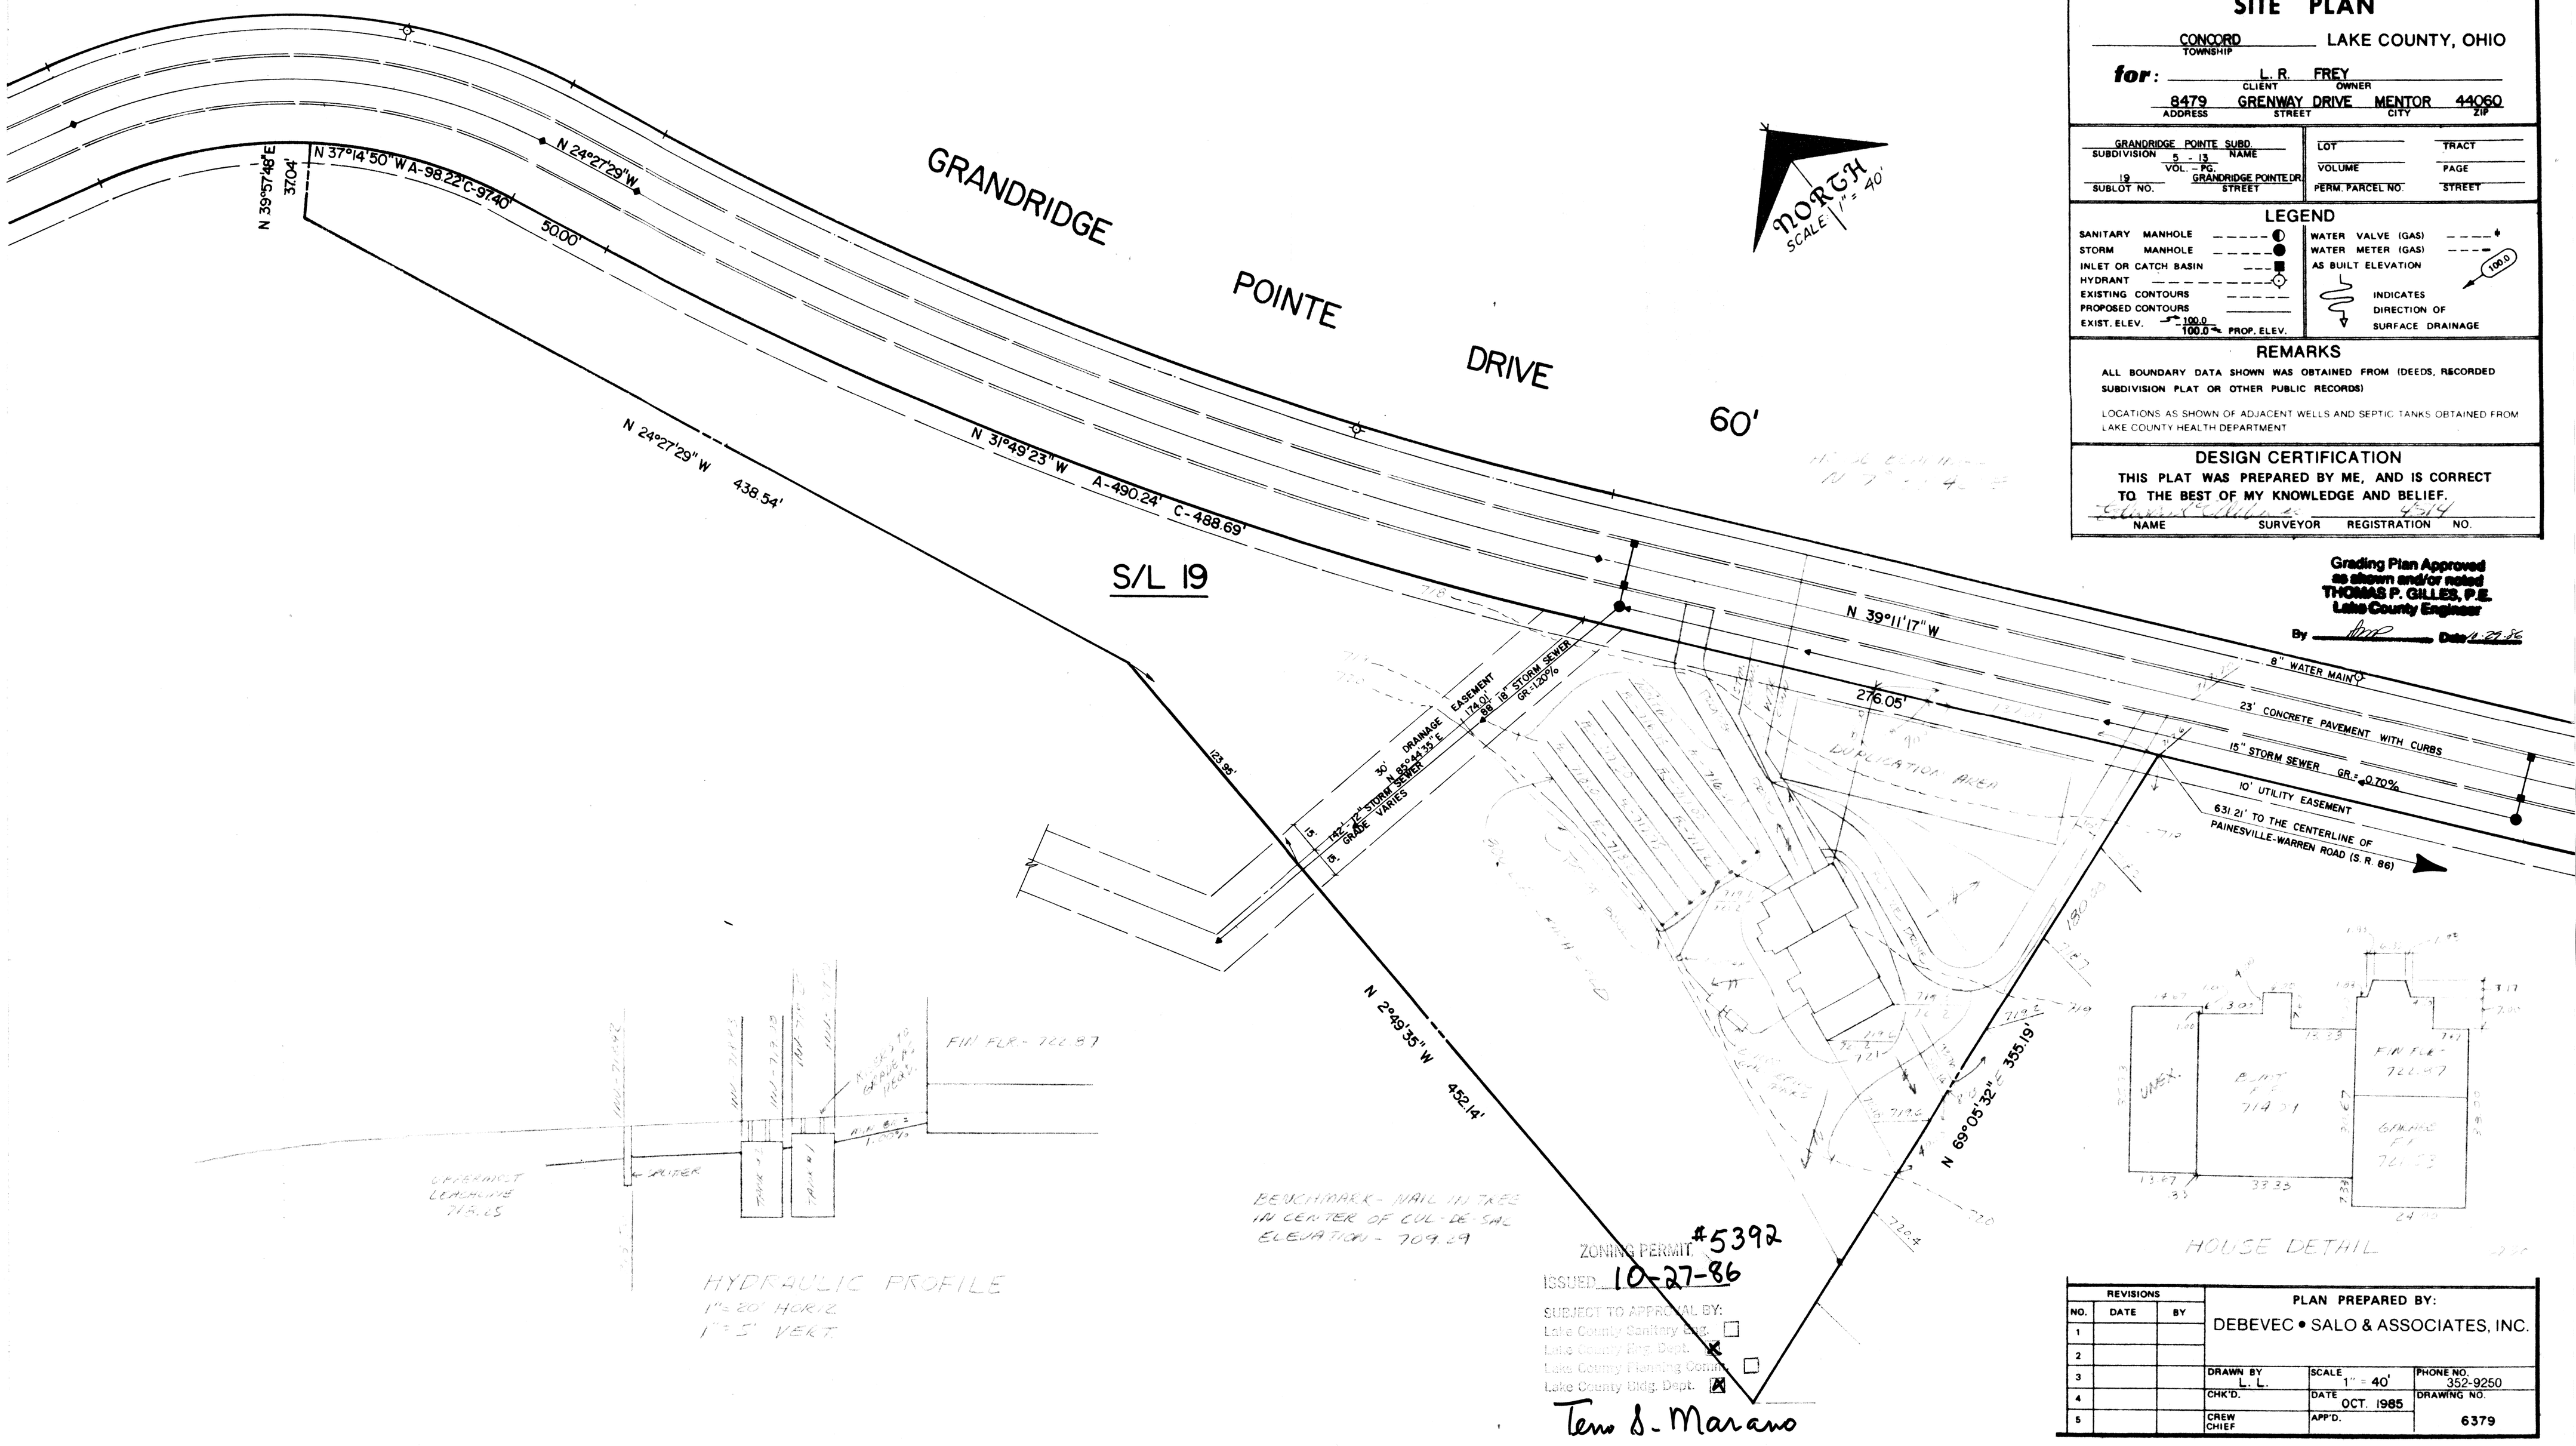

ZONING PERMIT #5392
ISSUED 10-27-86
SUBJECT TO APPROVAL BY:
Lake County Sanitary Eng. ☐
Lake County Eng. Dept. ☐
Lake County Planning Comm. ☐
Lake County Bldg. Dept. ☒

Terry S. Marano

REVISIONS			PLAN PREPARED BY: DEBEVEC • SALO & ASSOCIATES, INC.		
NO.	DATE	BY			
1					
2					
3			DRAWN BY L. L.	SCALE 1" = 40'	PHONE NO. 352-9250
4			CHK'D.	DATE OCT. 1985	DRAWING NO. 6379
5			CREW CHIEF	APP'D.	