


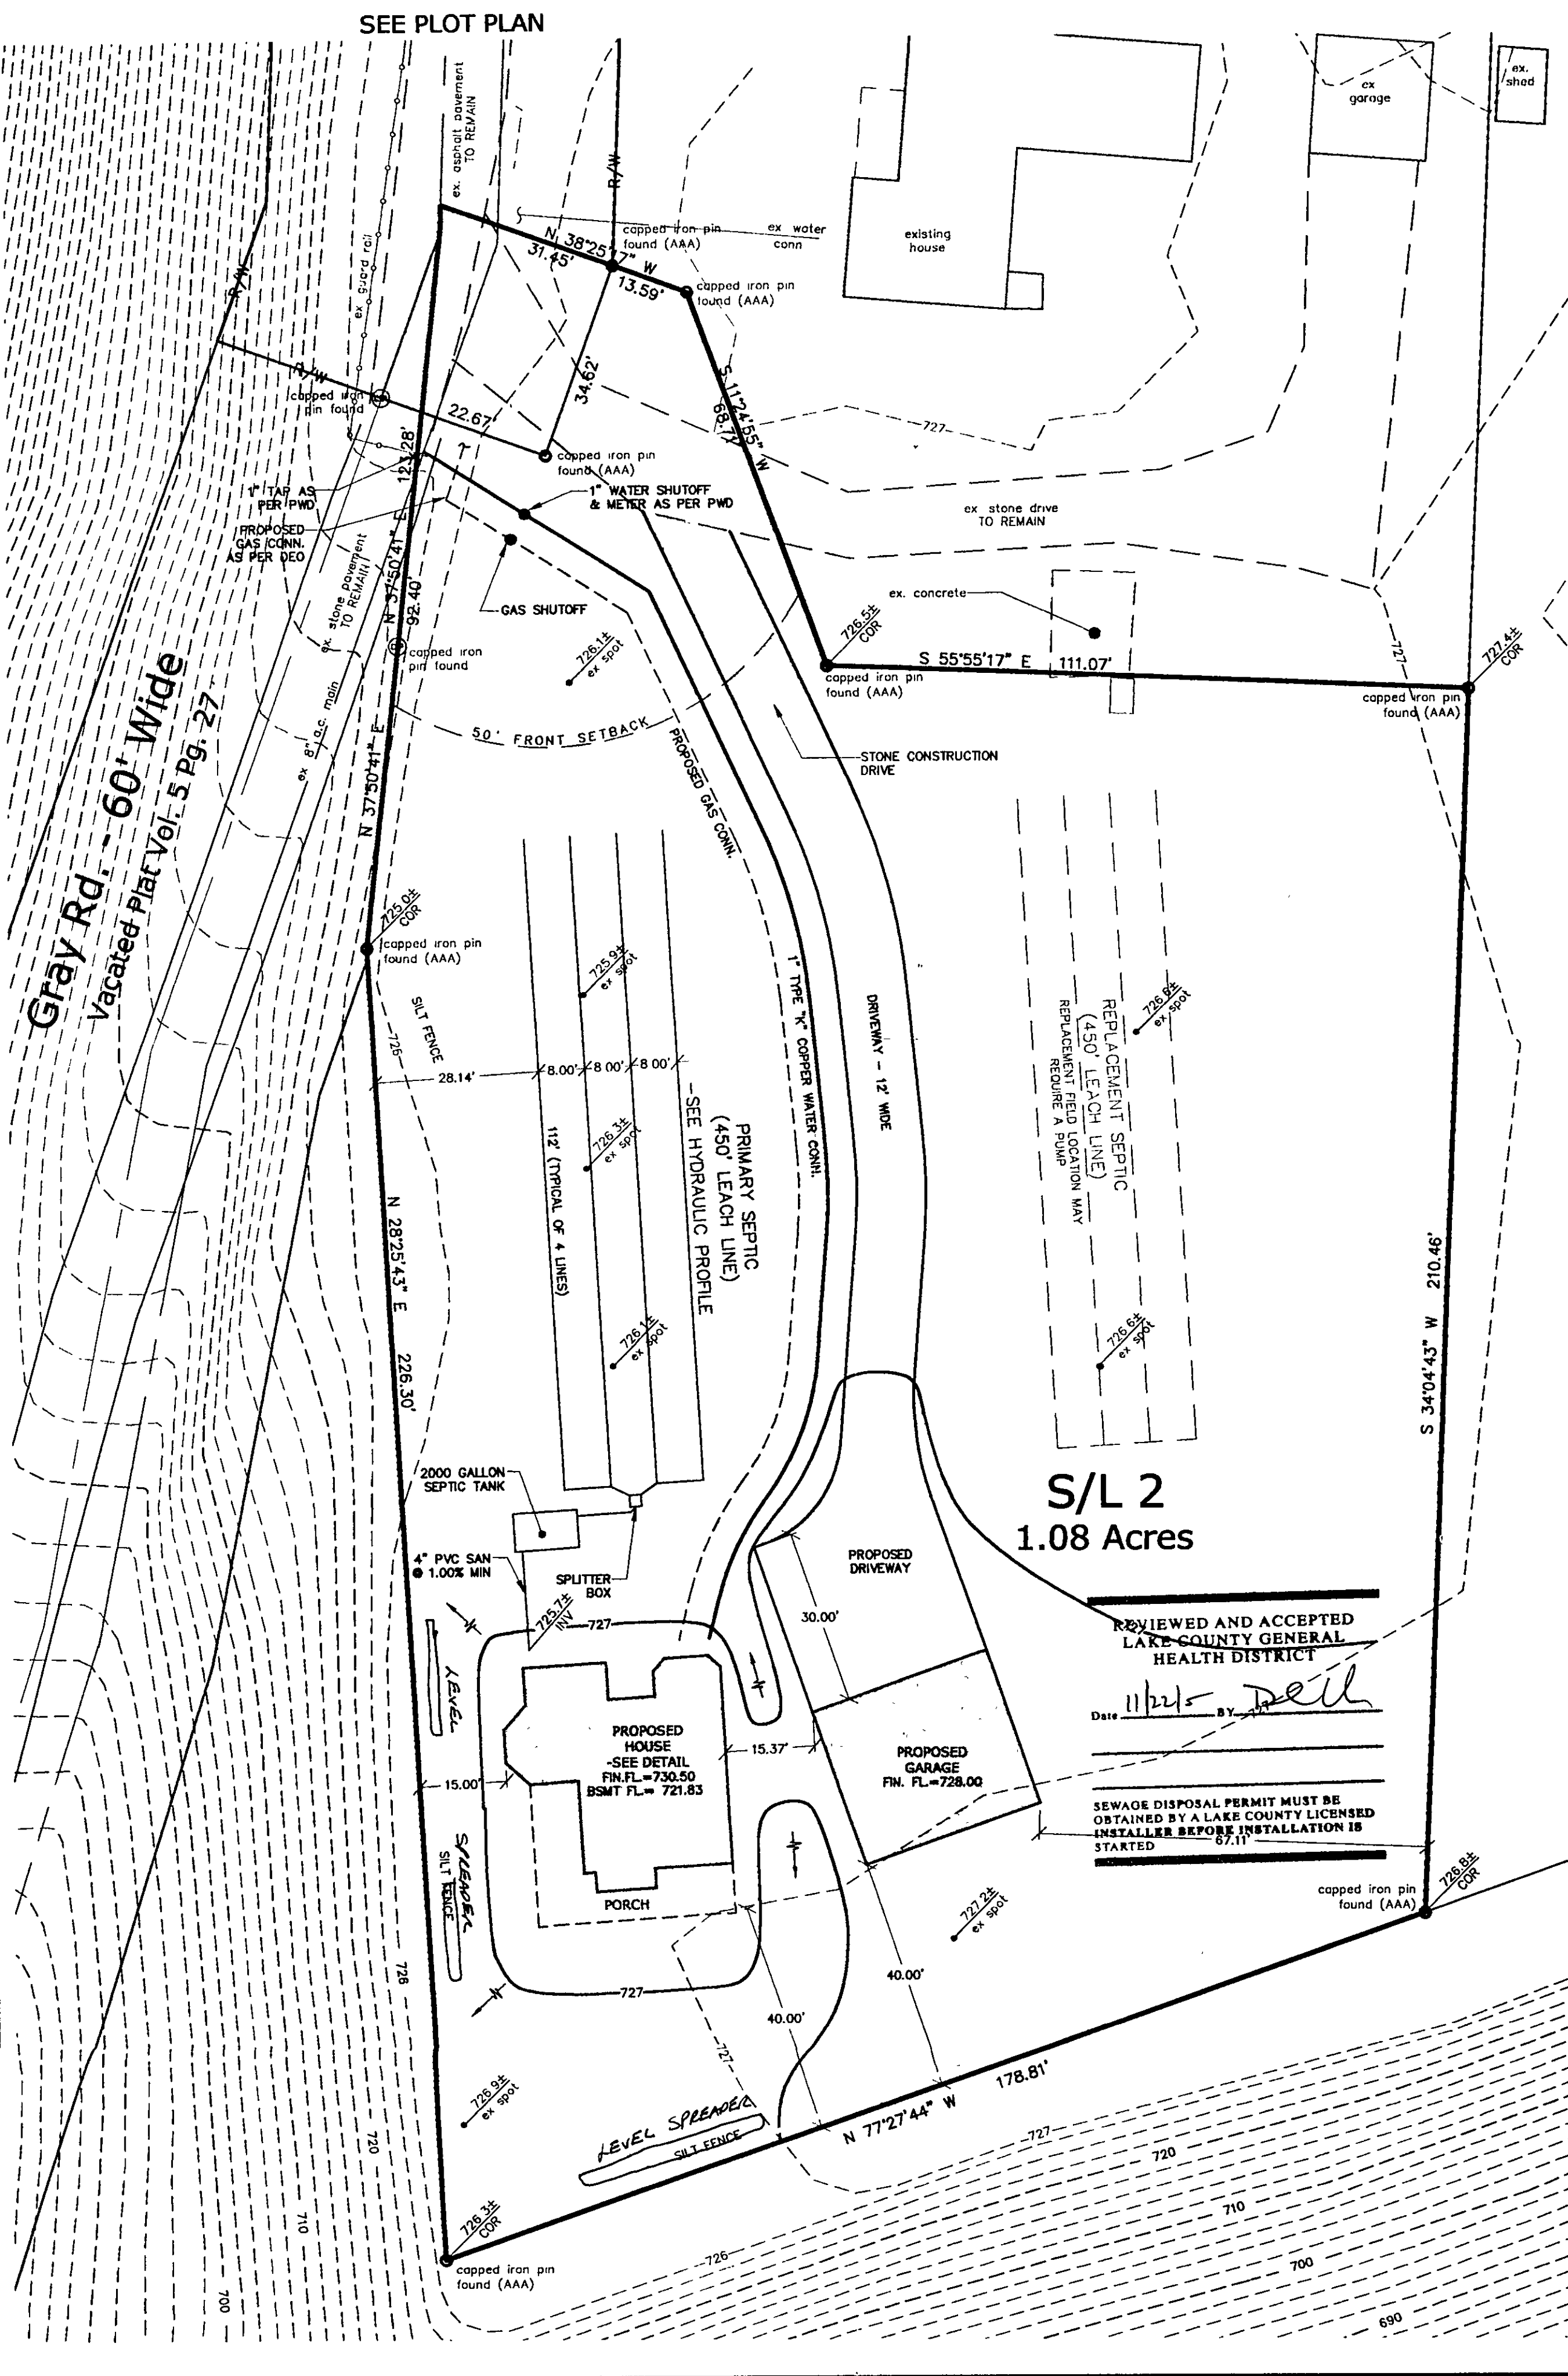


PROPOSED 3 BEDROOM HOUSE
 FIN. FL. = 730.50
 BASEMENT FIN. FL. = 721.83


- Internal dimensions: 14.33', 8.33', 8.00', 1.33', 2.83', 7.67', 2.83', 34.00', 13.33', 10.33', 2.00', 18.00', 24.50', 2.67', 6.67', 8.33'
- PORCH: 34.00'

VICINITY MAP

NTS

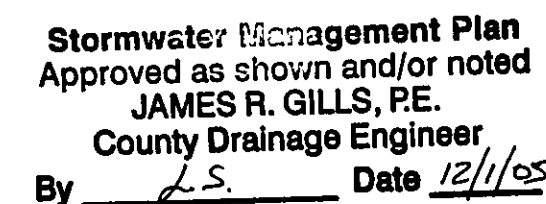



[illegible]

S/L 2 Gray Road

Concord Township ~ Lake County ~ Ohio

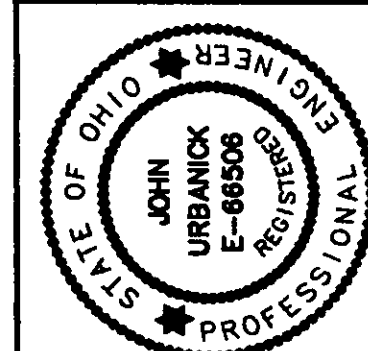

Drawn By: JAS
Checked By:
Approved By:
Date: 11/08/05

Greenland Consulting, Inc.

Scale:	Horiz.	1" = 20'
	Vert.	1" = N/A
Sheet No.	Of	
1	2	
Filename: 04-104\S\L 2		