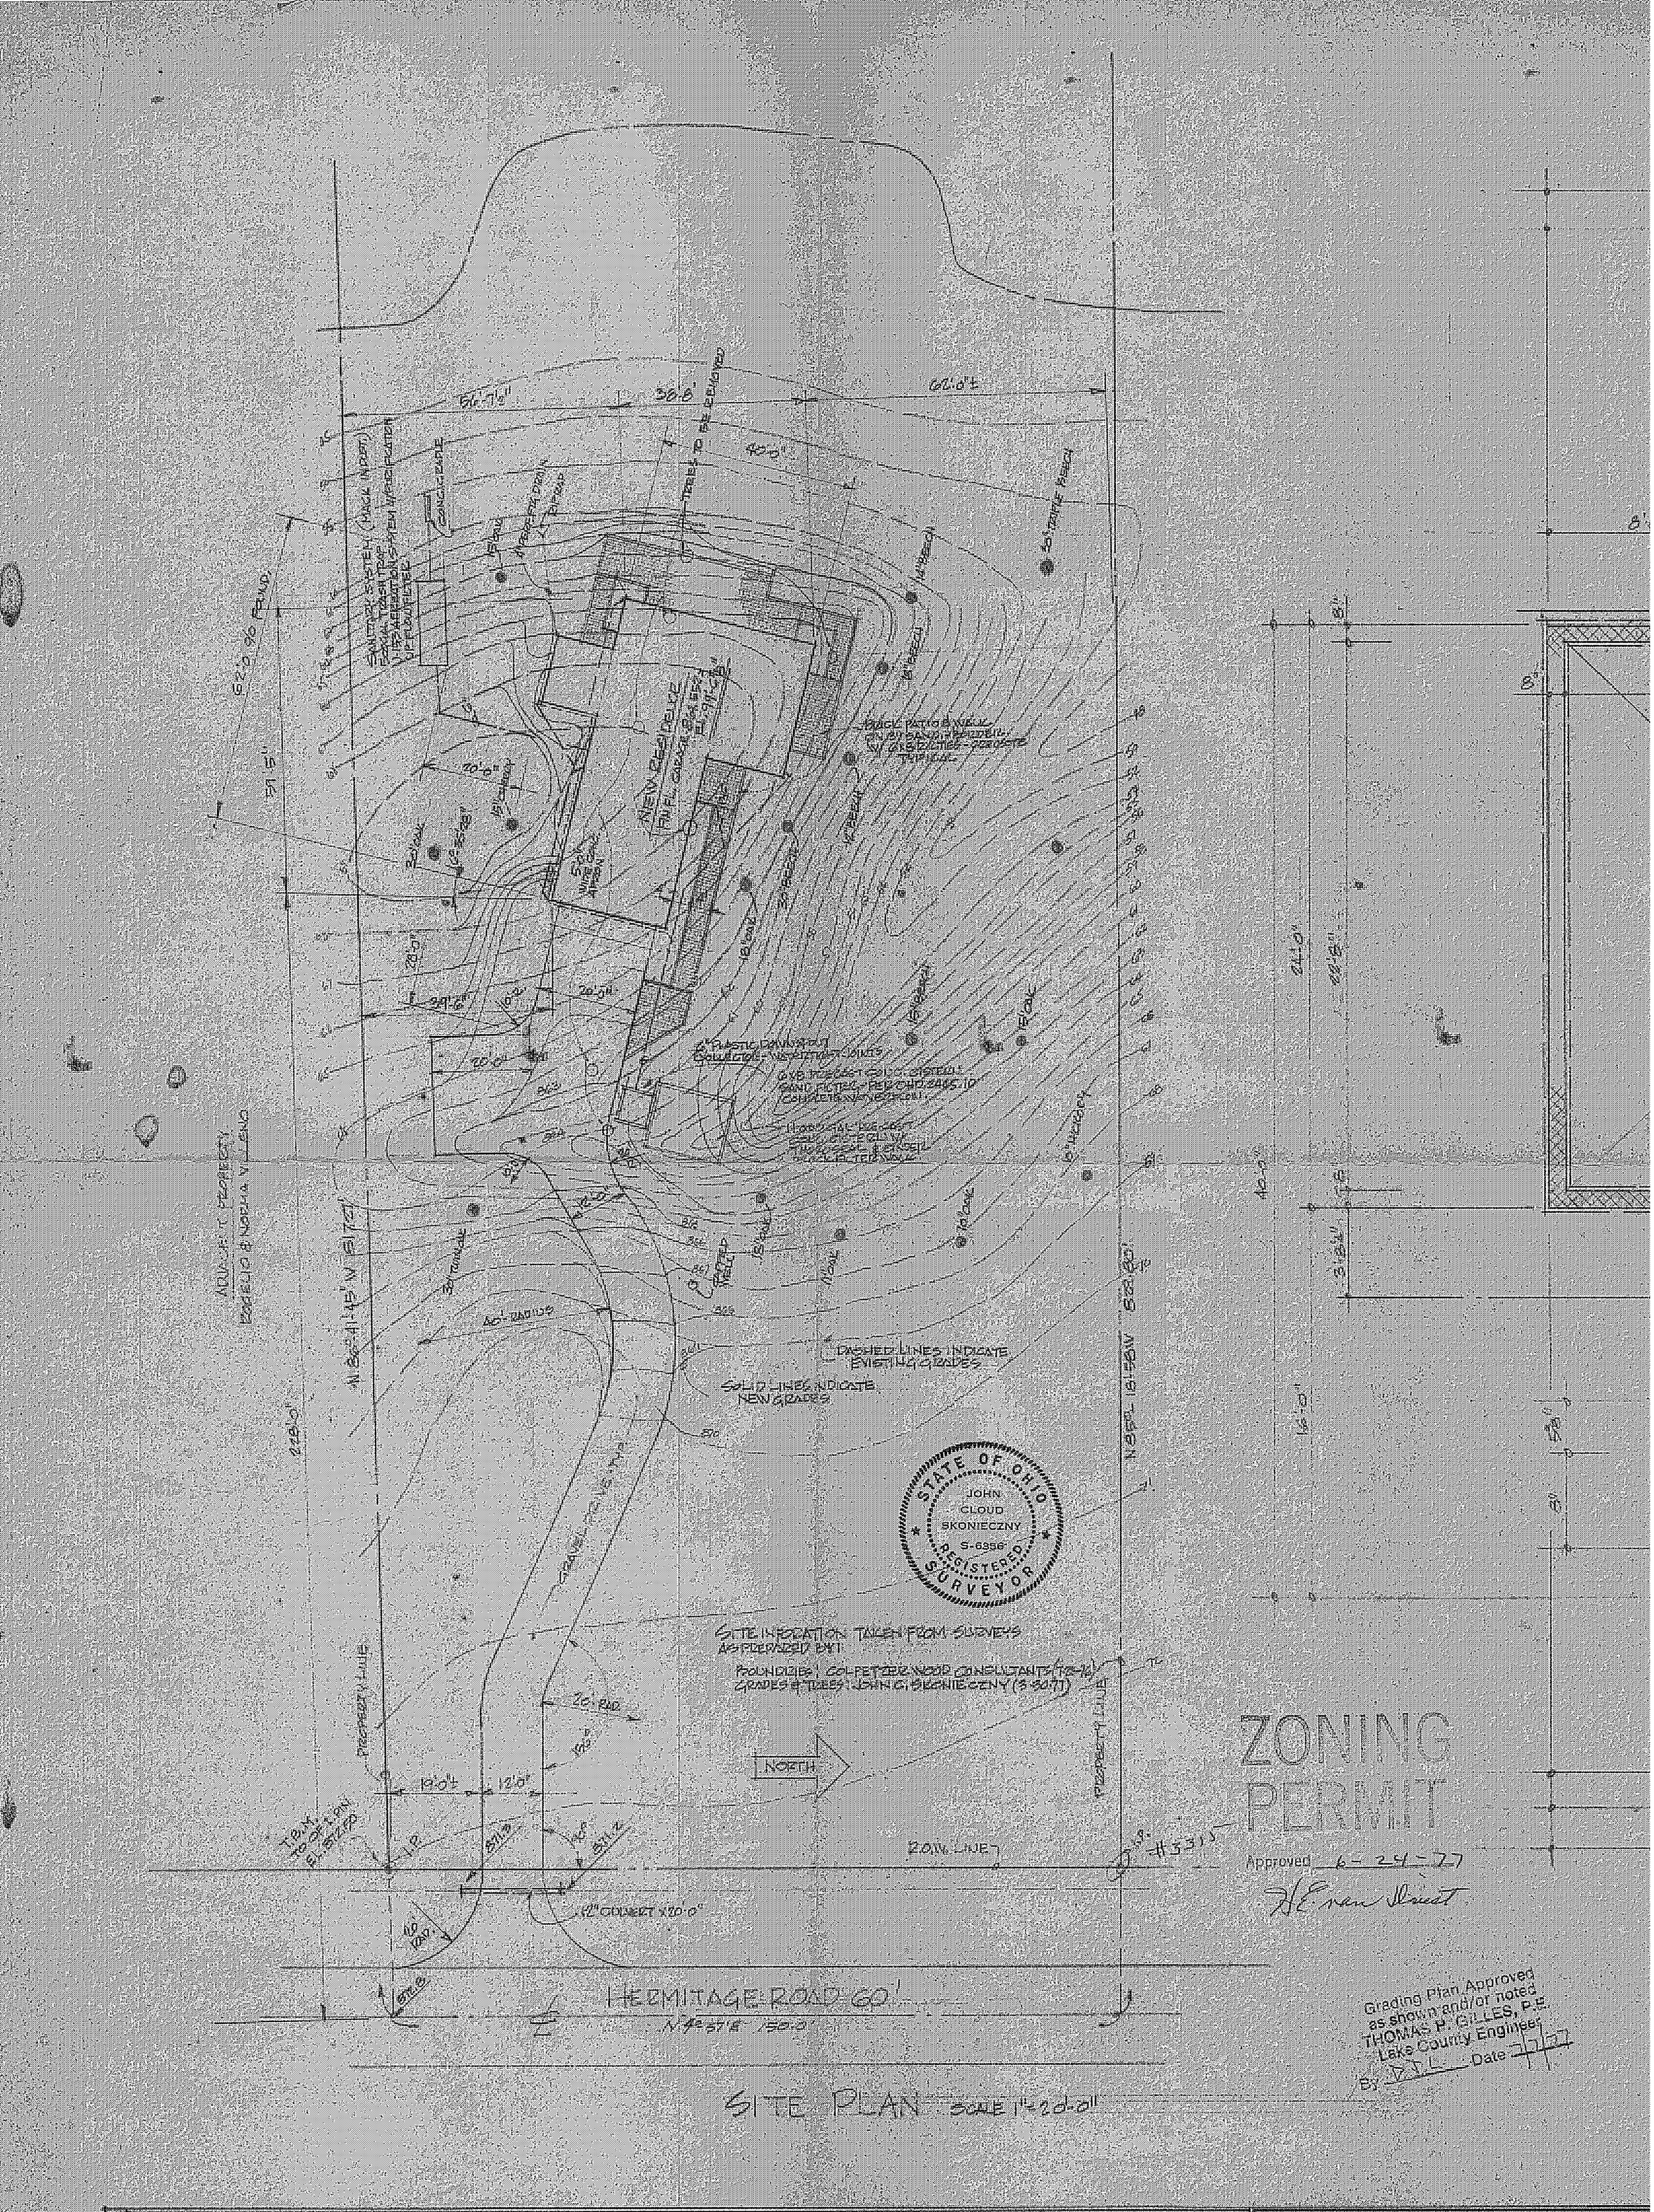
SITE PLAN SCALE 1"=20'-0"
HERMITAGE ROAD 60'
NORTH
DASHED LINES INDICATE EXISTING GRADES
SOLID LINES INDICATE NEW GRADES
SITE INFORMATION TAKEN FROM SURVEYS
ZONING PERMIT
Approved 6-24-77
Grading Plan Approved as shown and/or noted
THOMAS P. GILLES, P.E.
Lake County Engineer
Date
STATE OF OHIO
JOHN CLOUD SKONIECZNY
S-6356
REGISTERED SURVEYOR
richard j. weber AR
8058 HERMITAGE RD. CONCORD TOWNSHIP OHIO 44077