


FOR
DALE NAISMITH
SUBJECT NO. 12 OF HANCOCK II SUBD
VOL. 4 PG. 14,
CONCORD TOWNSHIP, LAKE COUNTY, OHIO

SCALES	
HOR.	1" = 40'
VERT.	
CONTRACT NO.	
86-15C	
SHEET NO.	OF
1	1

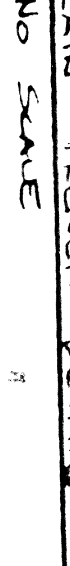

Grading Plan Approved
as shown and/or noted
by J. GILES, P.E.
_____/ engineer
Date 4-1-86

SCALE 1" = 40'

$\odot - K = 15.00'$
 $\Delta = 80^{\circ} 26' 05''$
 $A = 105.29'$
 $C = 96.85'$
 $CB = N. 80^{\circ} 39' 12'' E.$