


SCALE: 1"=20'

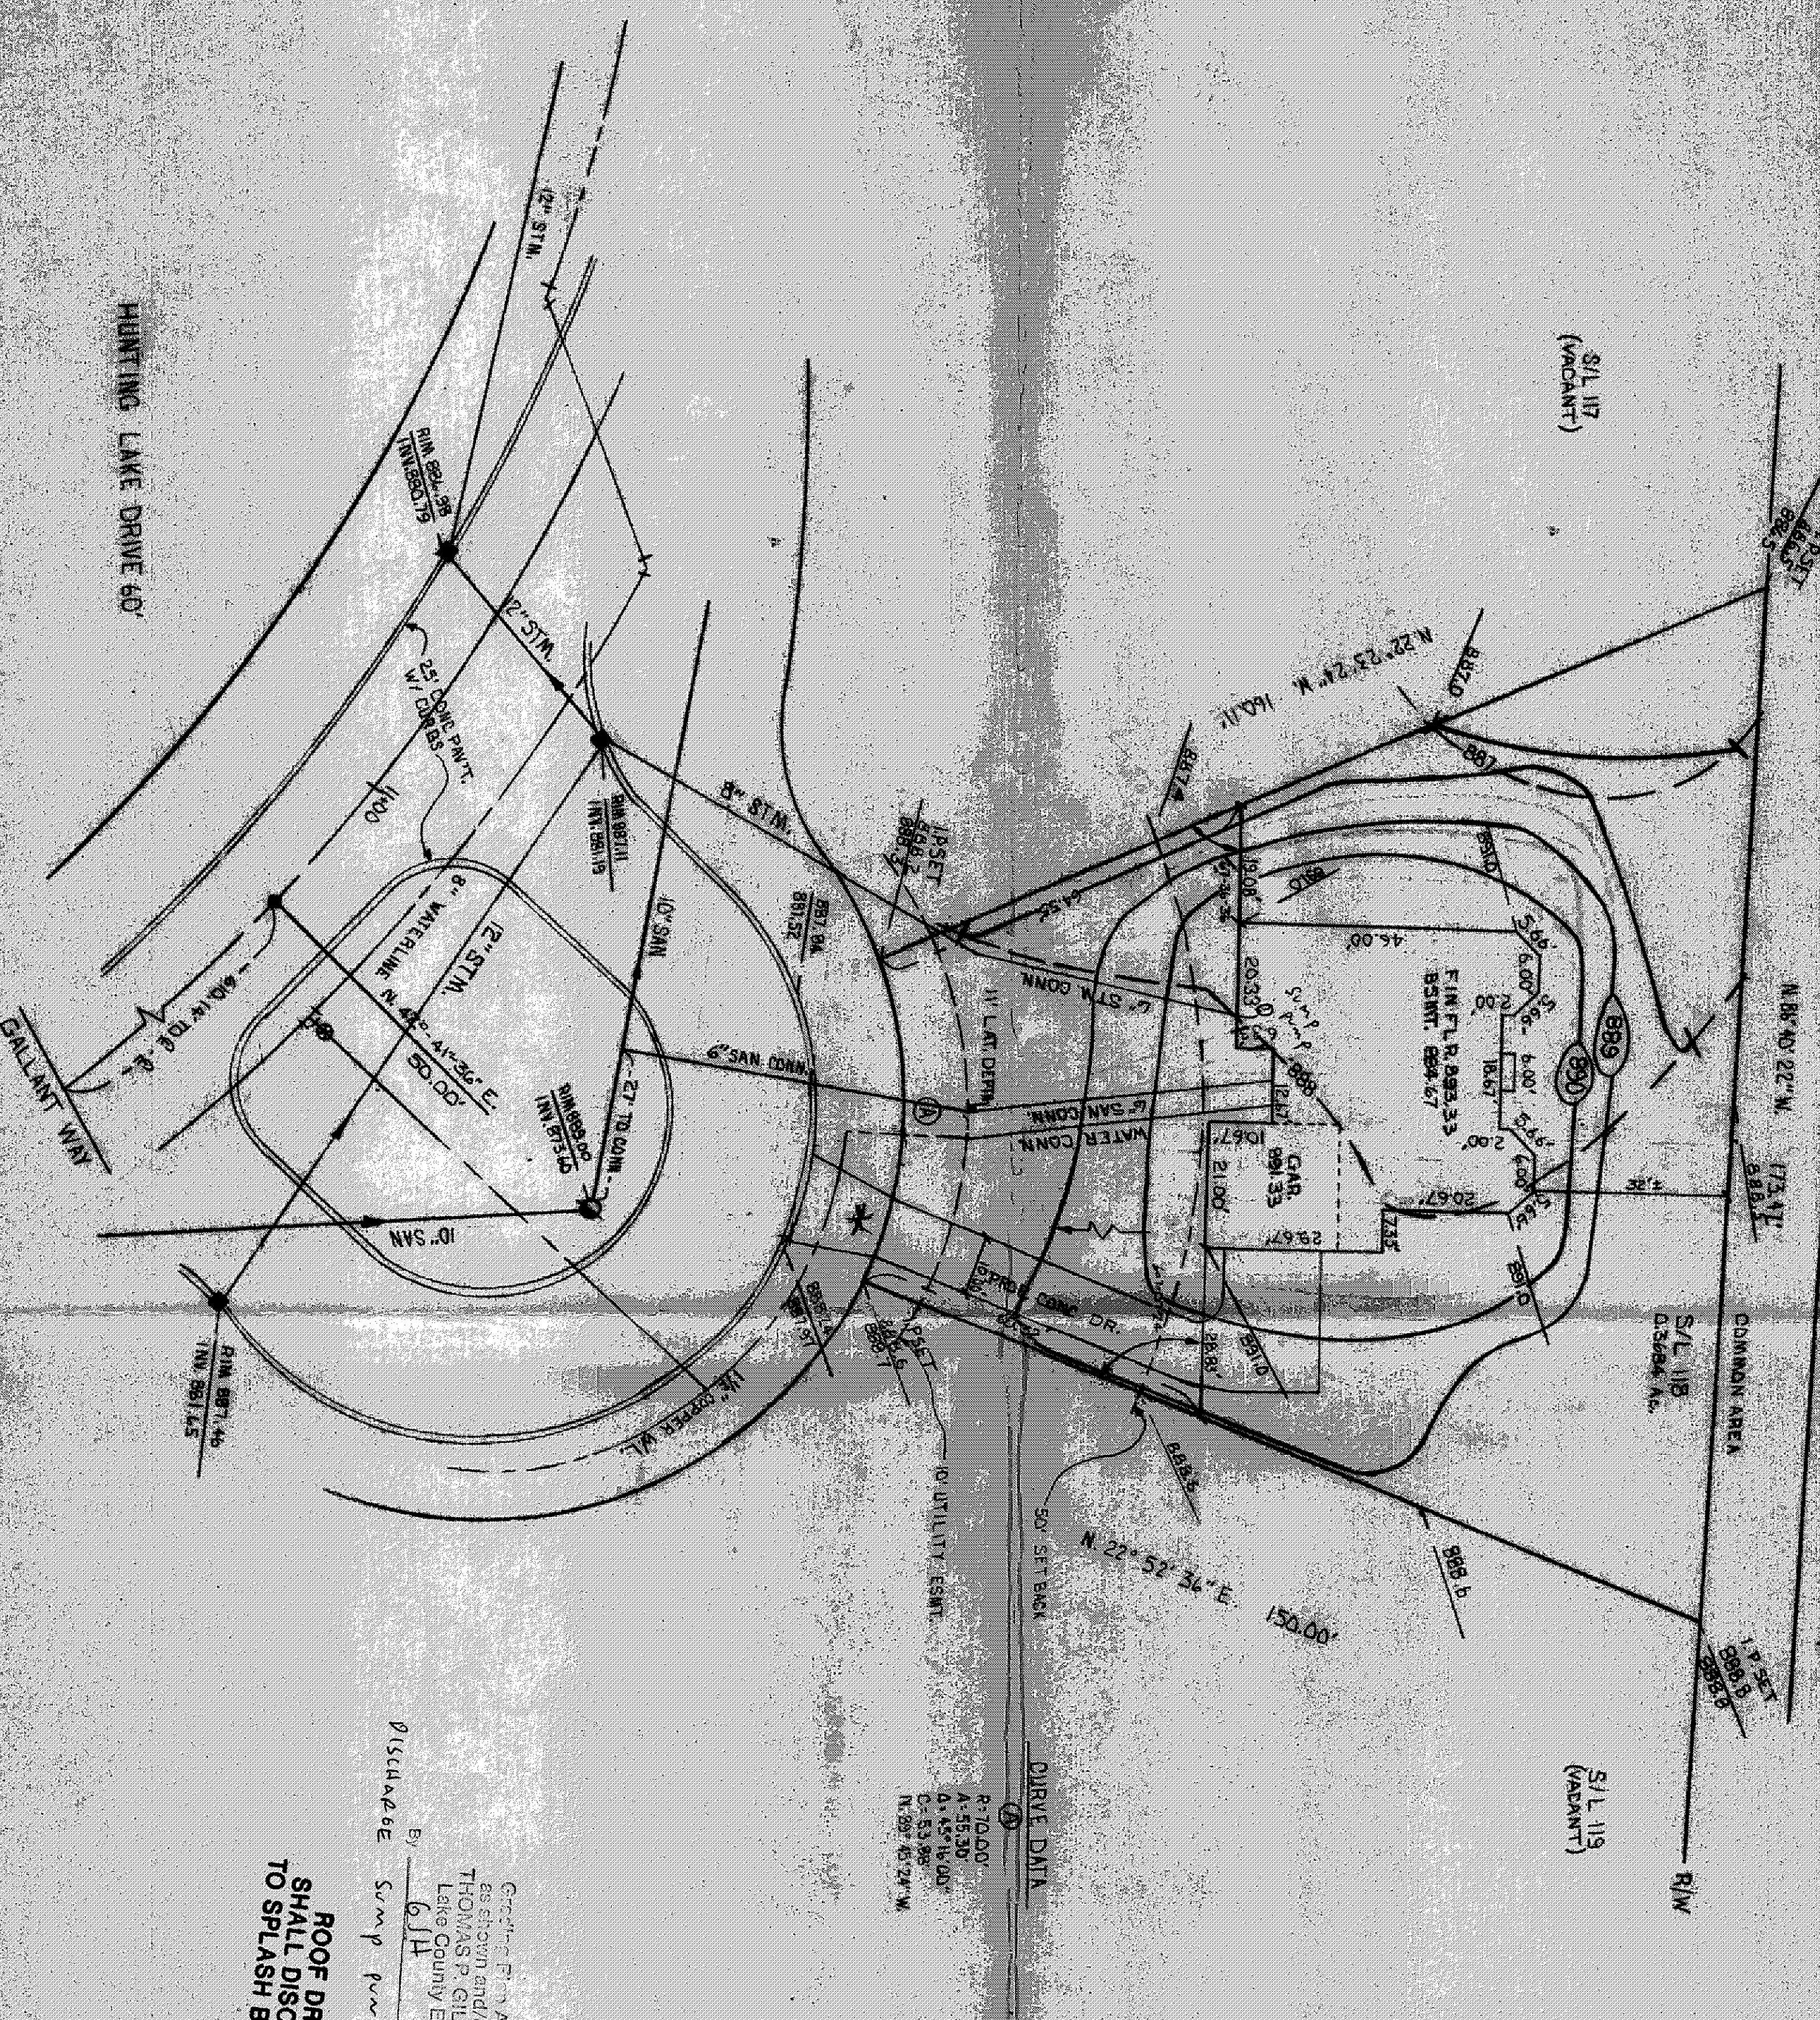

for: M. M. BOGART HOMES

2466 RIVER ROAD WILLOUGHBY HILLS

Address: STREET CITY



SUBLOT No. SUBDIVISION NAME VOL PAGE

LOT TRACT CONCORD OHIO


GUTOSKEY & ASSOCIATES, INC.

Civil Engineers and Surveyors
5971 Rutledge Ave.
Cleveland, Ohio 44131 Tel (216) 281-2000
Fax (216) 281-3111

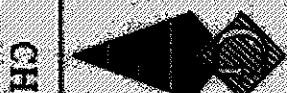

CHECK LIST

LOT DIMENSIONS & BEARINGS
TO NEAREST STREET
SUBLOT No. (PARCEL No.)
SURROUNDING OWNERS
BUILDING FOOTPRINTS
REAR YARD, REAR YARD
DRIVE & APRON TYPE, WIDTH, THICKNESS
SIDEWALK TYPE, WIDTH, THICKNESS
WATER MAIN SIZE, LOCATION
SAN SEWER SIZE, LOCATION
SAN MAIN SIZE, LOCATION
SAN DOWN SIZE, LOCATION
STORM SEWER SIZE, LOCATION
PLAY TYPE, LOCATION
GAS LINE LOCATION
WELL LOCATION & ISOLATION RADIUS

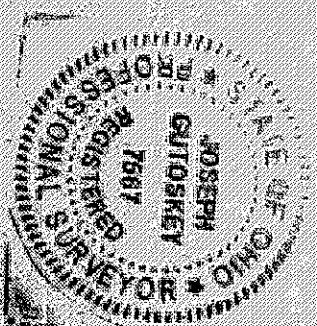

STATE SEAL

DESIGN CERTIFICATION

THIS PLAN WAS PREPARED BY ME. I AM A LICENSED PROFESSIONAL SURVEYOR AND I HEREBY CERTIFY THAT THE CIRCLED INFORMATION IS EXISTING AS OBTAINED ON THE SITE.


"AS-BUILT" CERTIFICATION

I HEREBY CERTIFY THAT THE CIRCLED INFORMATION IS EXISTING AS OBTAINED ON THE SITE. CORRECT TO THE BEST OF MY KNOWLEDGE AND BELIEF.

LEGEND


BENCHMARK: SAN. MH RIM ELEV. 889.00

* = 6" CONC. APRON

Checked by: Thomas R. Giletti, P.E.
Lake County Engineer


ZONING PERMIT
ISSUED 10-14-94 #1094-7996

ROOF DRAINS
SHALL DISCHARGE
TO SPLASH BLOCKS.

SUBJECT TO APPROVAL BY:
☐ Lake County Sanitary Eng.
☒ Lake County Eng. Dept.
☐ Lake County Planning Comm.
☒ Lake County Bldg. Dept.



CALL TOLL FREE 800-362-2764

CONTRACT NO.
94-519-119