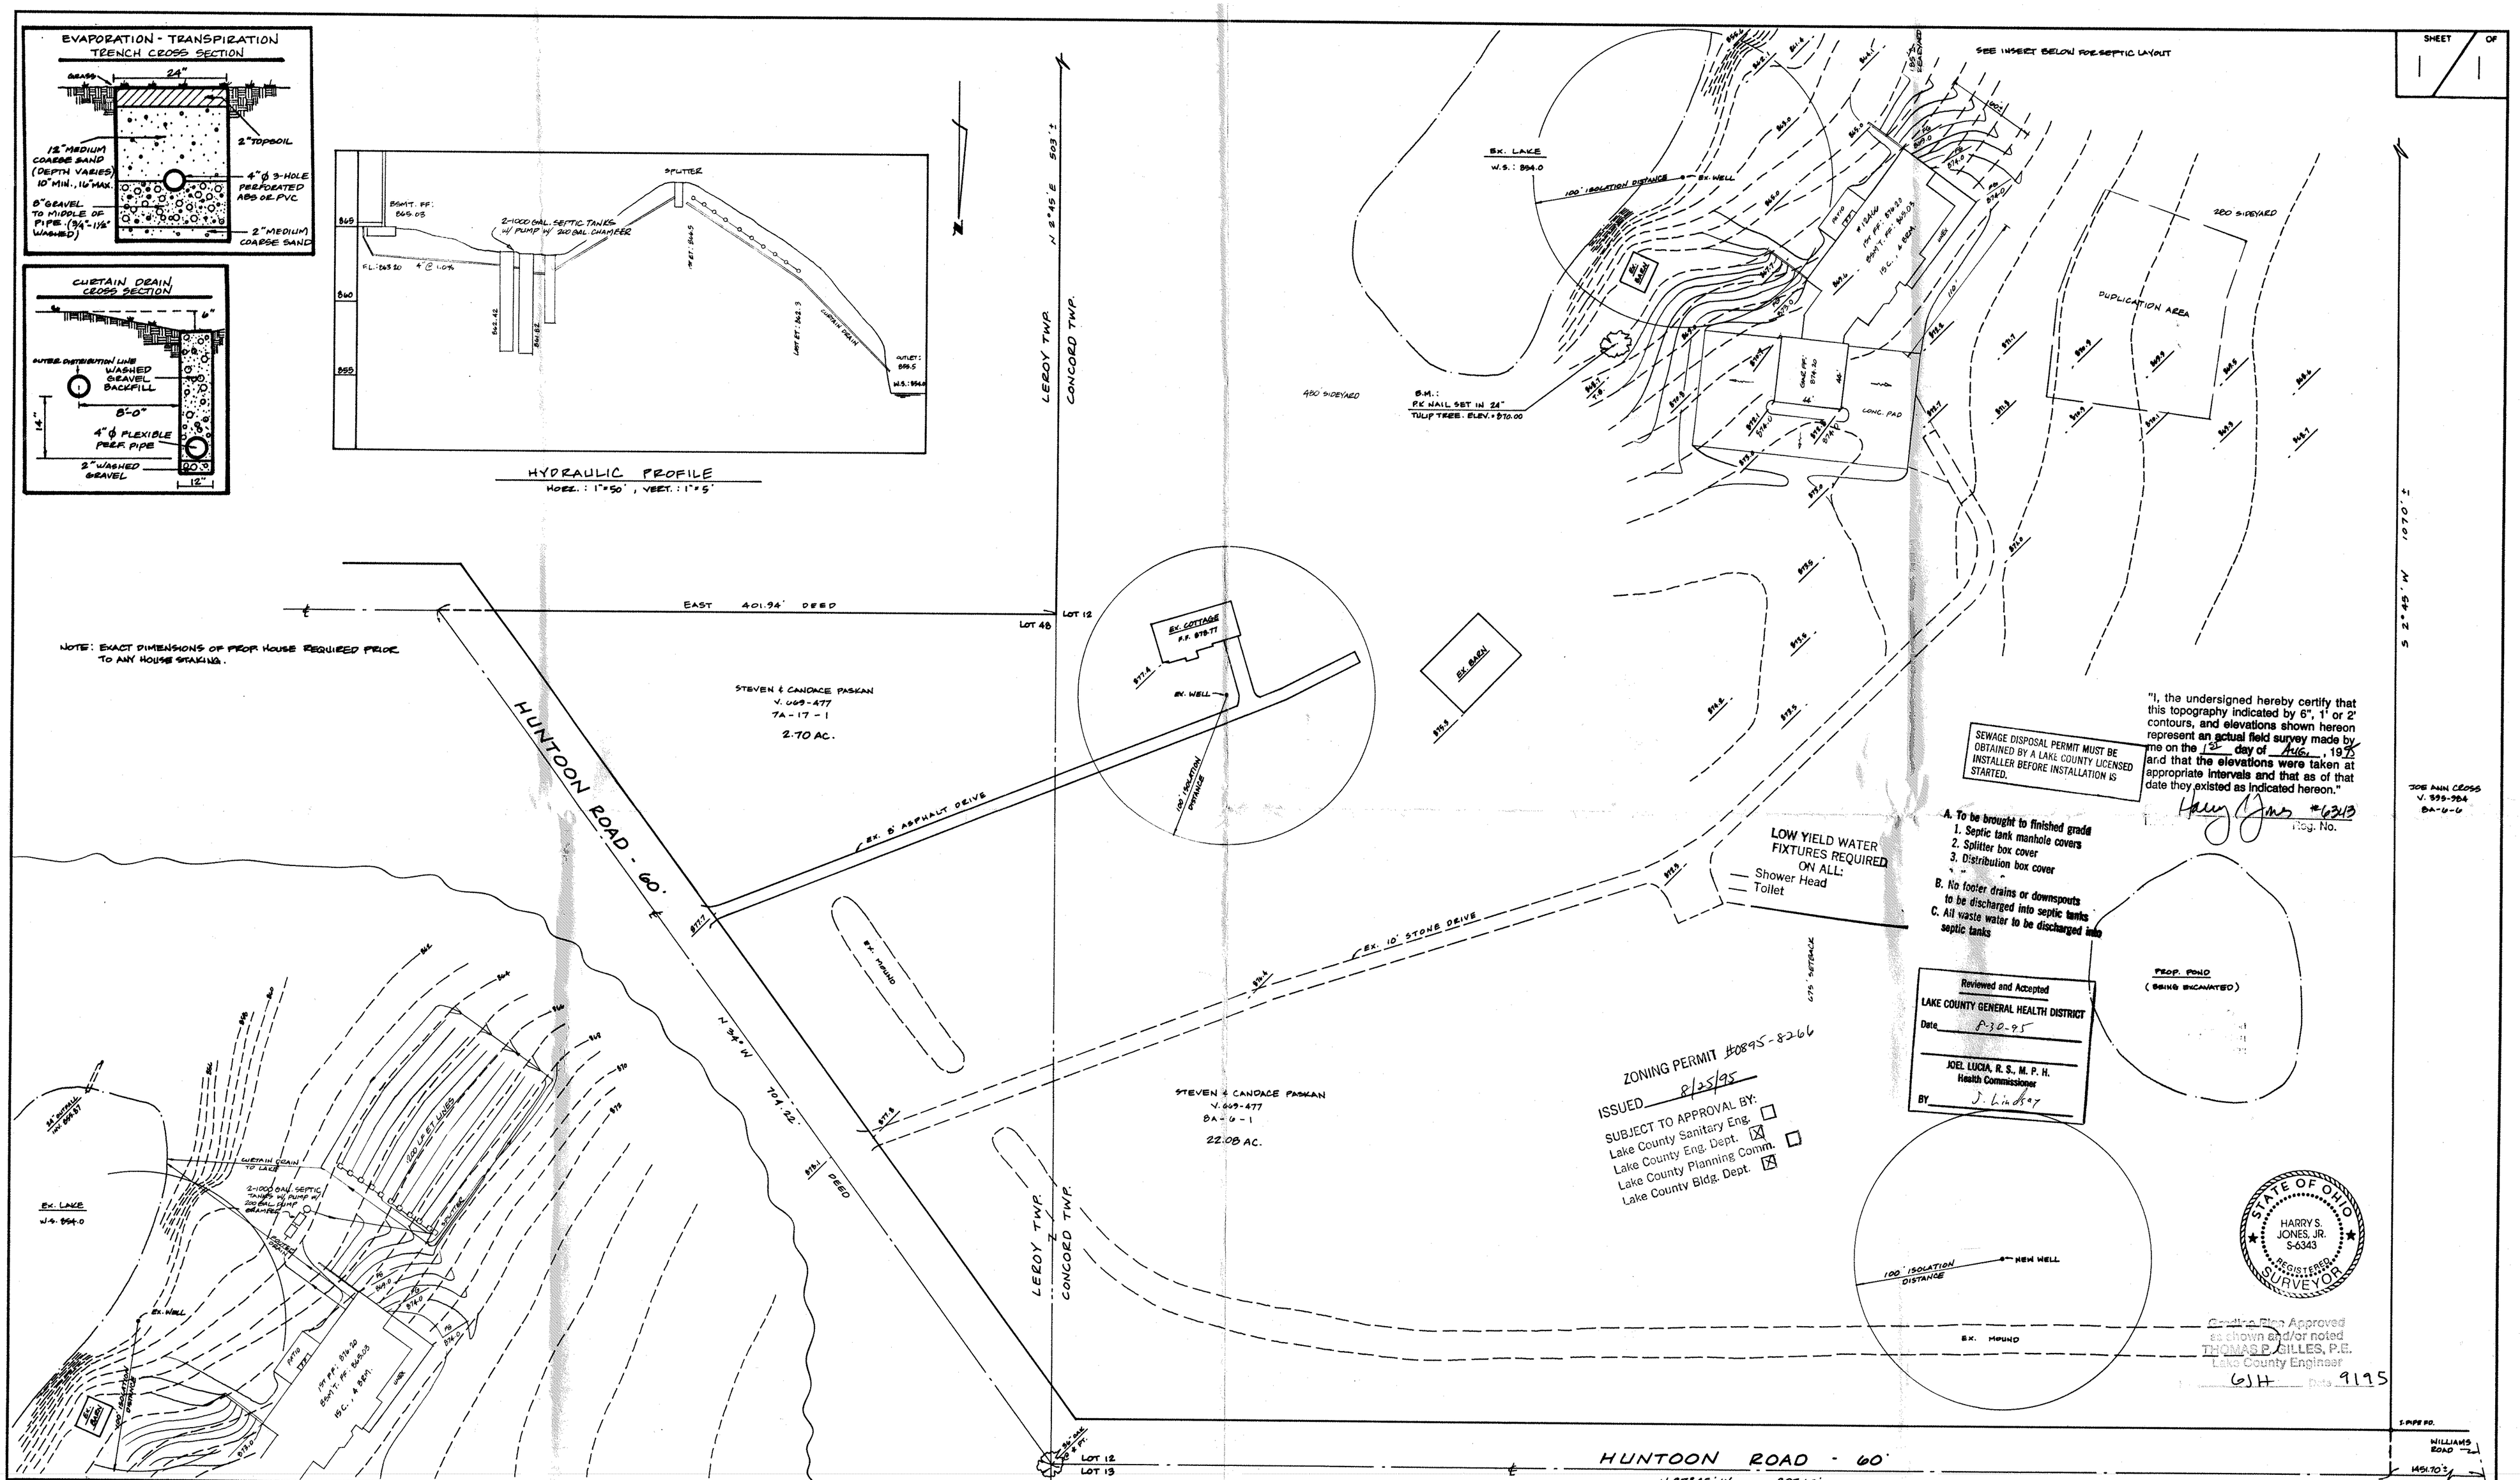

REV NO.	DESCRIPTION	DATE	BY	CH'K'D

SITE PLAN
FOR
B.C.I. CUSTOM HOMES

BABCOCK, JONES AND ASSOCIATES, INC
CIVIL ENGINEERS - SURVEYORS - LAND PLANNERS
PAINESVILLE OHIO 44077

DATE: AUGUST 1995
DESIGN BY: HJ
DRAWN BY: D.L.
APPROVED BY: HJ

BEING A PART OF LOT NO. 12. TRACT 1 CONCORD TOWNSHIP AND PART OF LOT 48 LEROY TOWNSHIP.
Vol. 669 - Pg. 477, P.P. #'s 7A-17-1 & 8A-6-1
TOWNSHIP OF CONCORD & TOWNSHIP OF LEROY
COUNTY OF LAKE, STATE OF OHIO.

SCALE: 1" = 50'
JOB NO. 95-204
SHEET 1 OF 1