


SITE PLAN

FOR

R.E. GIBBS

BEING A PART OF LOT NO. 41,
TRACT NO. 4, TOWNSHIP OF CONCORD,
COUNTY OF LAKE, STATE OF OHIO,
AS DESCRIBED IN VOL. 1645-21

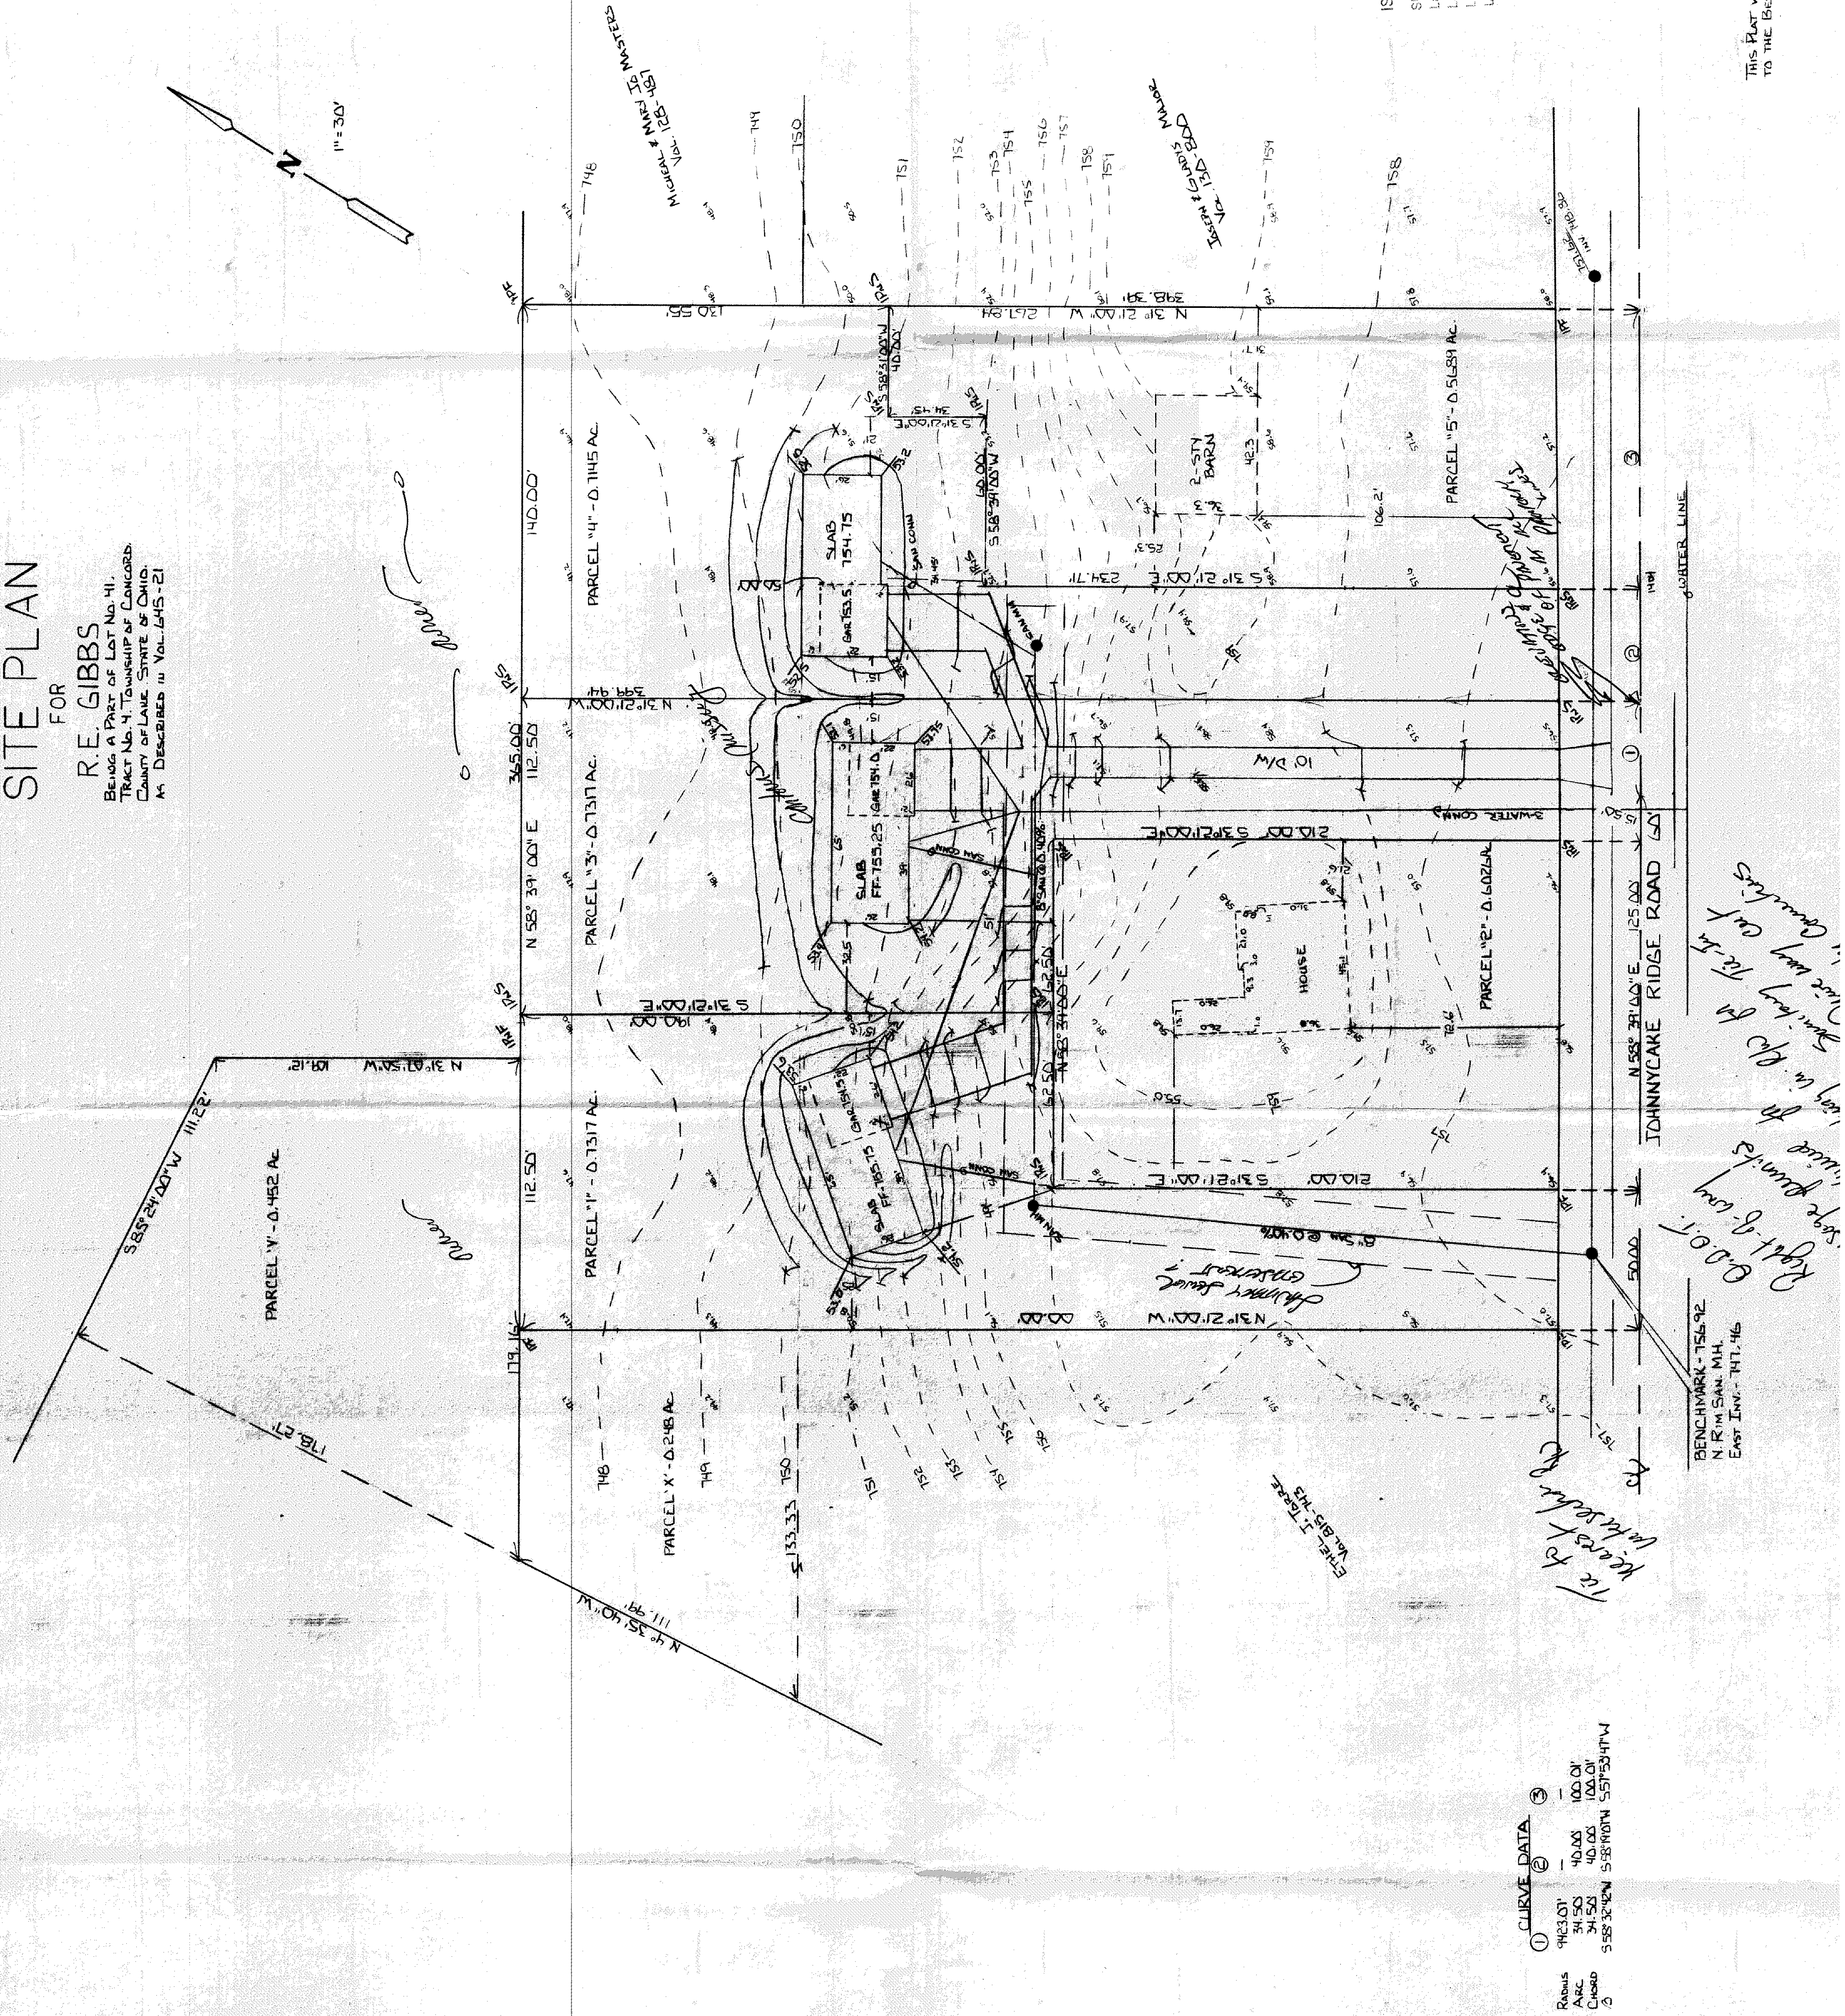


CURVE DATA		③
RADIUS	9463.01'	—
ARC	34.50'	40.00'
CHORD	34.50'	40.00'
	558° 32' 40" N	55° 53' 11" W

6094
6095
6096
ZONING PERMIT # 4-6-89
ISSUED

SUBJECT TO APPROVAL BY:
Lake County Sanitary Eng. ☐
Lake County Eng. Dept. ☒
Lake County Planning Comm. ☐
Lake County Bldg. Dept. ☒

Tamara J. Marano

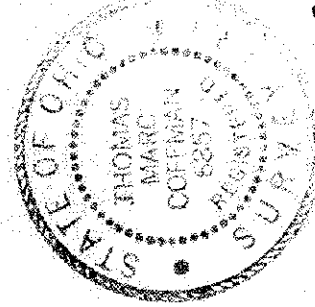

3-15-89
S.P. 5-21-89

THIS PLAN WAS PREPARED BY ME AND IS ACCURATE
TO THE BEST OF MY KNOWLEDGE AND BELIEF

Thomas M. Coffey, P.E.
4-6-89