


272-1071

DATE: 11-30

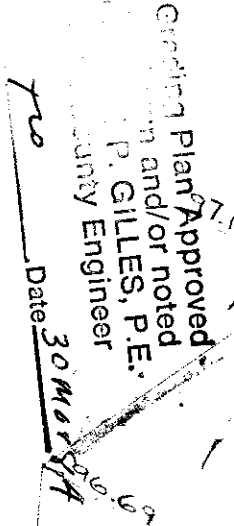

BENCH MARK
TOP OF HYDRANT
ELEV. 100.00

