


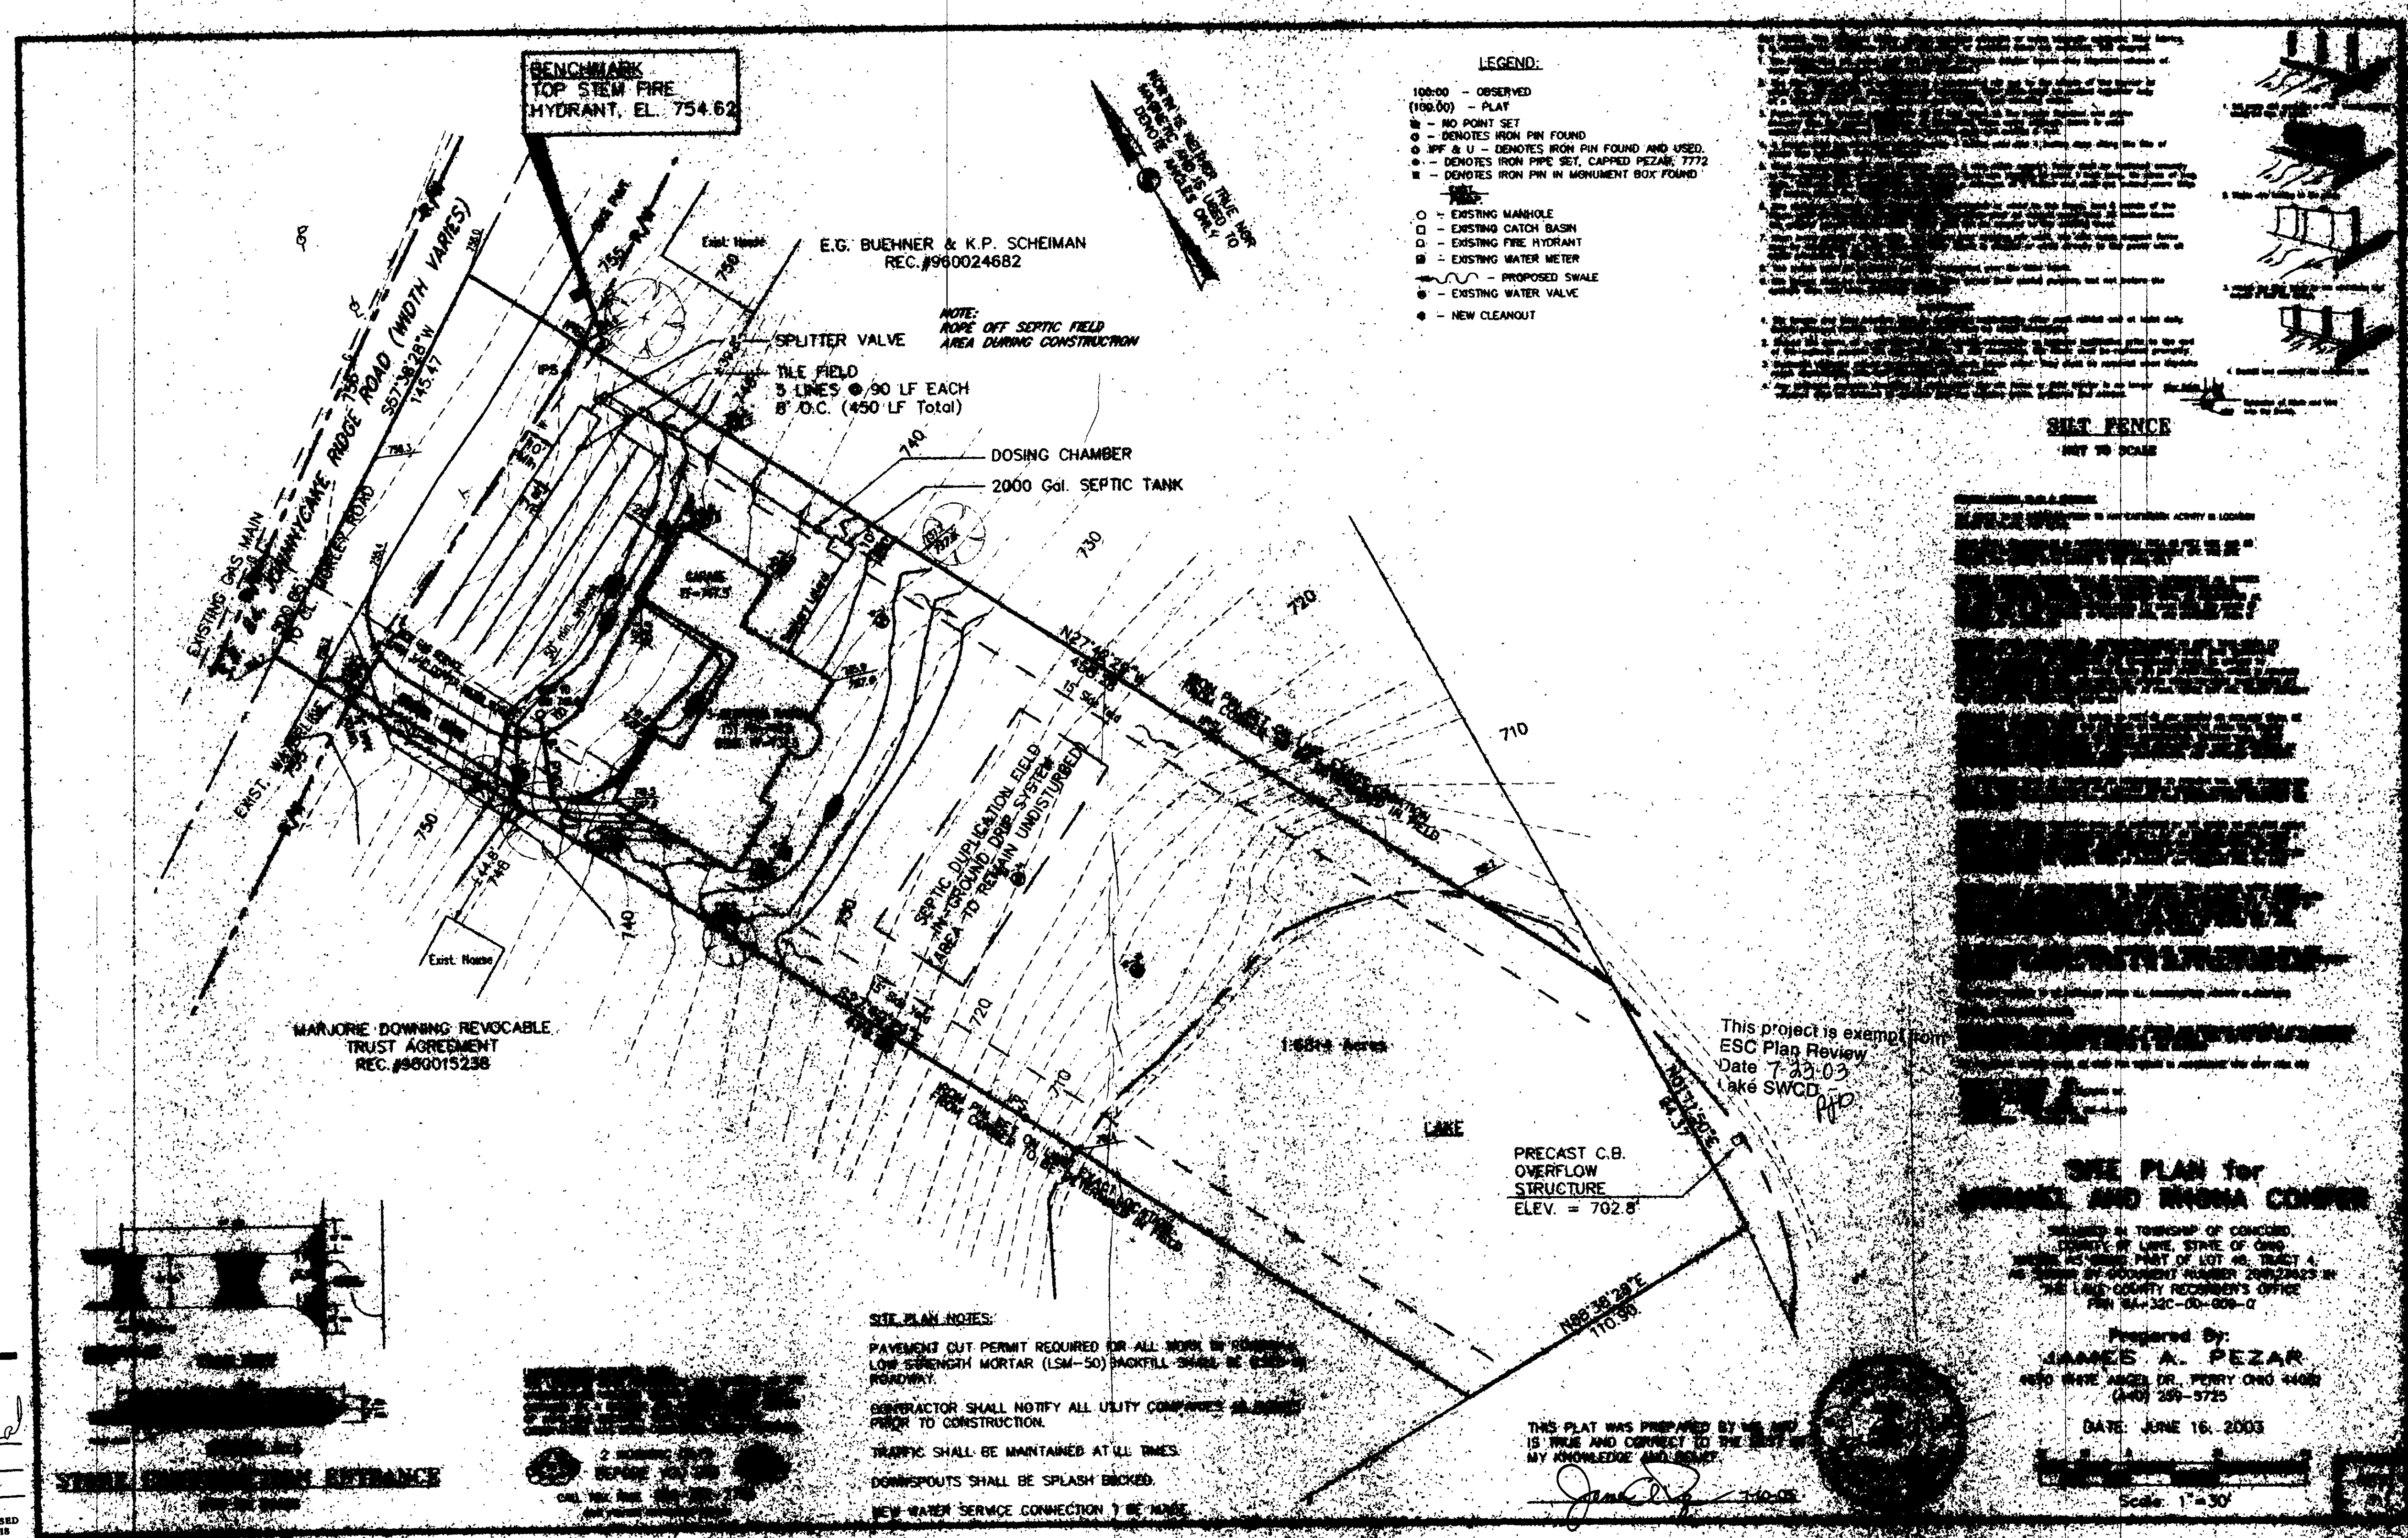

- LEGEND:**
- 100.00 - OBSERVED (100.00) - PLAT
 - NO POINT SET
 - - DENOTES IRON PIN FOUND
 - PF & U - DENOTES IRON PIN FOUND AND USED
 - - DENOTES IRON PIPE SET, CAPPED PEZAR, 7772
 - - DENOTES IRON PIN IN MONUMENT BOX FOUND
- SYMBOLS:**
- - EXISTING MANHOLE
 - - EXISTING CATCH BASIN
 - - EXISTING FIRE HYDRANT
 - - EXISTING WATER METER
 - - PROPOSED SWALE
 - - EXISTING WATER VALVE
 - - NEW CLEANOUT

SHUT FENCE
NOT TO SCALE











Grading Plan Approved
as shown and/or noted
JAMES R. GILLS, P.E.
Lake County Engineer
By *[Signature]* Date 7/14/03

CONCORD TOWNSHIP ZONING OFFICE
ZONING PERMIT # 0203-11161
ISSUED 7/24/03
SUBJECT TO APPROVAL BY:
[] Lake Co. Sanitary Engineer
[] Lake Co. Eng. Dept.
[] Lake Co. Planning Comm.
[] Lake Co. Building Dept.
[] Lake Co. Soil & Water Cons. Dist.

REVIEWED AND ACCEPTED
LAKE COUNTY GENERAL
HEALTH DISTRICT
Date 7-22-03 by *[Signature]*
Seal lines
SEWAGE DISPOSAL PERMIT MUST BE
OBTAINED BY A LAKE-COUNTY LICENSED
INSTALLER BEFORE INSTALLATION IS
STARTED.

SITE PLAN NOTES:
PAVEMENT CUT PERMIT REQUIRED FOR ALL WORK IN EXISTING
LOW STRENGTH MORTAR (LSM-50) BACKFILL SHALL BE USED IN
ROADWAY.
CONTRACTOR SHALL NOTIFY ALL UTILITY COMPANIES AT LEAST
PRIOR TO CONSTRUCTION.
TRAFFIC SHALL BE MAINTAINED AT ALL TIMES.
DOWNSPOUTS SHALL BE SPLASH BACKED.
NEW WATER SERVICE CONNECTION 1" BE NINE.

This project is exempt from
ESC Plan Review
Date 7-23-03
Lake SWCD
[Signature]

SITE PLAN for
JAMES AND RHONA CONFER
OWNER: JAMES AND RHONA CONFER
PROPERTY: 1/2 AC. PART OF LOT 48, TRACT 4,
LAKE COUNTY RECORDS 20022403 IN
THE LAKE COUNTY RECORDS OFFICE
P.M. 14-142-00-000-0
Prepared By:
JAMES A. PEZAR
4050 WHITE ANGEL DR., PERRY ORG 4408
(440) 289-5725
DATE: JUNE 16, 2003
Scale: 1"=30'