


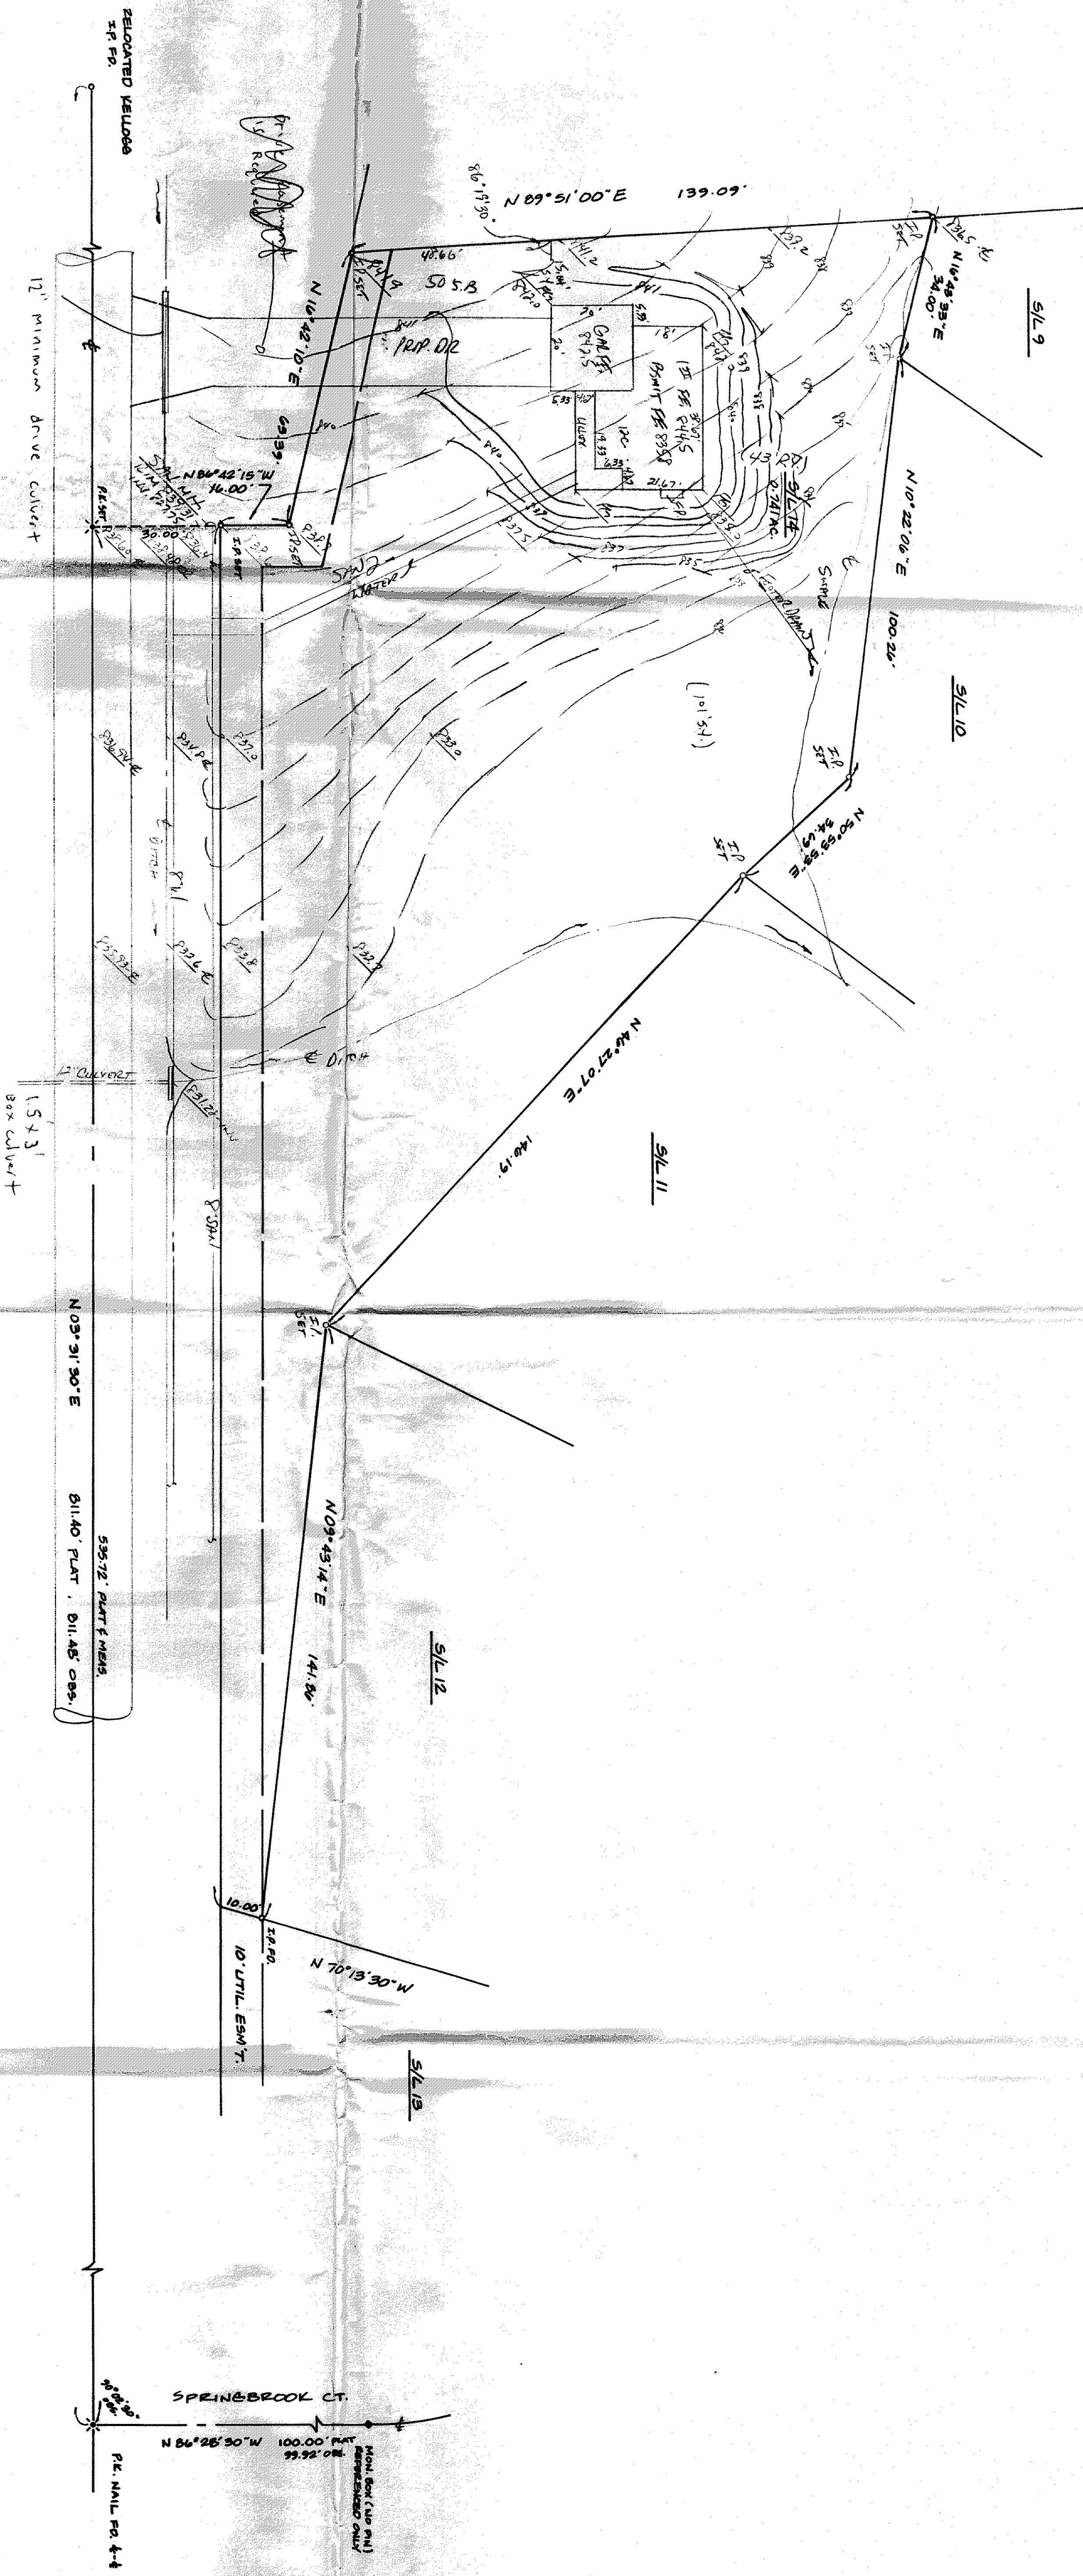

KELLOGG ROAD - 60'

Approved
THOMAS R. GILLESPIE, P.E.
Lake County Engineer
By: GJH Date: 10/14/04

REV NO.	DESCRIPTION	DATE	BY	CHKD

SITE PLAN
FOR
KAY NEUBERT

BABCOCK, JONES AND ASSOCIATES, INC.
CIVIL ENGINEERS - SURVEYORS - LAND PLANNERS
PAINESVILLE OHIO 44077

DATE: AUGUST 1994
DESIGN BY: [Signature]
DRAWN BY: [Signature]
APPROVED BY: [Signature]

SCALE: 1"=20'
JOB NO. 88-037-14
SHEET 1 OF 1

1.5 L.S. BRIDGE 212 KSH-7097
SUBJECT TO APPROVAL BY:
Lake County Sanitary Eng. ☐
Lake County Eng. Dept. ☒
Lake County Planning Comm. ☐
Lake County Bldg. Dept. ☒

