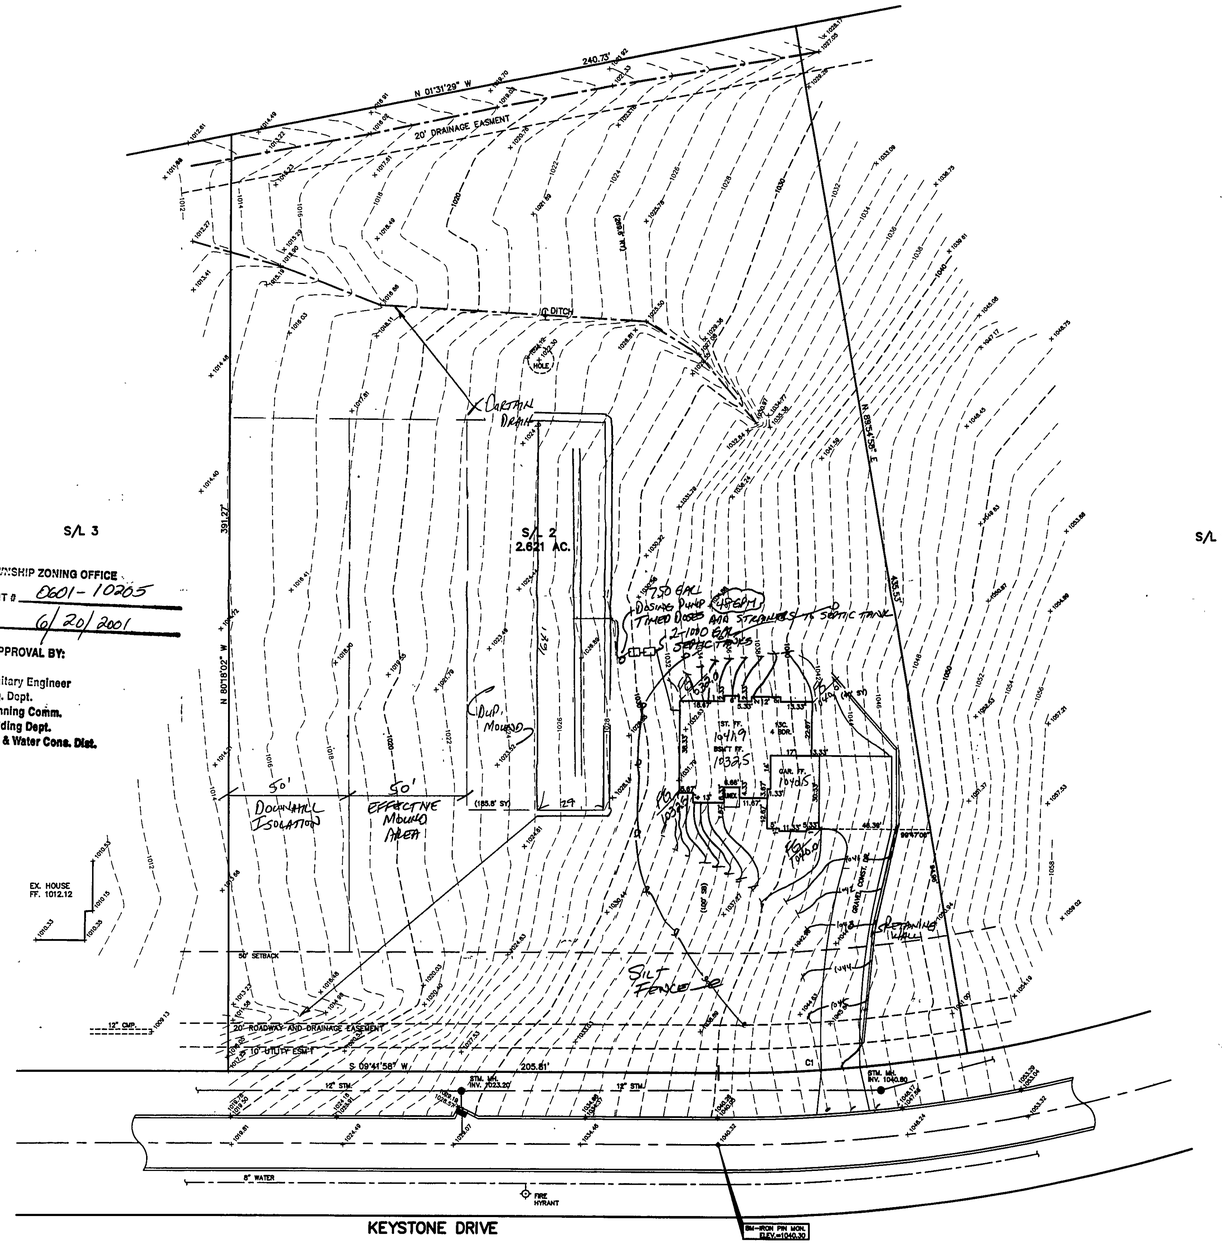

CONCORD TOWNSHIP ZONING OFFICE
ZONING PERMIT # 0601-10205
ISSUED 6/20/2001

SUBJECT TO APPROVAL BY:

- ☐ Lake Co. Sanitary Engineer
- ☒ Lake Co. Eng. Dept.
- ☐ Lake Co. Planning Comm.
- ☒ Lake Co. Building Dept.
- ☒ Lake Co. Soil & Water Cons. Dist.

REVIEWED AND ACCEPTED
LAKE COUNTY GENERAL
HEALTH DISTRICT
Date 6-19-01 By D.DL

SEWAGE DISPOSAL PERMIT MUST BE OBTAINED BY A LAKE COUNTY LICENSED INSTALLER BEFORE INSTALLATION IS STARTED

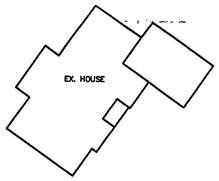

NOTE: LINEAR LOADING RATE - $\frac{417}{3.0}$ = 139'
TOTAL LENGTH OF MOUND =
139' + 12.5' + 12.5' = 164'

NOTE: TEMPORARY SEEDING REQUIRED IN DISTURBED AREAS.

Grading Plan Approved as shown and/or noted
JAMES R. GILLS, P.E.
Lake County Engineer
By TAM Date 6/25/01

ROOF DRAINS SHALL DISCHARGE TO SPLASH BLOCKS.

"I, the undersigned hereby certify that this topography indicated by 6", 1', or 2' contours, and elevations shown hereon represent an actual field survey made by me on the 7TH day of APRIL, 2001 and that the elevations were taken at appropriate intervals and that as of that date they existed as indicated hereon."

Name Reg. No. #6343

C1: R=613.92'
L=104.83'
T=52.54'
D=09°47'00"
C=104.70'
S04°48'28"W

REV NO.	DESCRIPTION	DATE	BY	CHK'D
1	REVISED MOUND	6/6/01	HT	HJ
2	" PER LCHD - 39'	6/19/01	HT	HJ

STATE OF OHIO HARRY E. JONES, JR. E-6343 REGISTERED PROFESSIONAL SURVEYOR

BABCOCK, JONES AND ASSOCIATES, INC
CIVIL ENGINEERS – SURVEYORS – LAND PLANNERS
PAINESVILLE OHIO 44077

DATE 4/12/01
DESIGN BY H.J.
DRAWN BY T.R.
APPROVED BY H.J.

SITE PLAN
FOR
LONGAR CONSTRUCTION
S/L 2 WOODCREST SUBDIVISION
CONCORD TOWNSHIP LAKE COUNTY

SCALE: 1"=30'
JOB NO 99-166-02
SHEET 1 OF 2