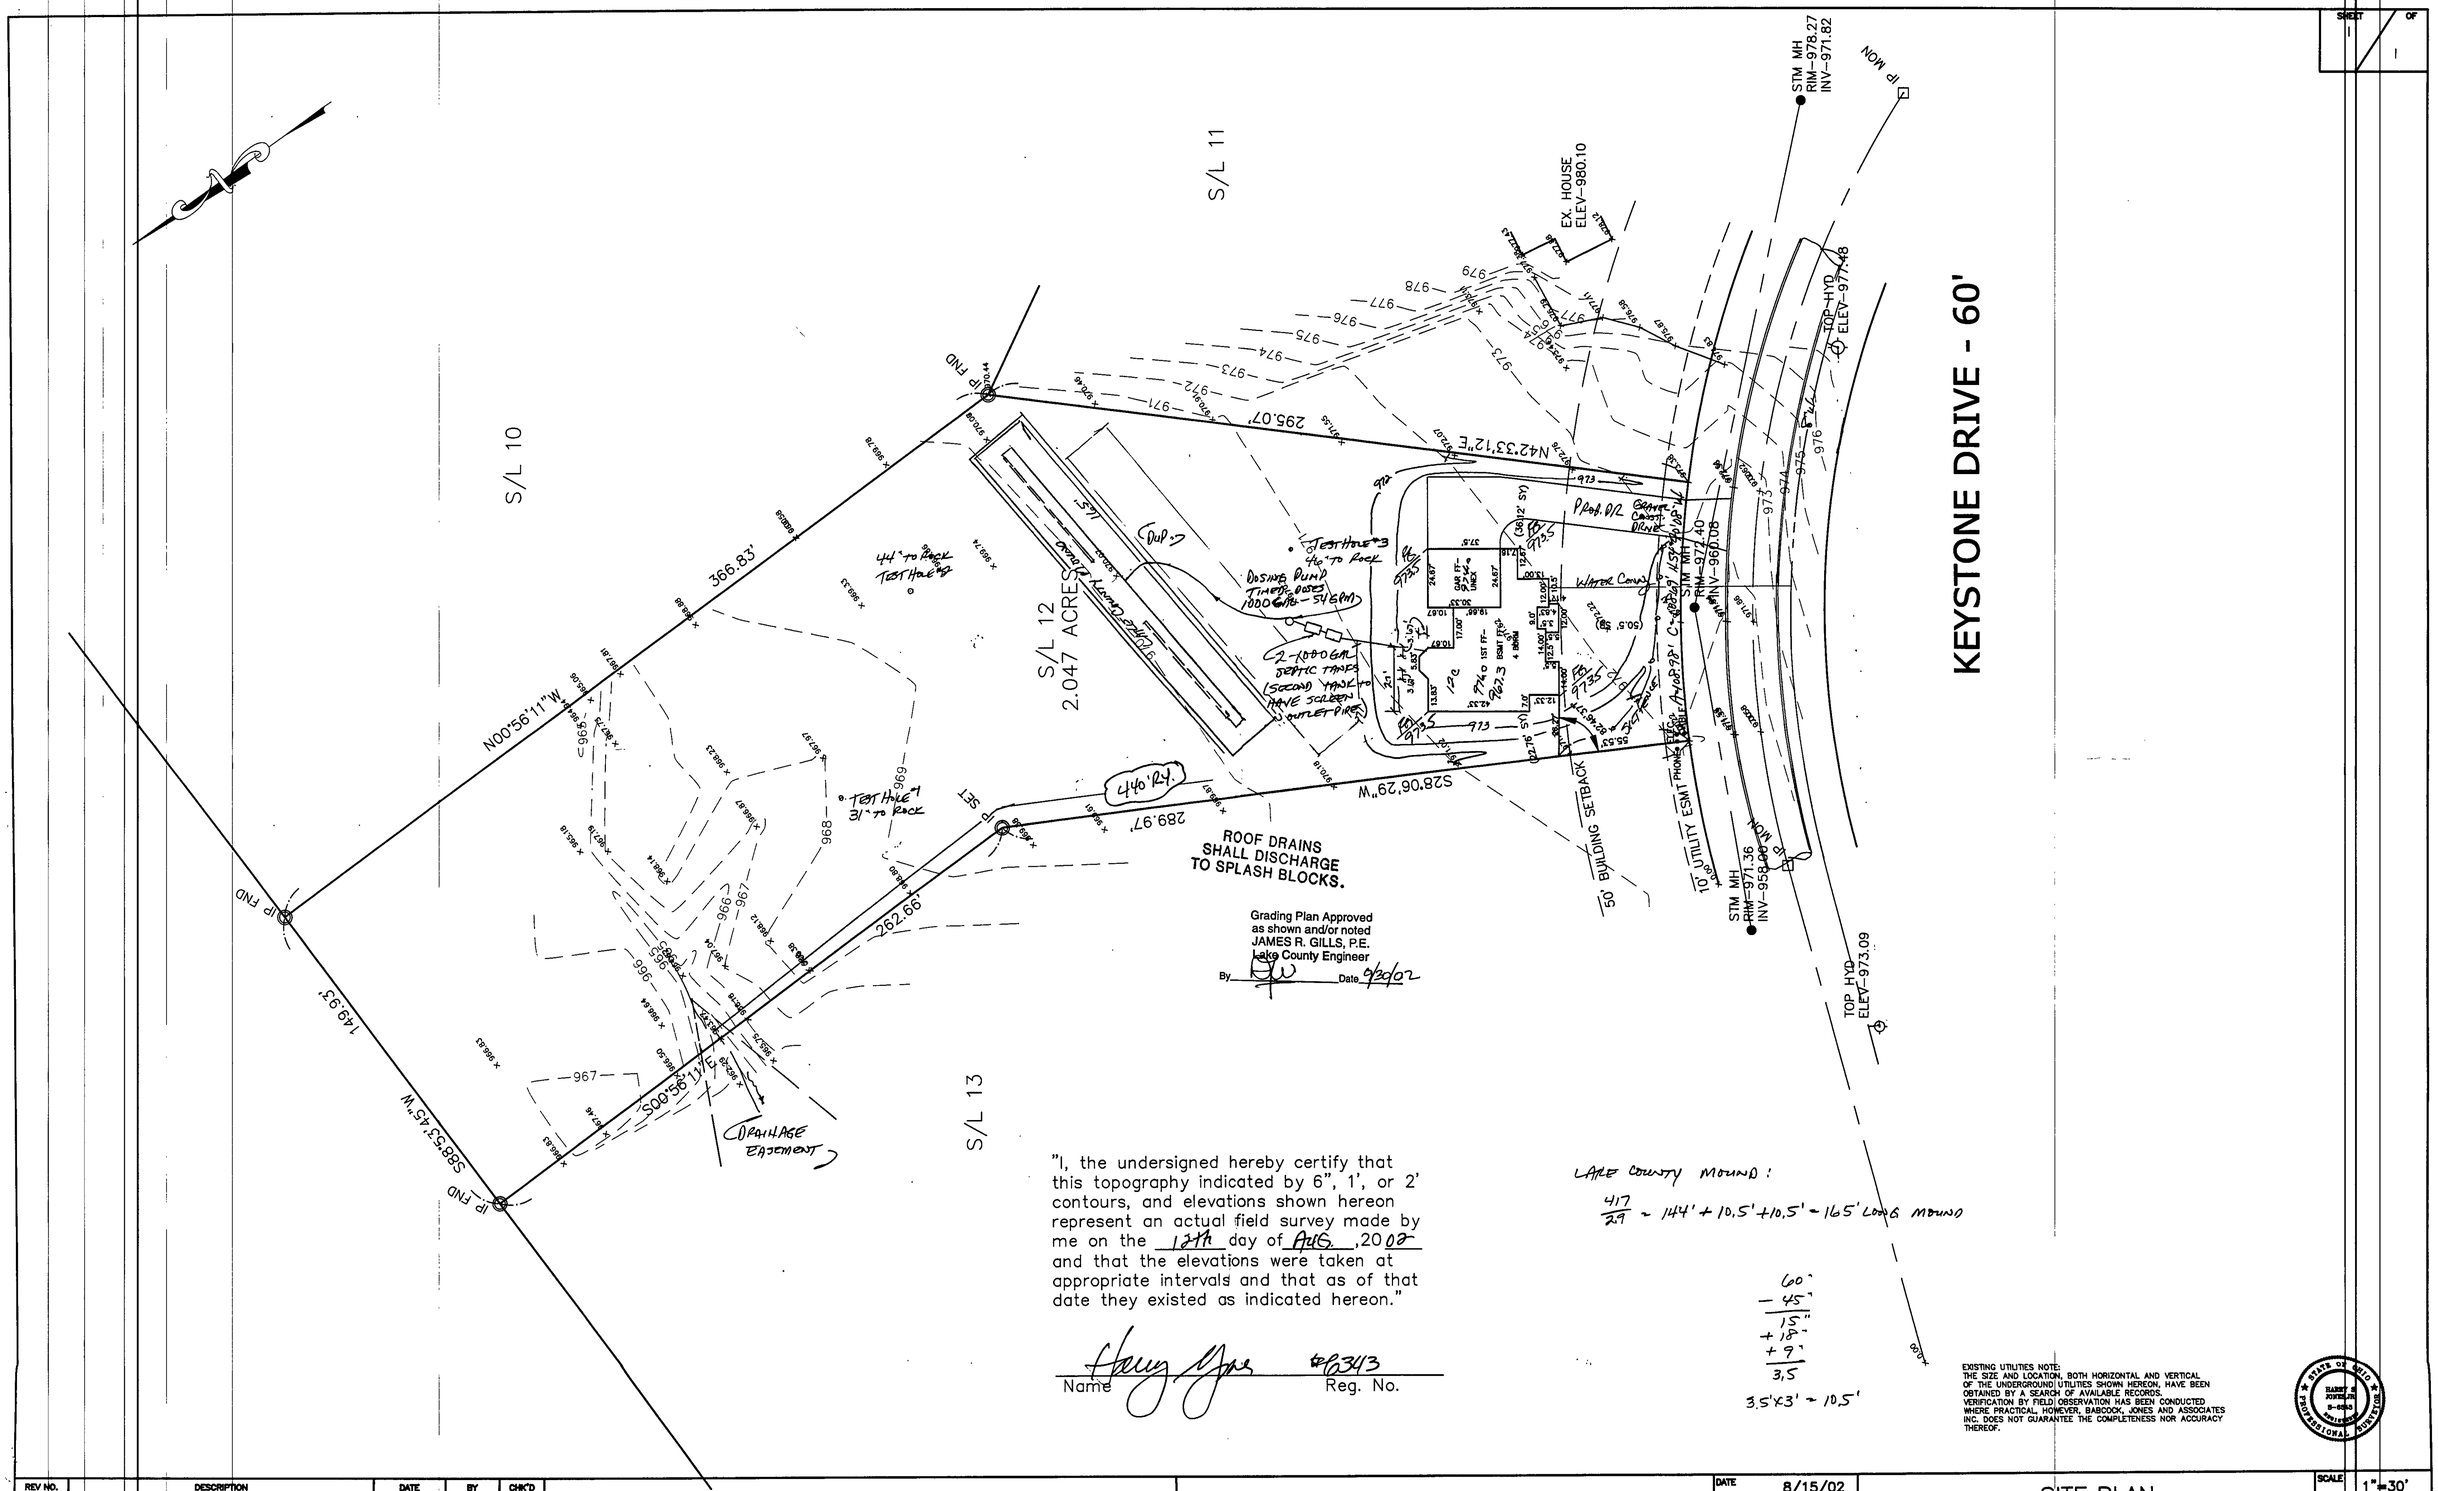

"I, the undersigned hereby certify that this topography indicated by 6", 1', or 2' contours, and elevations shown hereon represent an actual field survey made by me on the 12th day of AUG., 2002 and that the elevations were taken at appropriate intervals and that as of that date they existed as indicated hereon."

Name #P-3413 Reg. No.

LAKE COUNTY MOUND:

$\frac{417}{2.9} = 144' + 10.5' + 10.5' = 165'$ LONG MOUND

60'
− 45'
15'
+ 18'
+ 9'
3.5

3.5'×3' = 10.5'

EXISTING UTILITIES NOTE:
THE SIZE AND LOCATION, BOTH HORIZONTAL AND VERTICAL OF THE UNDERGROUND UTILITIES SHOWN HEREON, HAVE BEEN OBTAINED BY A SEARCH OF AVAILABLE RECORDS. VERIFICATION BY FIELD OBSERVATION HAS BEEN CONDUCTED WHERE PRACTICAL, HOWEVER, BABCOCK, JONES AND ASSOCIATES INC. DOES NOT GUARANTEE THE COMPLETENESS NOR ACCURACY THEREOF.

STATE OF OHIO HARRY JONES JR. E-8908 REGISTERED PROFESSIONAL SURVEYOR

REV NO.	DESCRIPTION	DATE	BY	CHK'D
1	REVISED MOUND	9-6-02	HJ	HJ
2	REVISED MOUND	9-18-02	HJ	HJ
3	REVISED DOSING CHAMBER	9-19-02	HJ	HJ

BABCOCK, JONES AND ASSOCIATES, INC
CIVIL ENGINEERS – SURVEYORS – LAND PLANNERS
PAINESVILLE OHIO 44077

DATE	8/15/02
DESIGN BY	HJ
DRAWN BY	NS
APPROVED BY	HJ

SITE PLAN FOR RIVER OAKS
CONCORD TOWNSHIP LAKE COUNTY STATE OF OHIO

SCALE 1"=30'
JOB NO. 99-166-12
SHEET 1 OF 2