


orary Seeding Species Sele	ction		
ng Dates	Species	Lb./1,000 ft. ²	Per Ac
n 1 to August 15	Oats Tell Fescue Annual Ryegrass	3 · 1 1	4 bushel 40 lb. 40 lb.
	Perennial Ryegrass Tall Fescue Annual Ryegrass	1 1 1	40 lb. 40 lb. 40 lb.
st 16 to November 1	Rye Tall Fescue Annual Ryegrass	3 1 1	2 bushel 40 lb. 40 lb.
	Wheat Tall Fescue Annual Ryegrass	3 1 1	2 bushel 40 lb. 40 lb.
	Perennial Ryegrass Tall Fescue Annual Ryegrass	1 1 1	40 lb. 40 lb. 40 lb.
nber 1 to Spring Seeding	Use mulch only, sodding practices or dormant seeding.		
Other approved seed species m	ay be substituted		

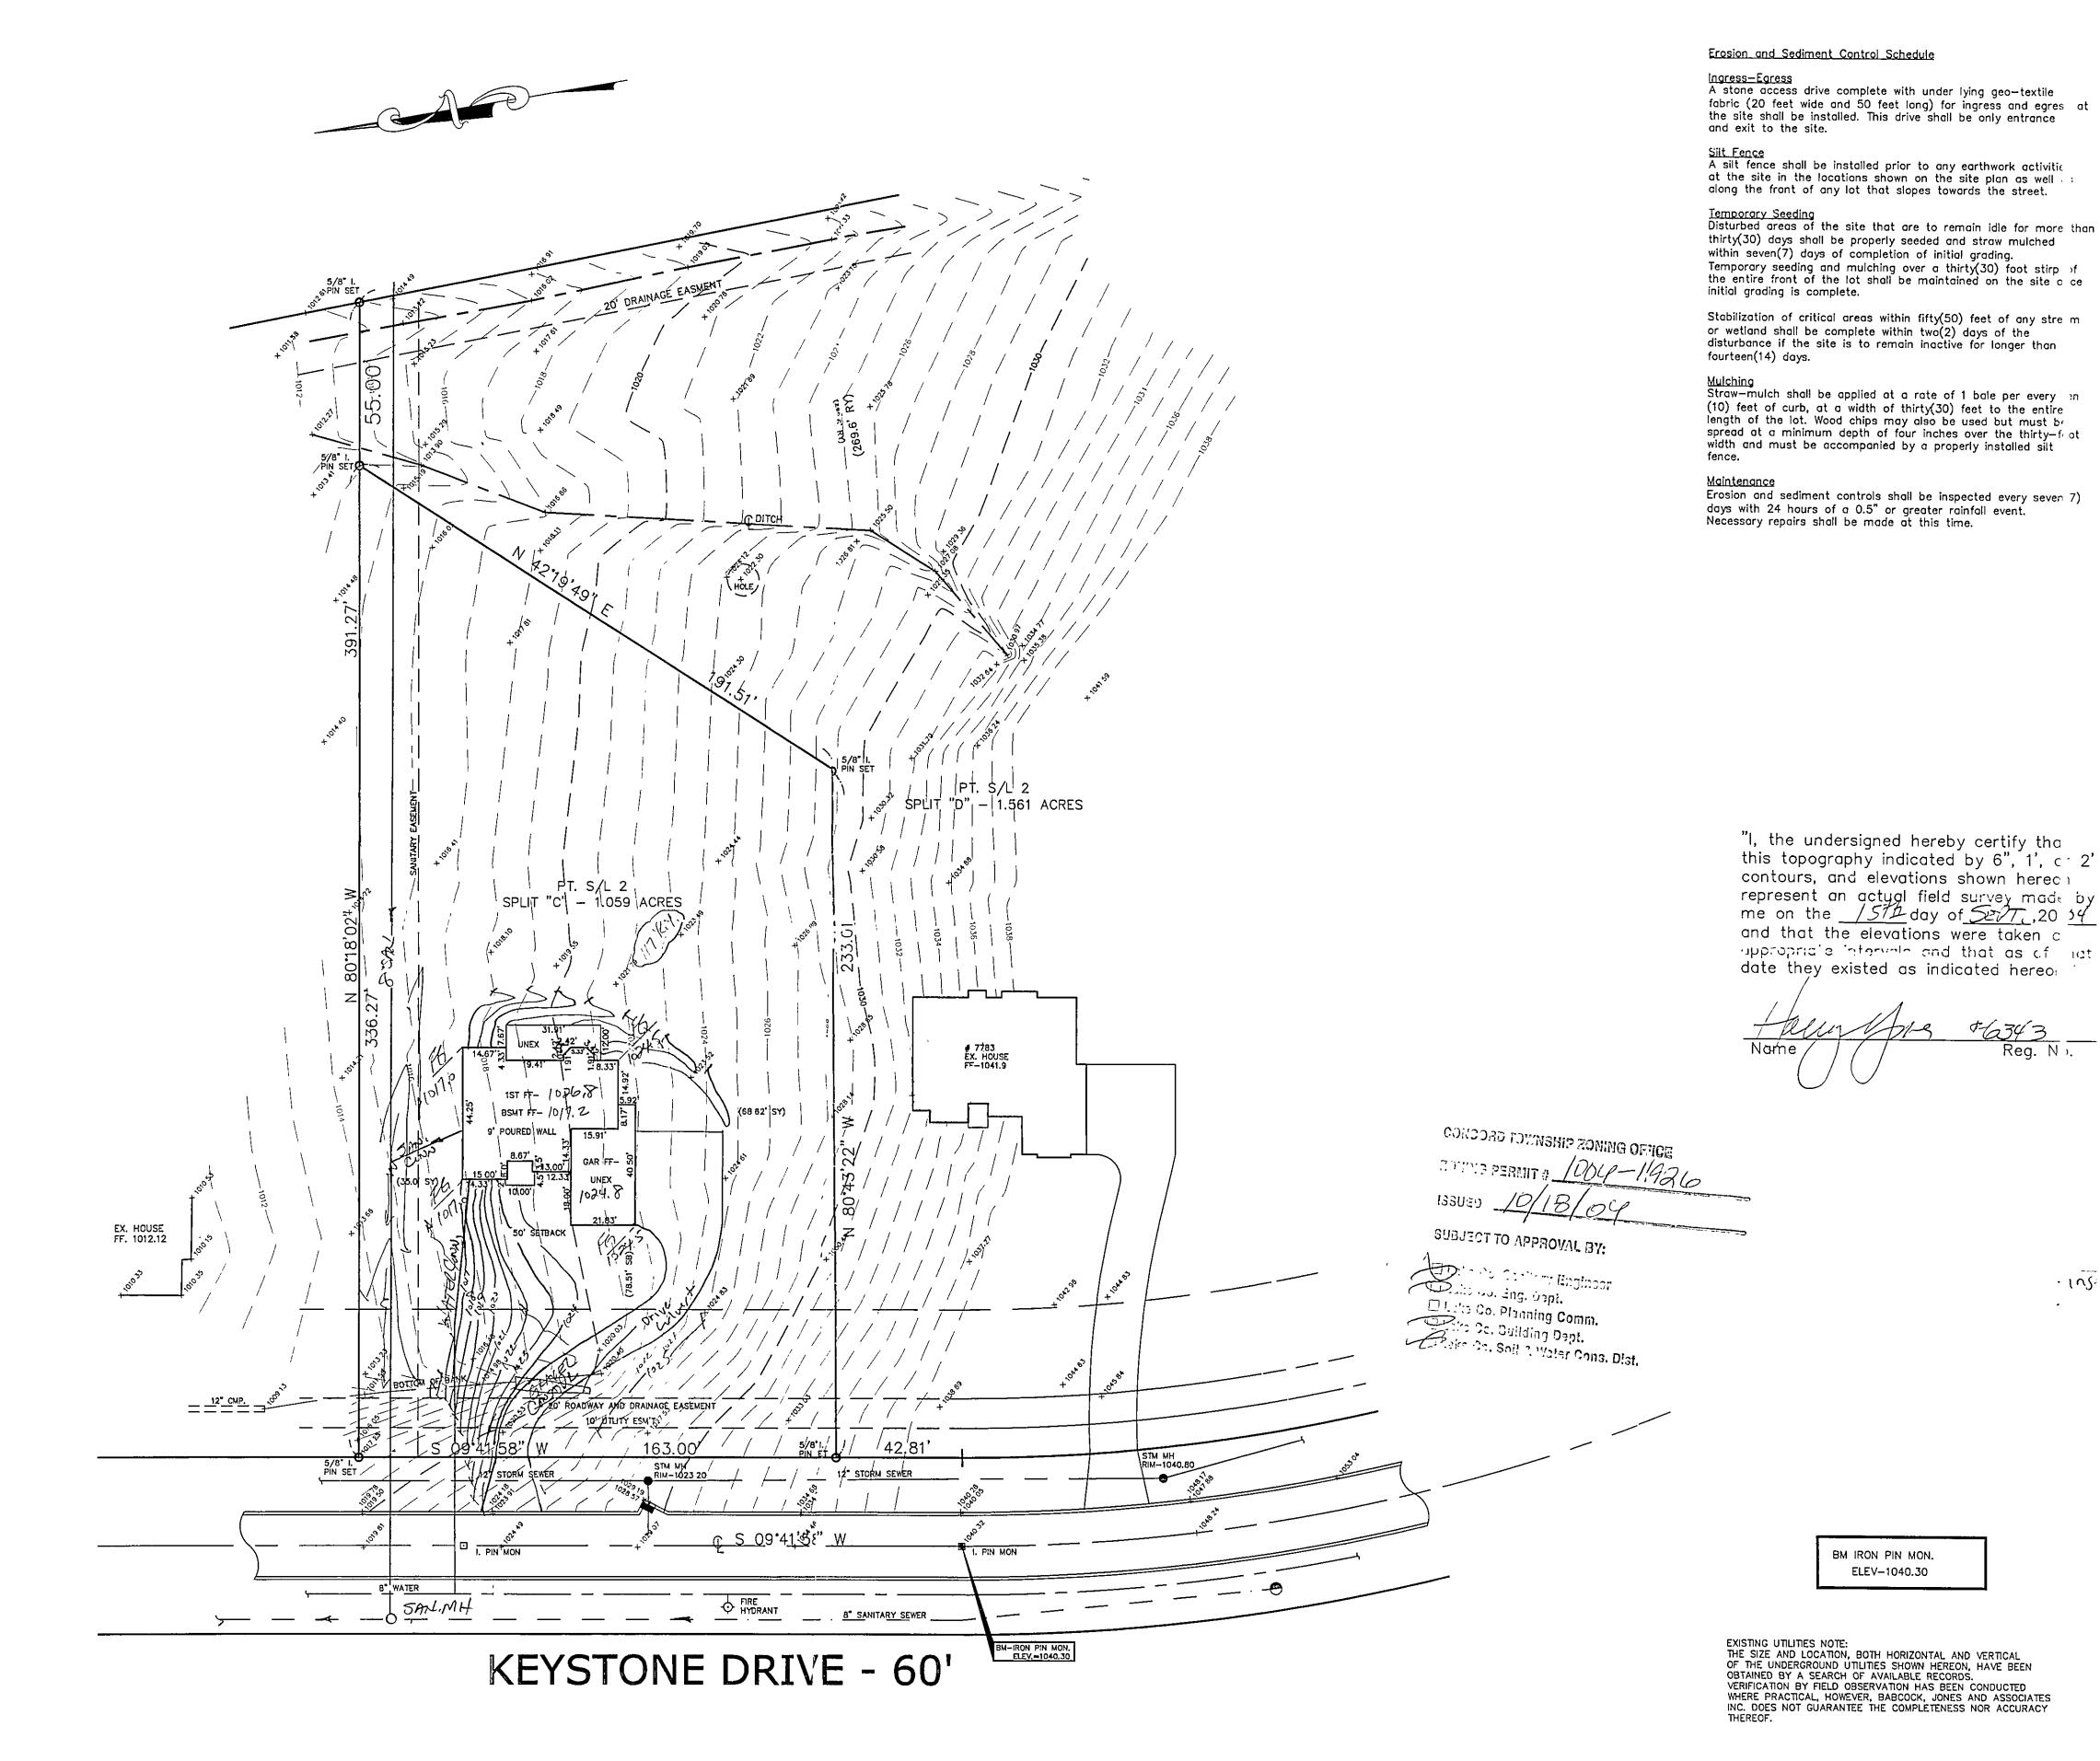

DESCRIPTION

BABCOCK, JONES AND ASSOCIATES, INC

CIVIL ENGINEERS - SURVEYORS - LAND PLANNERS PAINESVILLE OHIO 44077 PHONE: 440-357-1811 FAX: 440-357-9173

`	DATE	9/21/04	
,	DESIGN BY	HJ	
	DRAWN BY	NS	S
	APPROVED BY	HJ	\

SITE PLAN FOR LOU LONCAR

ELEV-1040.30

S/L 2-C KEYSTONE DRIVE WOODCREST SUB. VOL. 34 - F CONCORD TOWNSHIP

LAKE COUNTY

STATE)F C