

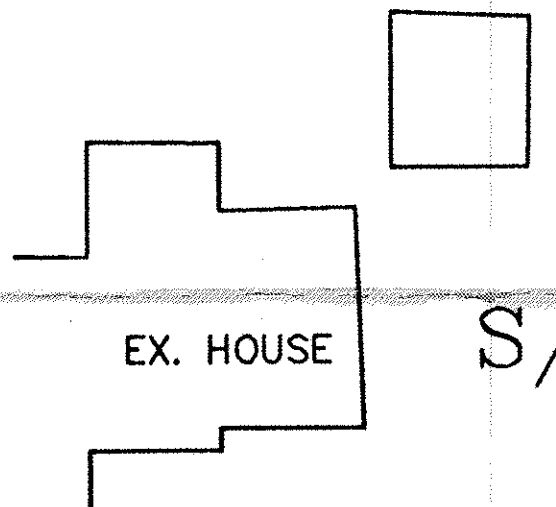


CONCORD TOWNSHIP ZONING
Permit # 0802-1397
Subject to Approval By:
Lake Co. Engineer/Storm Water Mgmt
Lake Co. Utilities Dept.
Lake Co. Soil + Water District
Lake Co. Health District
Lake Co. Building Dept.

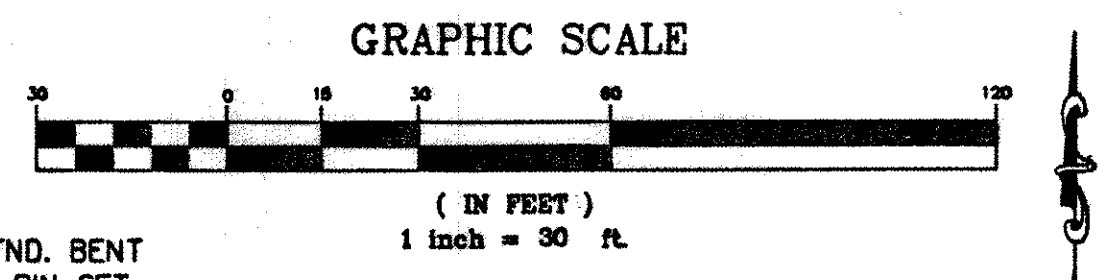

MORLEY RD. 60'

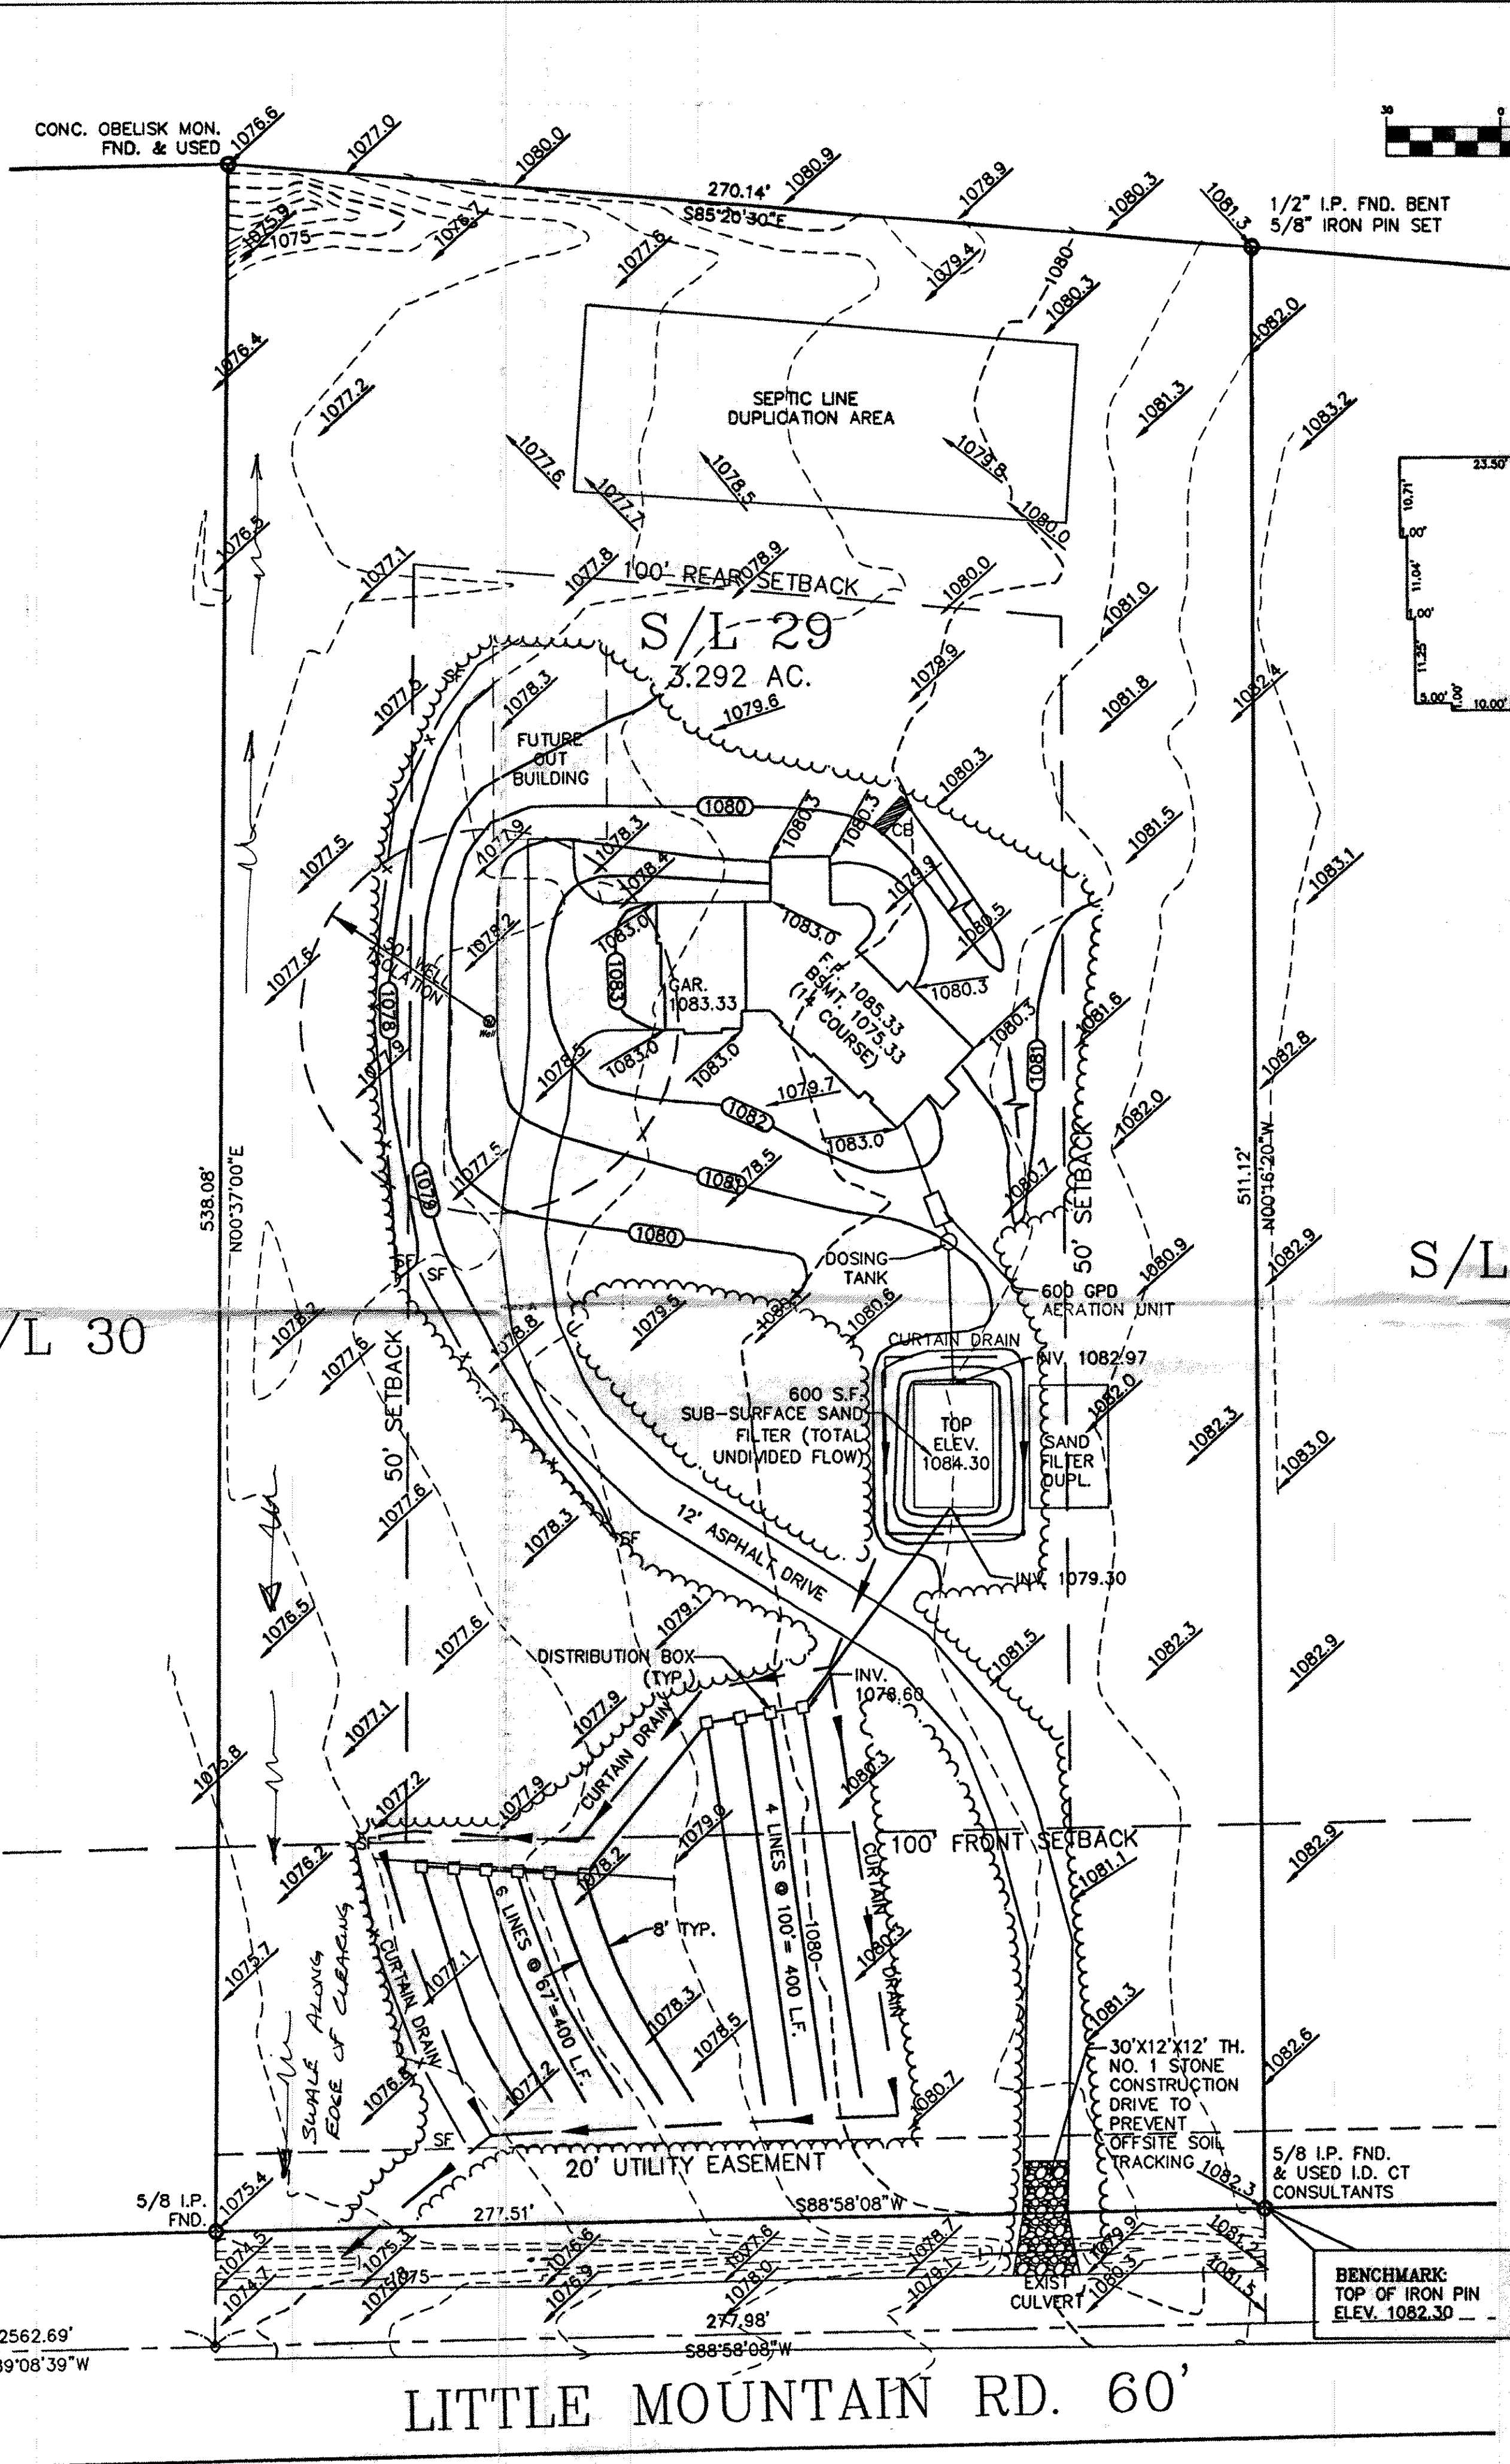






I, THE UNDERSIGNED, HEREBY DECLARE THAT THE TOPOGRAPHY SHOWN HEREON, INDICATED BY ONE FOOT CONTOURS AND ELEVATIONS, REPRESENTS AN ACTUAL FIELD TOPOGRAPHIC SURVEY MADE UNDER MY SUPERVISION ON THE 28TH DAY OF JULY, 2009 AND THAT THE ELEVATIONS SHOWN WERE TAKEN AT APPROPRIATE INTERVALS AND THAT AS OF THAT DATE THEY EXISTED AS INDICATED HEREON.

I ALSO DECLARE THAT THIS SEWAGE SYSTEM DESIGN MEETS THE MINIMUM REQUIREMENTS ESTABLISHED BY THE LGHD IN THE HSTS GUIDANCE MANUAL, AND THE REQUIREMENTS AND RECOMMENDATIONS OF THE SYSTEM MANUFACTURER.

JOSEPH GUTOSKEY P.S. #7567

NOTE: SEEDING OR MULCHING SHALL BE COMPLETED WITHIN 30 DAYS OF COMPLETION OF HOUSE.

LIMIT OF DISTURBANCE: SHOWN ON PLAN

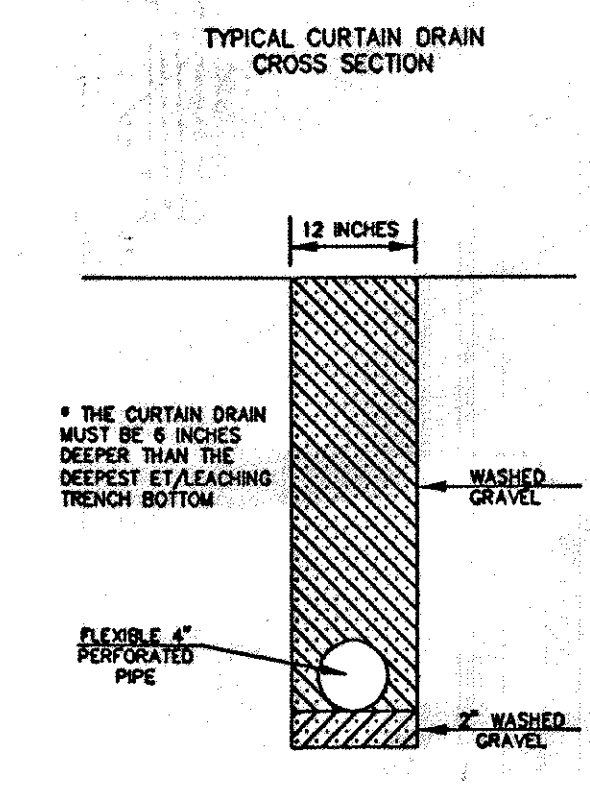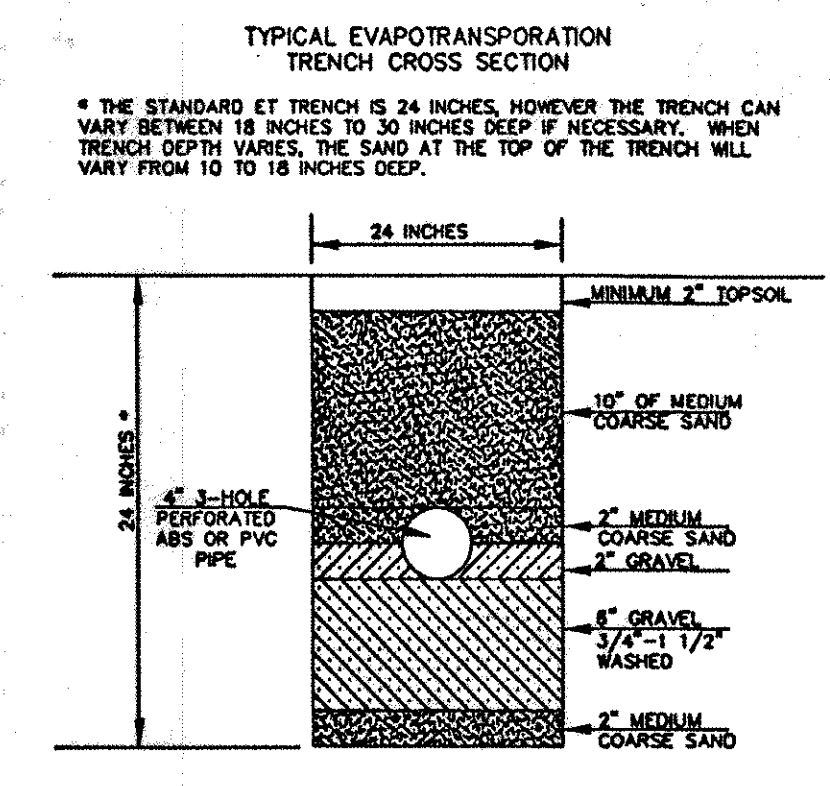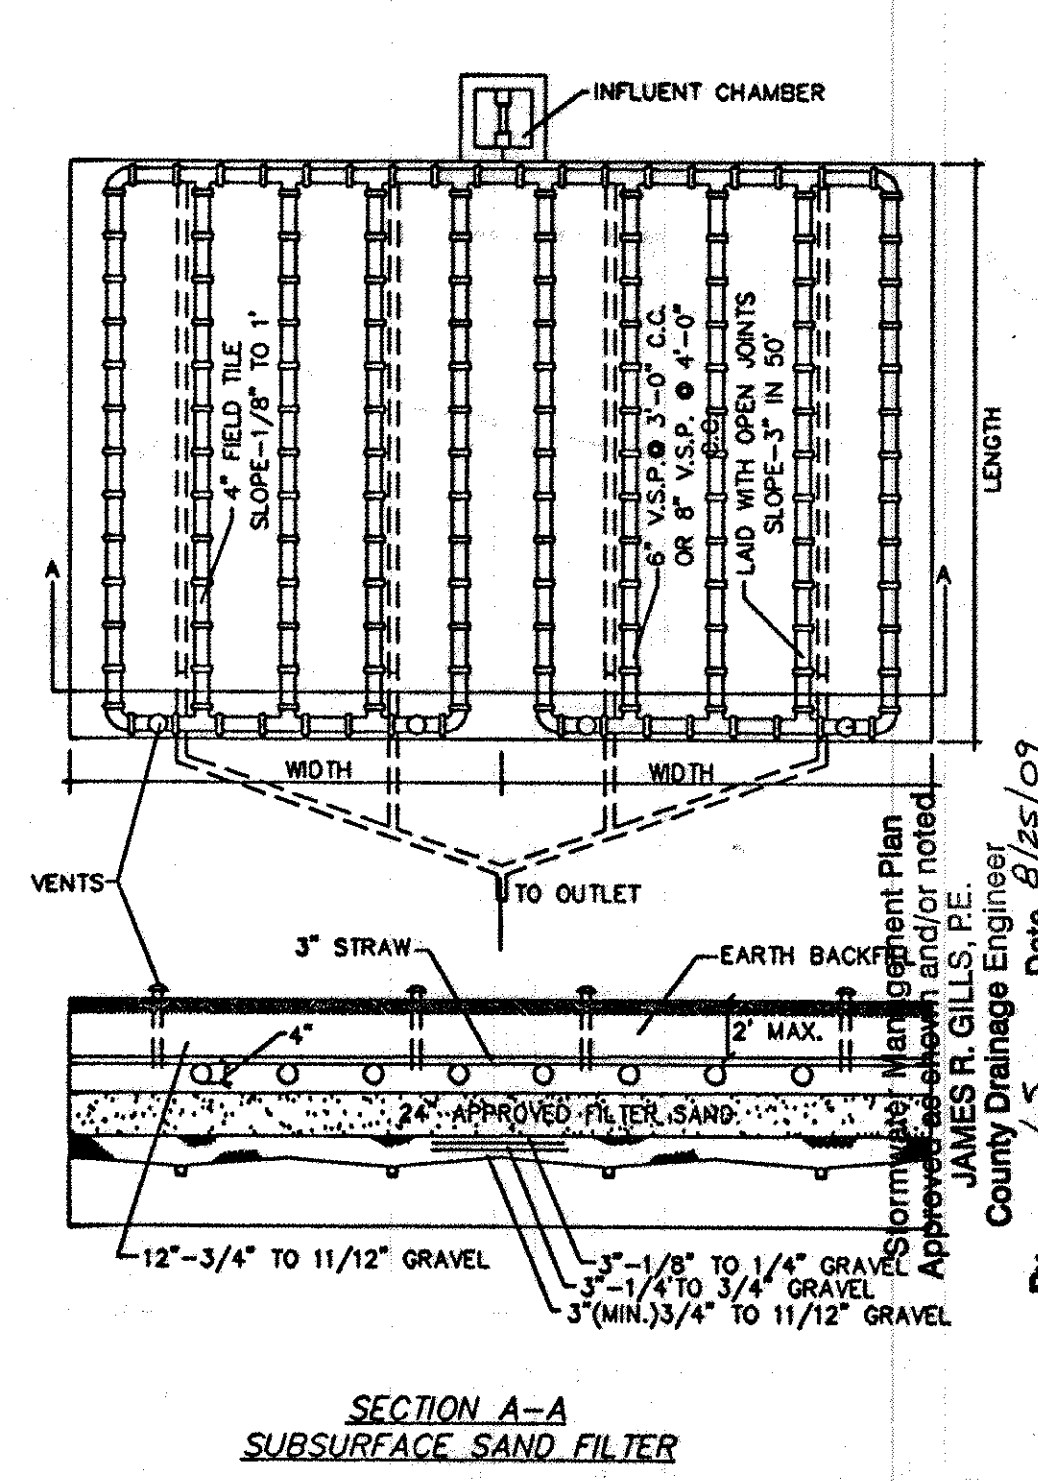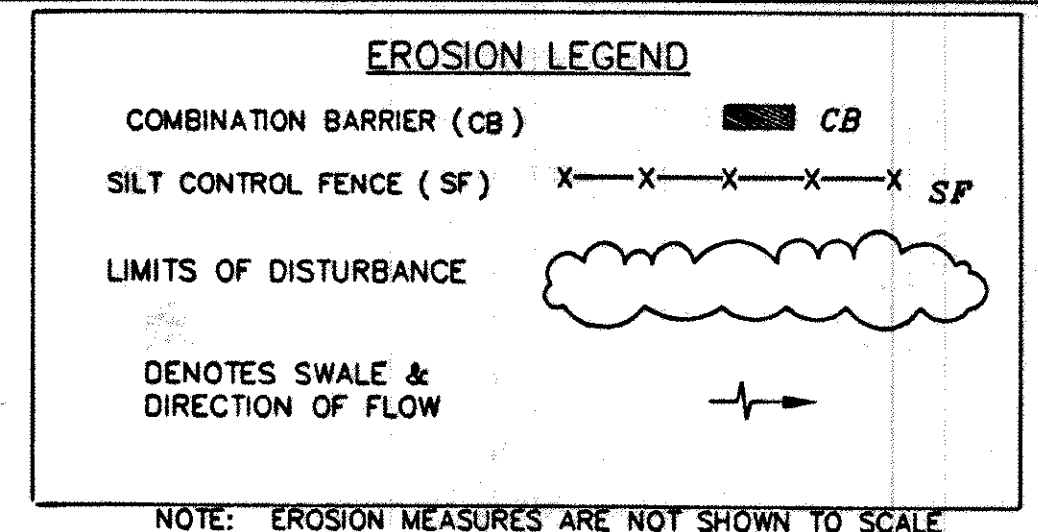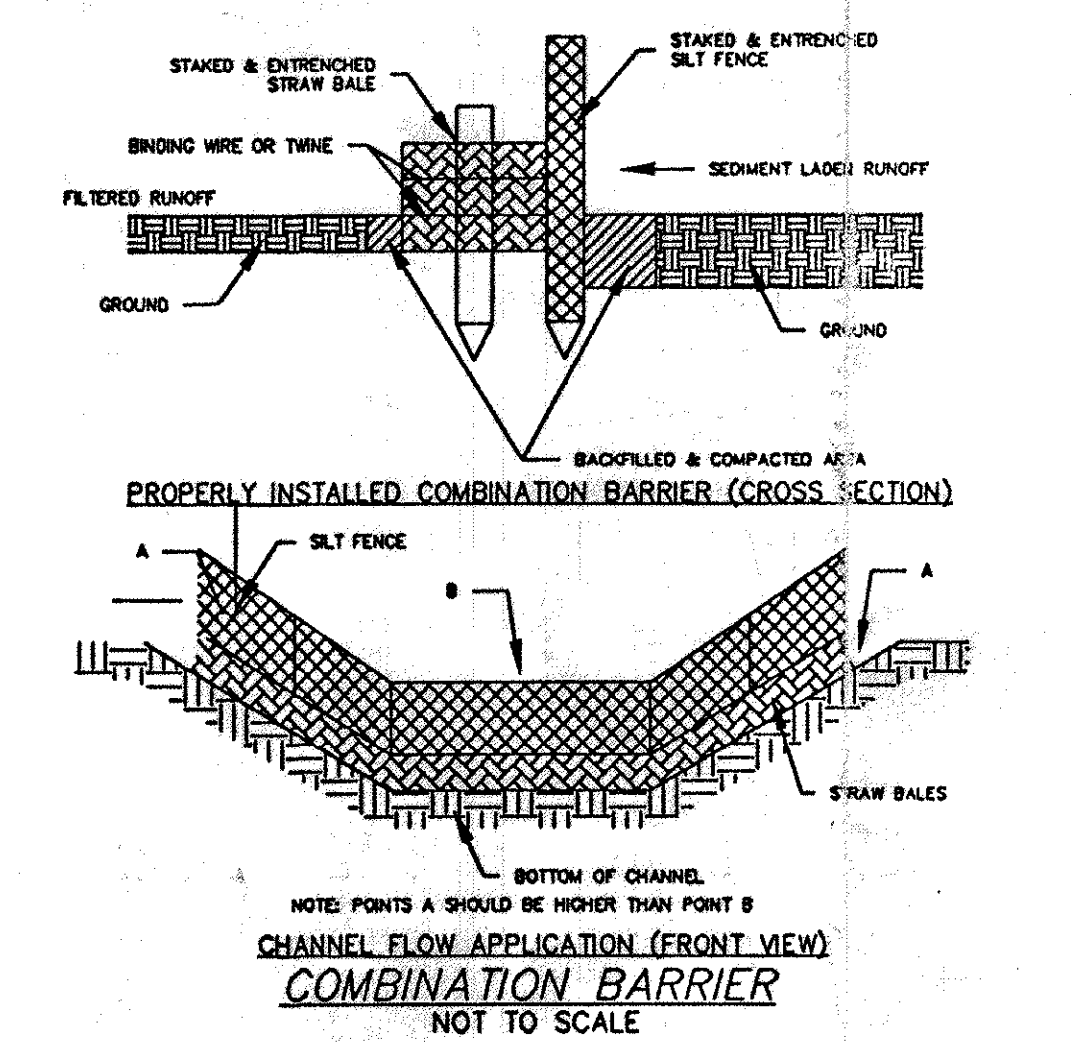

Erosion and Sediment Control Schedule

Ingress/Egress
A silt fence shall be installed with a minimum 20 foot wide and 50 foot long for ingress and egress at the site. This drive shall be the only entrance and exit to the site.


Silt Fence
All silt fence shall be installed prior to any earthwork activities at the site in the locations shown on the site plan as well as along the front of any lot that slopes towards the street.

Temporary Seeding
Disturbed areas of the site that are to remain idle for more than Twenty-one (21) days shall be properly seeded and straw mulched within seven (7) days of completion of initial grading. Temporary seeding and mulching of a thirty (30) foot strip of the entire front of the lot shall be maintained on the site once initial grading is complete.

Stabilization of critical areas
Within fifty (50) feet of any stream or wetland shall be complete within two (2) days of the disturbance if the site is to remain inactive for longer than fourteen (14) days.

Mulching
Straw/mulch shall be applied at a rate of 1 bale per every ten (10) feet of curb, at a width of thirty (30) feet of the entire length of the lot. Wood chips may also be used but must be spread at a minimum depth of four inches over the thirty-foot width and must be accompanied by a properly installed silt fence.

Maintenance
Erosion and sediment controls shall be inspected every seven (7) days or within 24 hours of a 0.5\"/>

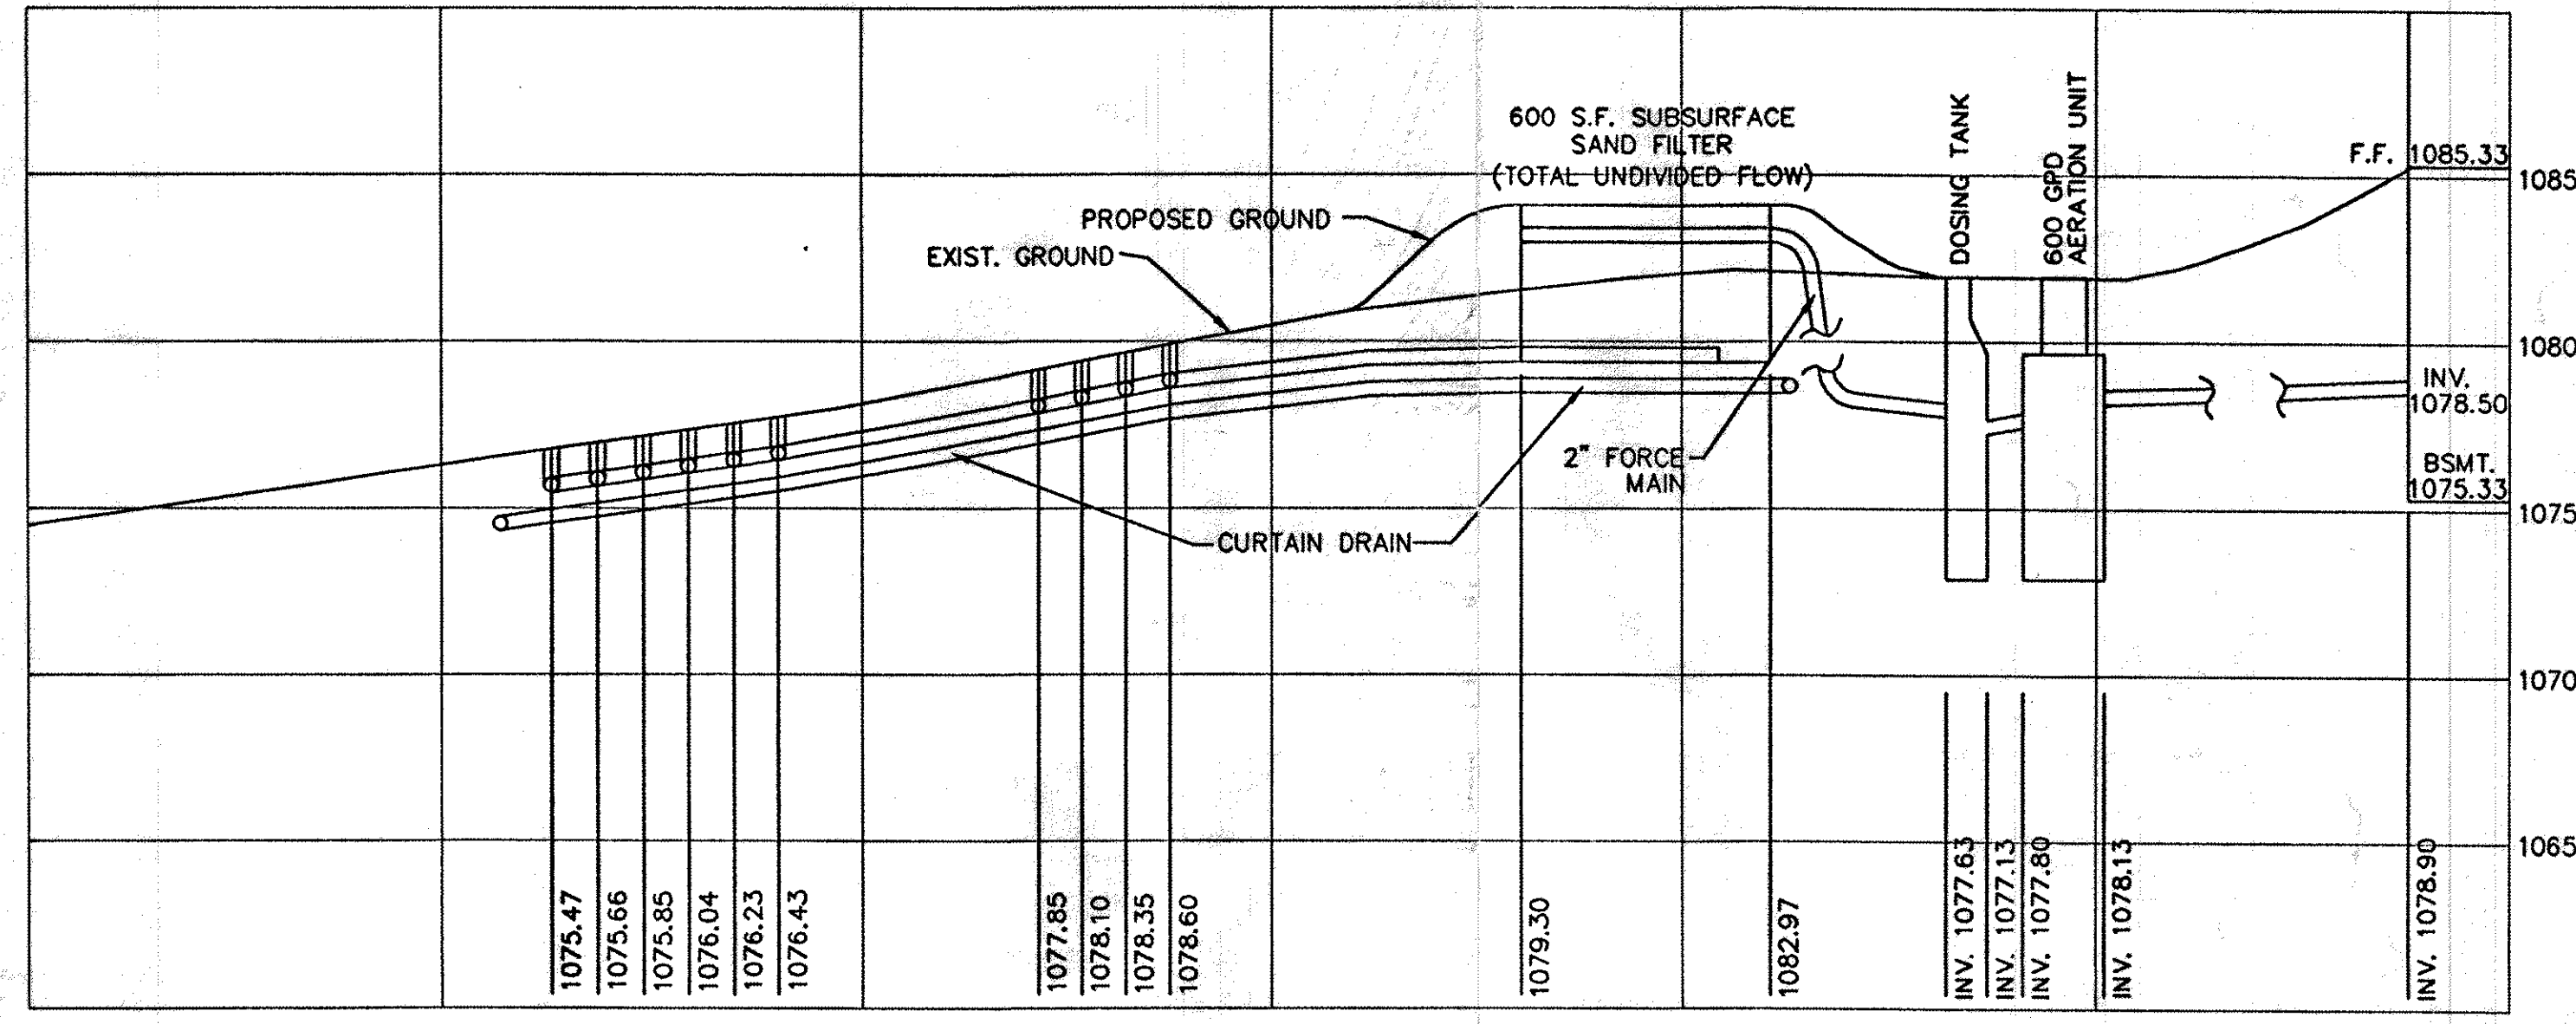

Revisions:

1	
2	
3	
4	
5	
6	
7	

ZERBE RESIDENCE
SUBLOT 29 HARWOOD PHASE 4
VOL. 10 PG. 31
CONCORD TOWNSHIP - LAKE COUNTY - OHIO

GUTOSKEY & ASSOCIATES INC.
Civil Engineers and Surveyors
19798 MORN ROAD, SUITE 3
CHAGRIN FALLS, OHIO 44024
Tel (440) 645-6800
Fax (440) 645-7176

SITEPLAN
PINNACLE CONSTRUCTION
38220 WILLOUGHBY DR.

Date: JULY, 2009
Scale: Hor. 1\"/>