

SITE PLAN FOR:

RYAN HOMES

23600 MERCANTILE RD.

BEACHWOOD, OHIO

PREPARED BY:

WM. R. GRAY ASSOC. INC.

7547 MENTOR AVE.

MENTOR, OHIO

DATE: APR. 16 1975

SCALE: 1" = 20'

CERTIFICATION:

I HEREBY CERTIFY THAT THIS
PLAN IS CORRECT TO THE BEST OF
MY KNOWLEDGE.


By: *Wm R Gray*
WM. R. GRAY REG. SURV. # 2752

Grading Plan Approved
as shown and/or noted
S. P. GILLES, P.E.

JWK

4-24-75

*3rd printing # 2799
issued 4-16-75
J.E. new print*

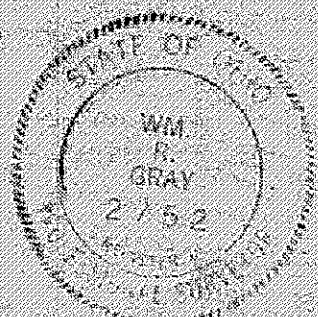

BEING SUBLT No. 19 IN THE HOLLY
PARK SUBDIVISION LOCATED IN CONCORD
TWP., OHIO.

N

SL 20

SL 19

SL 18

TOP OF FH.
T.B.M.
760.52

MARTINIQUE DR. 60'

NO PAVEMENT PRESENT

WATER LINE

SAN SEW.

PROPOSED
HOUSE

PROPOSED HOUSE
FIN. FL. EL. = 761.25
GAR. FIN. FL. EL. = 759.75
BSMT. FIN. FL. EL. = 753.38

PROPOSED
GRAVEL DRIVE

SAN. M.H.

IN. EL. = 758.00

IN. EL. = 731.00

