

SITE PLAN FOR:

RYAN HOMES

23600 MERCHANTILE ROAD
BEACHWOOD, OHIO.

BEING SUBLOT NO. 6 IN MARTINIQUE
ESTATES SUBDIVISION IN CONCORD TWP.,
OHIO.

PREPARED BY:



WM. R. GRAY ASSOC., INC.
CIVIL ENGINEERS & SURVEYORS
7947 MENTOR AVENUE
MENTOR, OHIO.

DATE: JULY 23, 1975 SCALE: 1"=20'

CERTIFICATION:

I HEREBY CERTIFY THAT THIS PLAN IS
CORRECT TO THE BEST OF MY KNOWLEDGE.

By: WM. R. Gray (P.E.)
WM. R. GRAY P.E. #2752

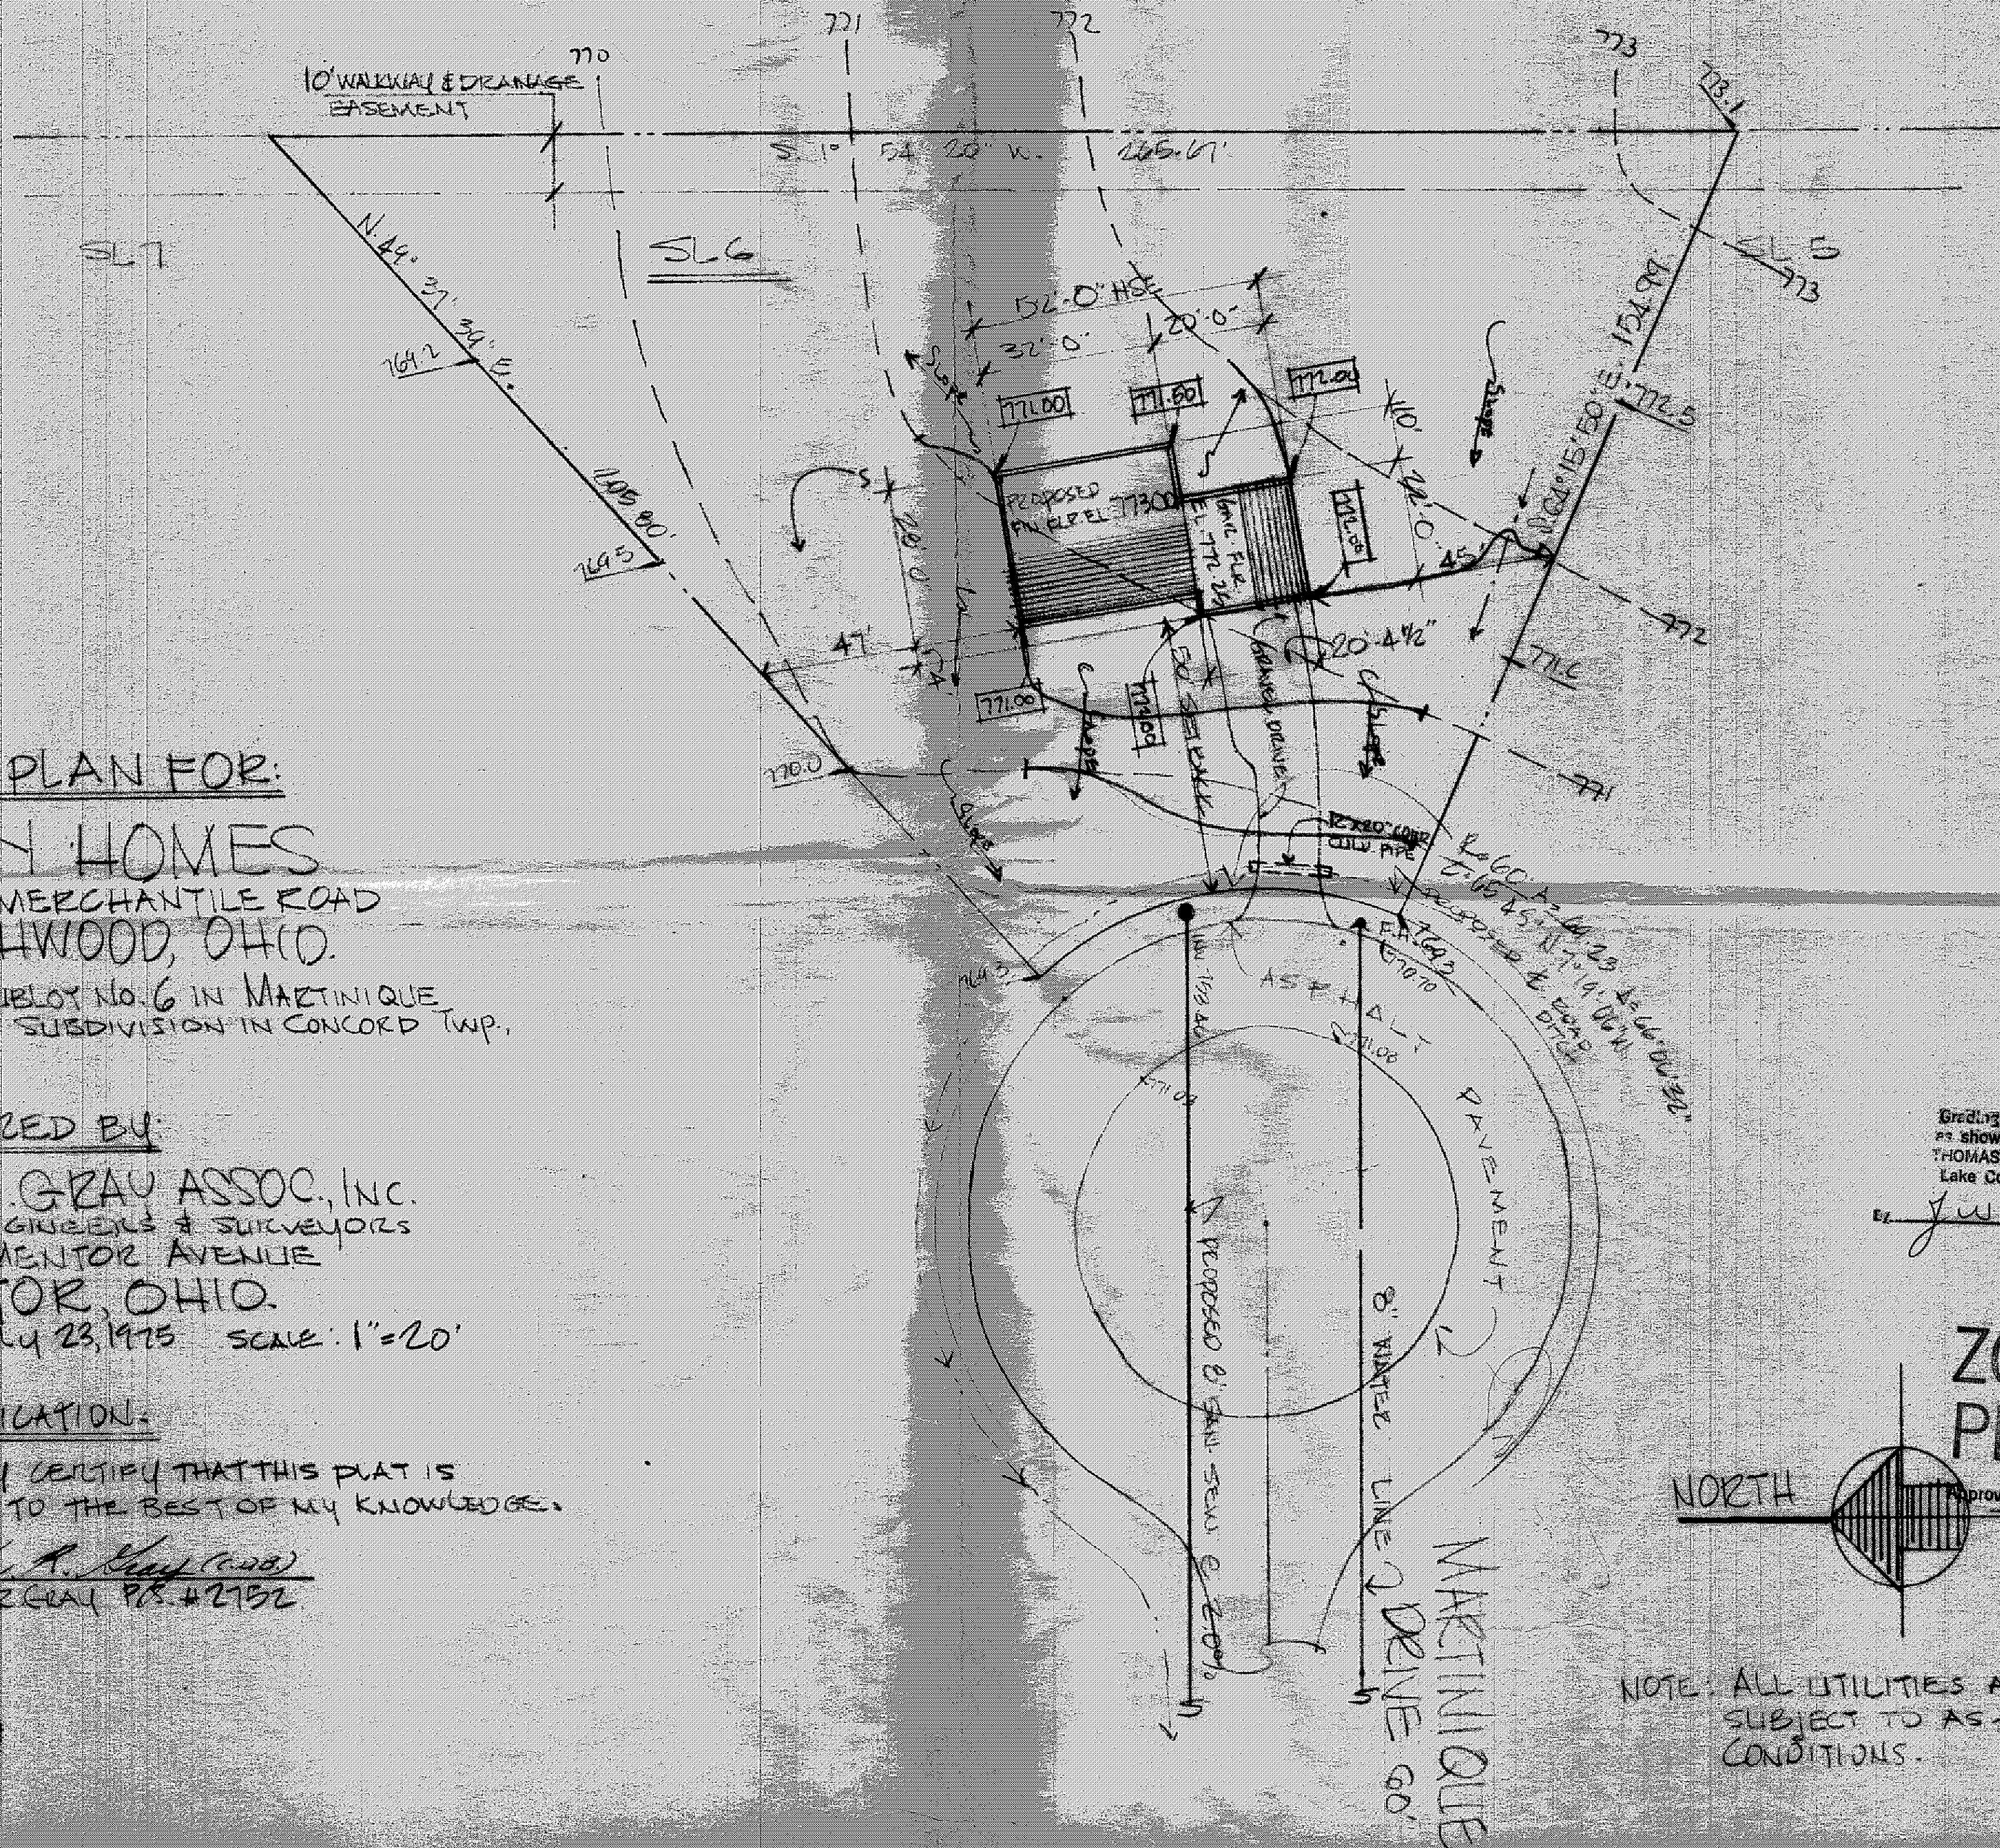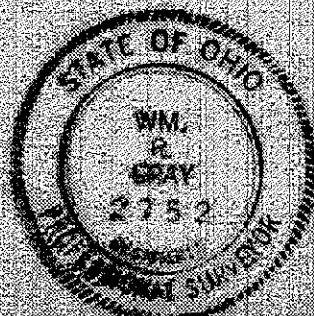


Grading Plan Approved
as shown and/or noted
THOMAS P. GILLES, P.E.
Lake County Engineer

By: JWK Date: 7-23-75

**ZONING
PERMIT**

NORTH

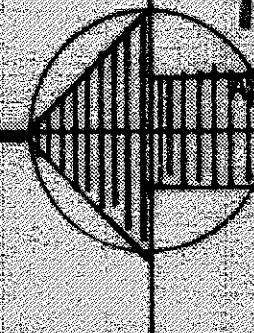

NOTE: ALL UTILITIES ARE
SUBJECT TO AS-BUILT
CONDITIONS.