
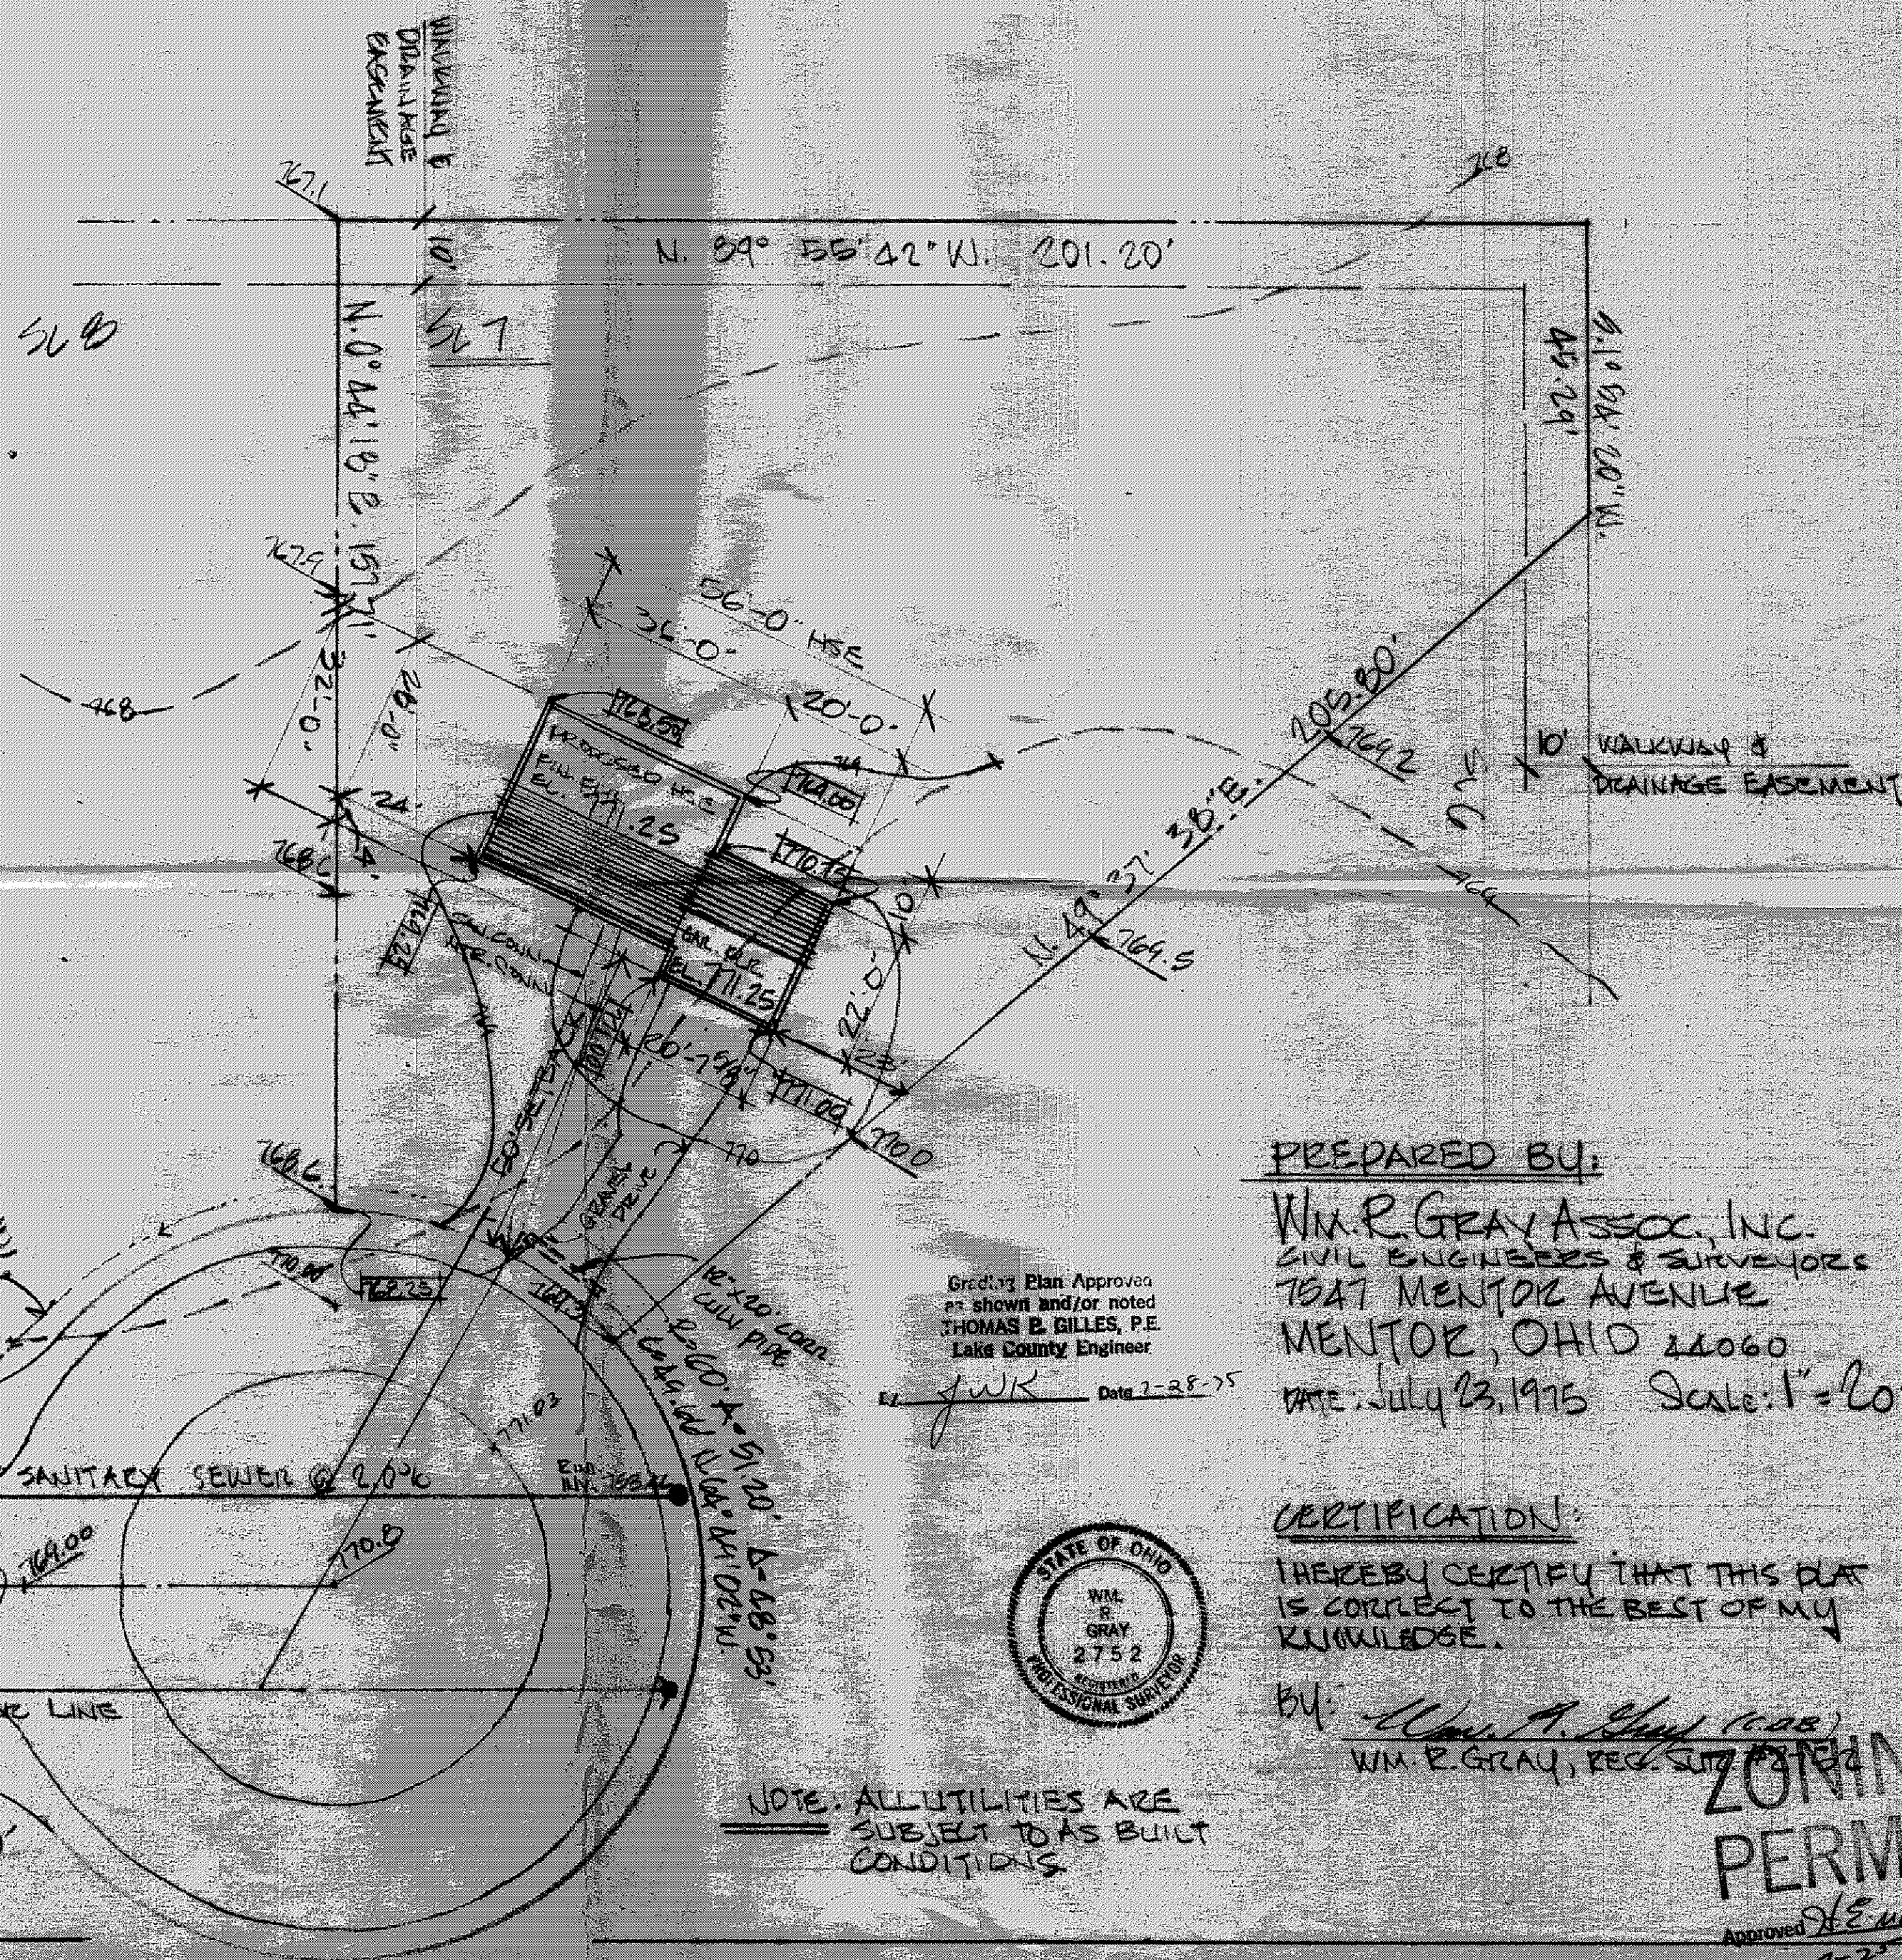


SITE PLAN FOR:

RYAN HOMES

23600 MERCHANTS ROAD
BEACHWOOD, OHIO.

BEING SUBLT NO. 7 IN MARTINIQUE
SUBDIVISION IN CONCORD TWP, OHIO.

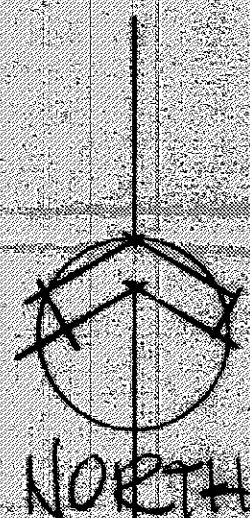


PREPARED BY:

WM. R. GRAY ASSOC., INC.
CIVIL ENGINEERS & SURVEYORS
7547 MENTOR AVENUE
MENTOR, OHIO 44060
DATE: July 23, 1975 Scale: 1"=20'

Grading Plan Approved
as shown and/or noted
THOMAS E. GILLES, P.E.
Lake County Engineer

JWK Date 7-28-75

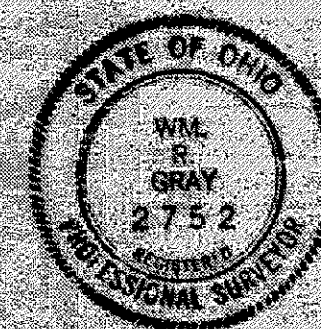

CERTIFICATION:

THEREBY CERTIFY THAT THIS PLAN
IS CORRECT TO THE BEST OF MY
KNOWLEDGE.

BY: Wm. R. Gray (C.E.)
WM. R. GRAY, REG. SURV. & C.E.

**ZONING
PERMIT**

Approved W.E. Munn
7-23-75