


5/ 95

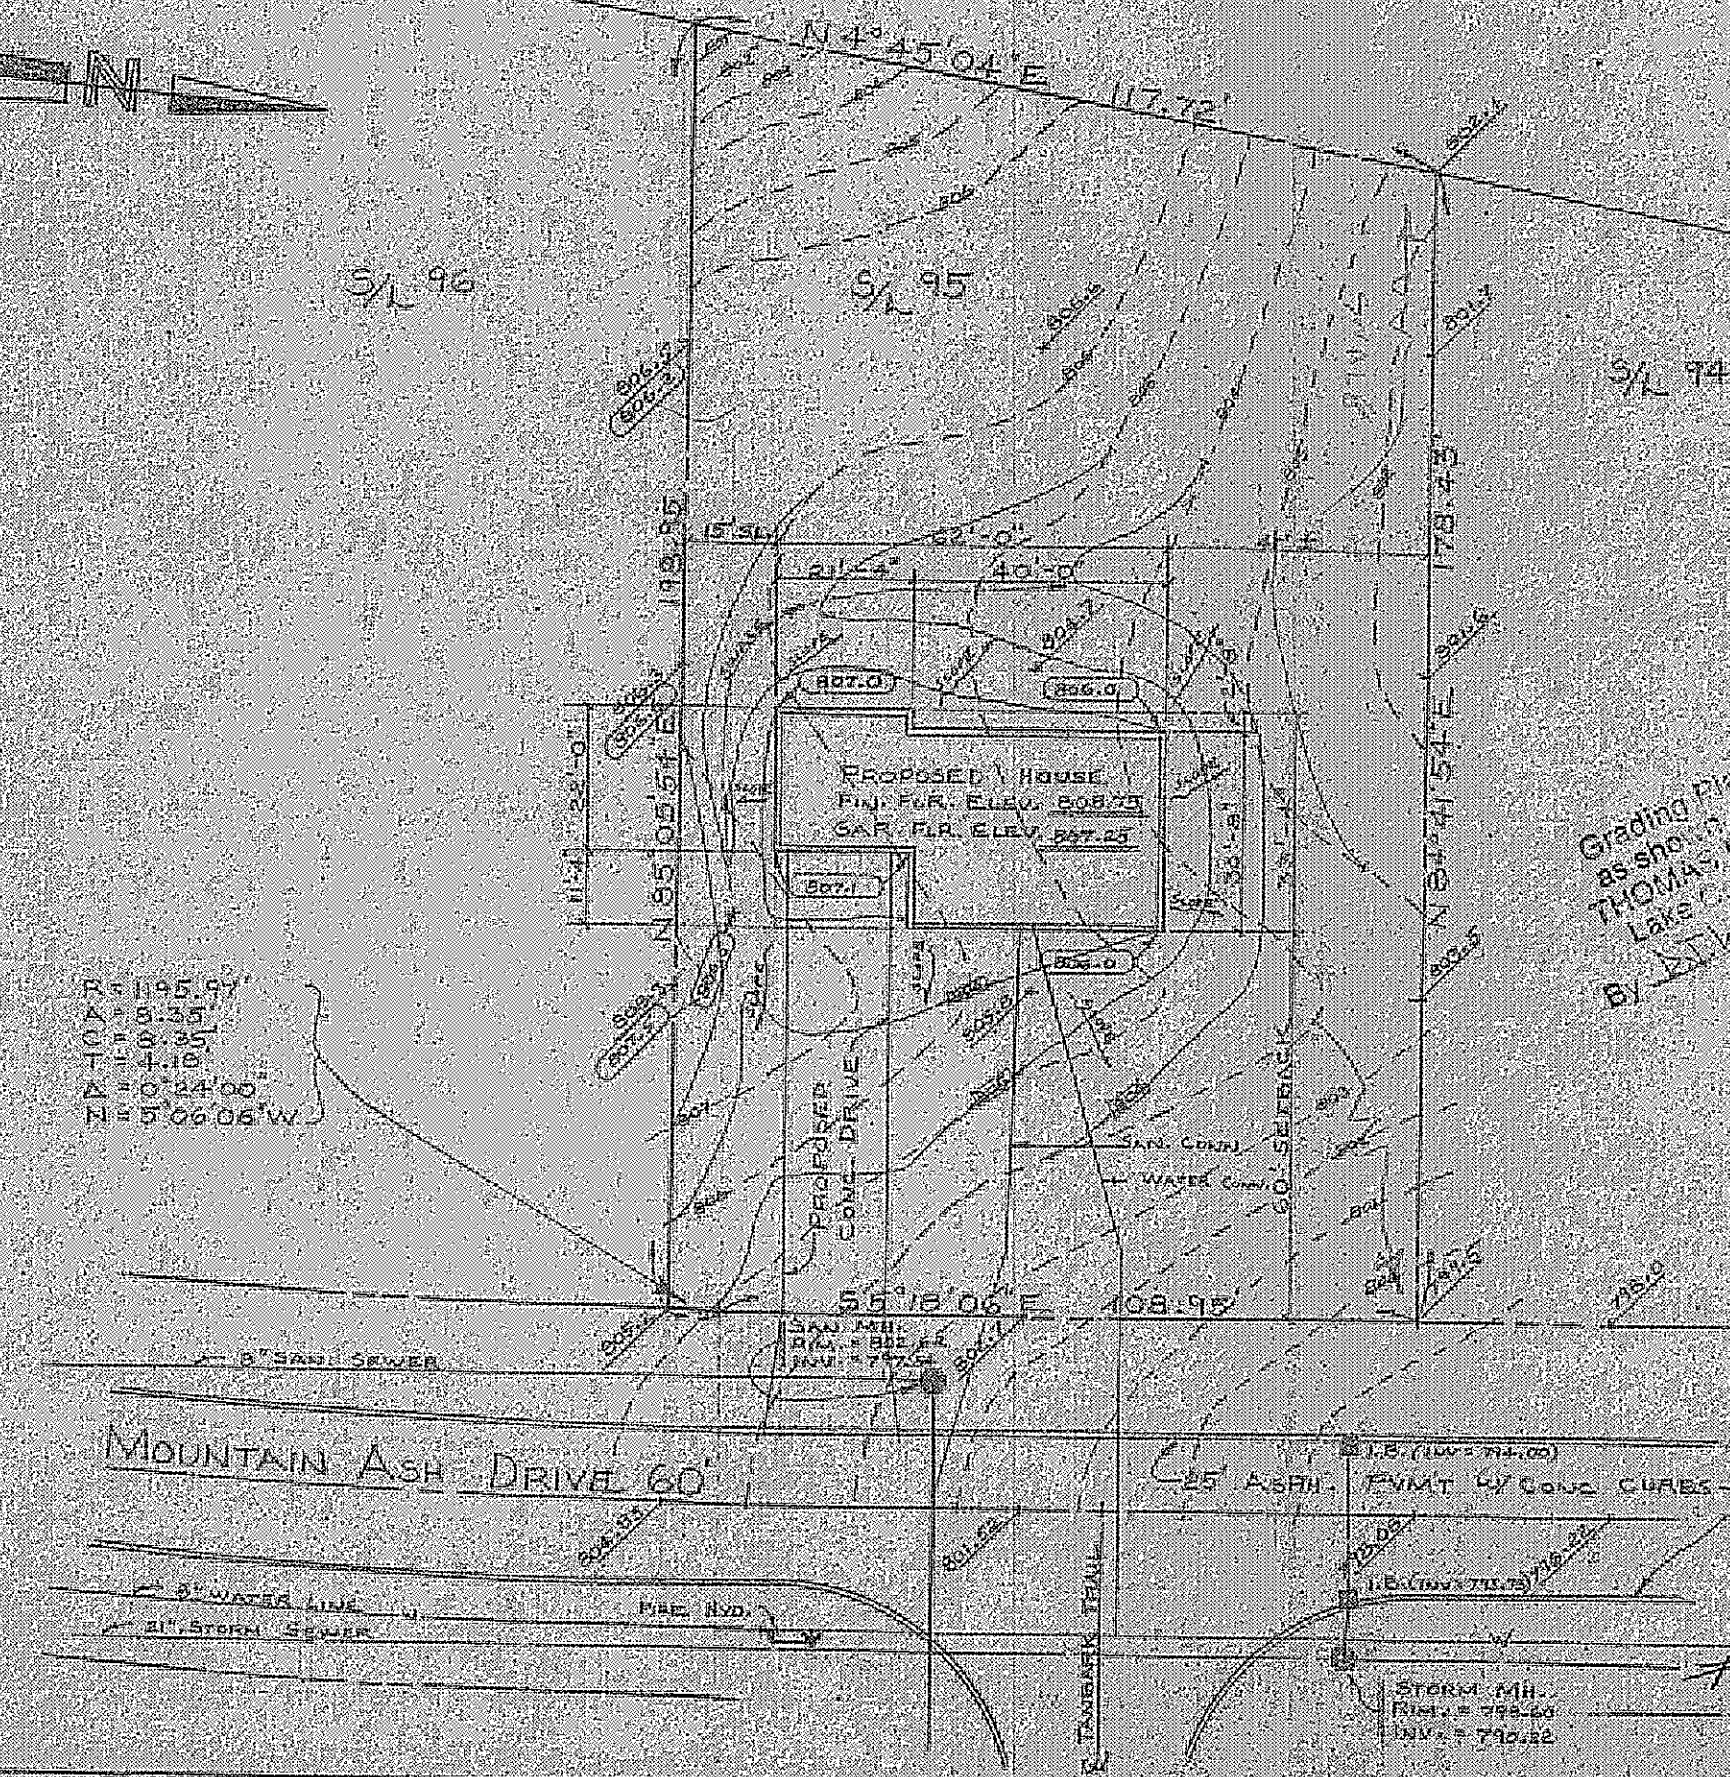

R = 195.94'
Δ = 8.35'
C = 8.35'
T = 4.18'
Δ = 0° 24' 00"
N = 5° 06' 06" W

SITE PLAN FOR:

SHANDLE CONSTRUCTION
8353 MENTOR AVENUE
MENTOR, OHIO
BEING SUBLOT NUMBER
95 IN THE MORLEY HILLS
ESTATES SUBDIVISION No. 3
IN CONCORD TOWNSHIP, LAKE
COUNTY, OHIO

PREPARED BY:

WM. R. GRAY ASSOC. INC.
7547 MENTOR AVENUE
MENTOR, OHIO

Grading Plan Approved
as shown and/or noted
THOMAS P. GILES, P.E.
LAKE COUNTY ENGINEER
BY: [Signature]

SCALE: 1" = 30'
DATE: APRIL 29, 1977

CERTIFICATION:

I HEREBY CERTIFY THAT
THIS PLAT IS CORRECT TO
THE BEST OF MY KNOWLEDGE
BY:

WM. R. GRAY REG. SURV. #2752

ZONING PERMIT

Approved 5-4-77

[Signature]

